


THE METROPOLITAN DISTRICT GEODETIC AND TOPOGRAPHICAL SURVEY

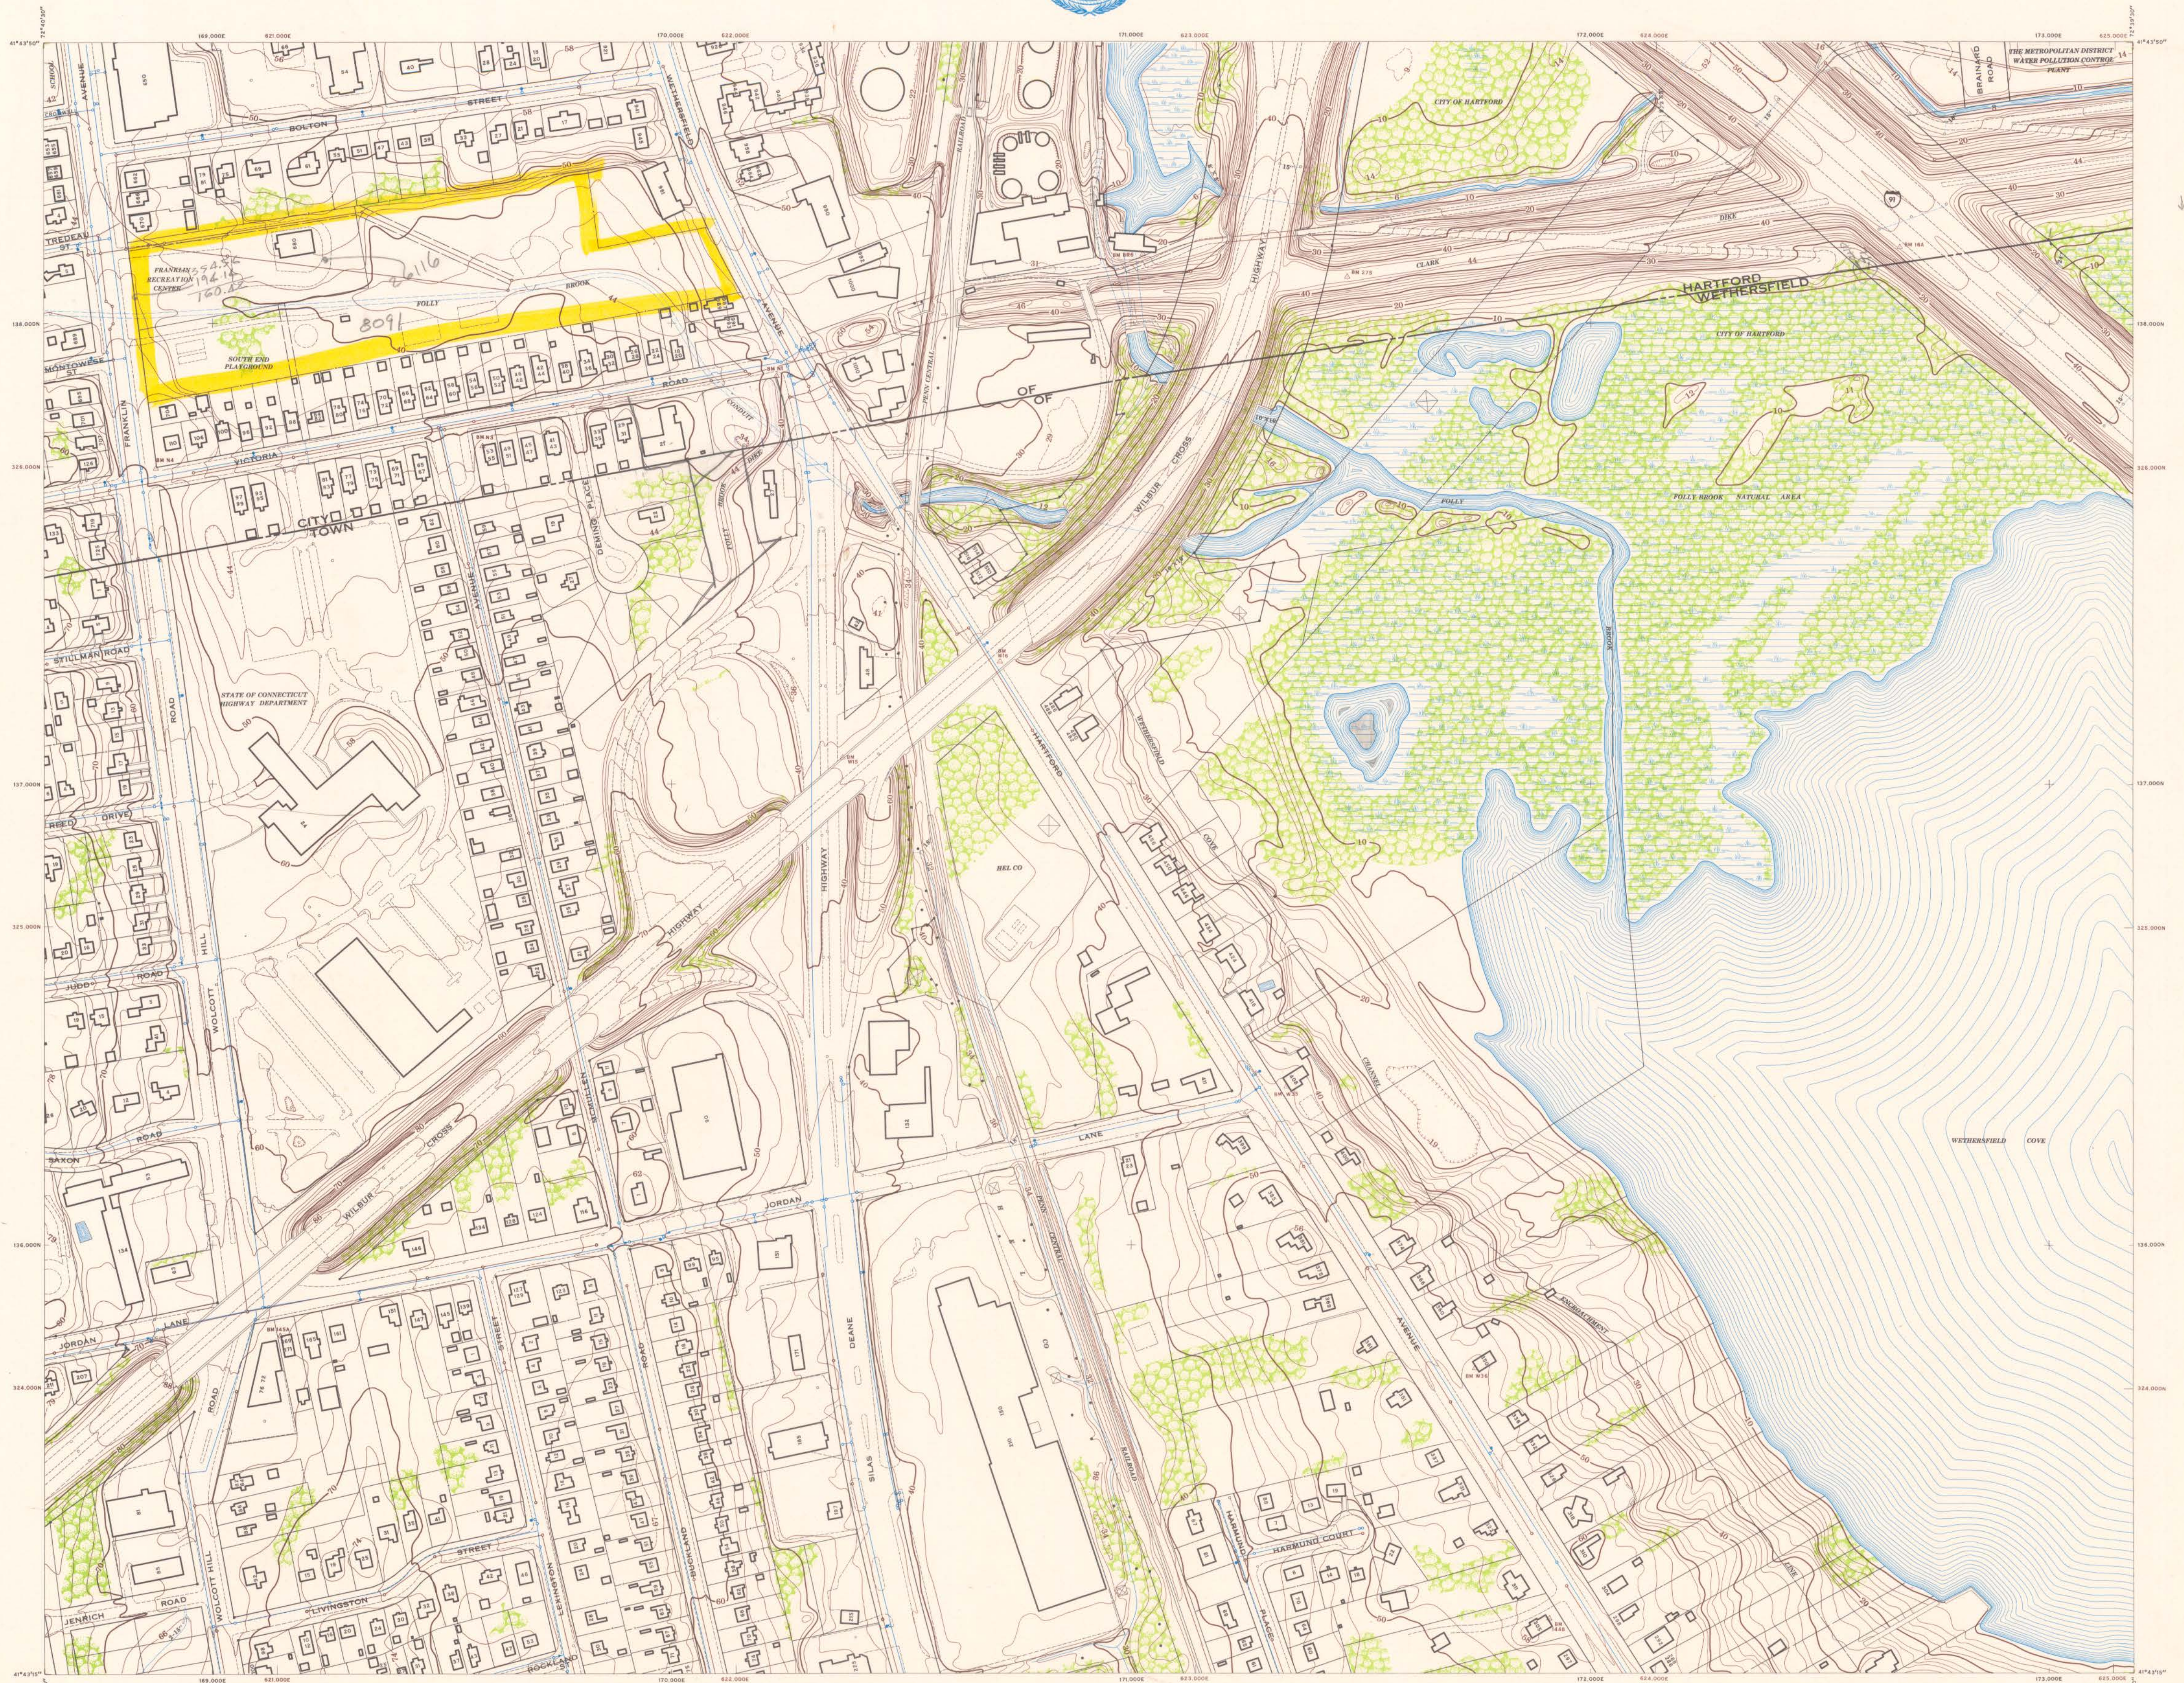

TOPOGRAPHY BY PHOTOGRAMMETRIC METHODS
FROM AERIAL PHOTOGRAPHS TAKEN
FEBRUARY, 1974

- LEGEND-**
- SANITARY SEWER
 - STORM SEWER
 - CATCH BASIN
 - WATER MAIN
 - HYDRANT
 - VERTICAL CONTROL POINT
 - HOUSE NUMBER

SCALE 1:2400

CONTOUR INTERVAL 2 FEET
METROPOLITAN DISTRICT DATUM
1000-FOOT GRID BASED ON THE
METROPOLITAN DISTRICT PLANE RECTANGULAR COORDINATE SYSTEM
CONNECTICUT COORDINATE GRID SHOWN IN BROWN
THIS MAP COMPLIES WITH THE NATIONAL STANDARD MAP ACCURACY REQUIREMENTS

SHEET 94	SHEET 99	SHEET 102
SHEET 95	SHEET 100	SHEET 103
SHEET 101	SHEET 104	SHEET 105

THE METROPOLITAN DISTRICT
COMMISSION ON REGIONAL PLANNING
HARTFORD COUNTY, CONNECTICUT