


103
204

ST.

SIGOURNEY

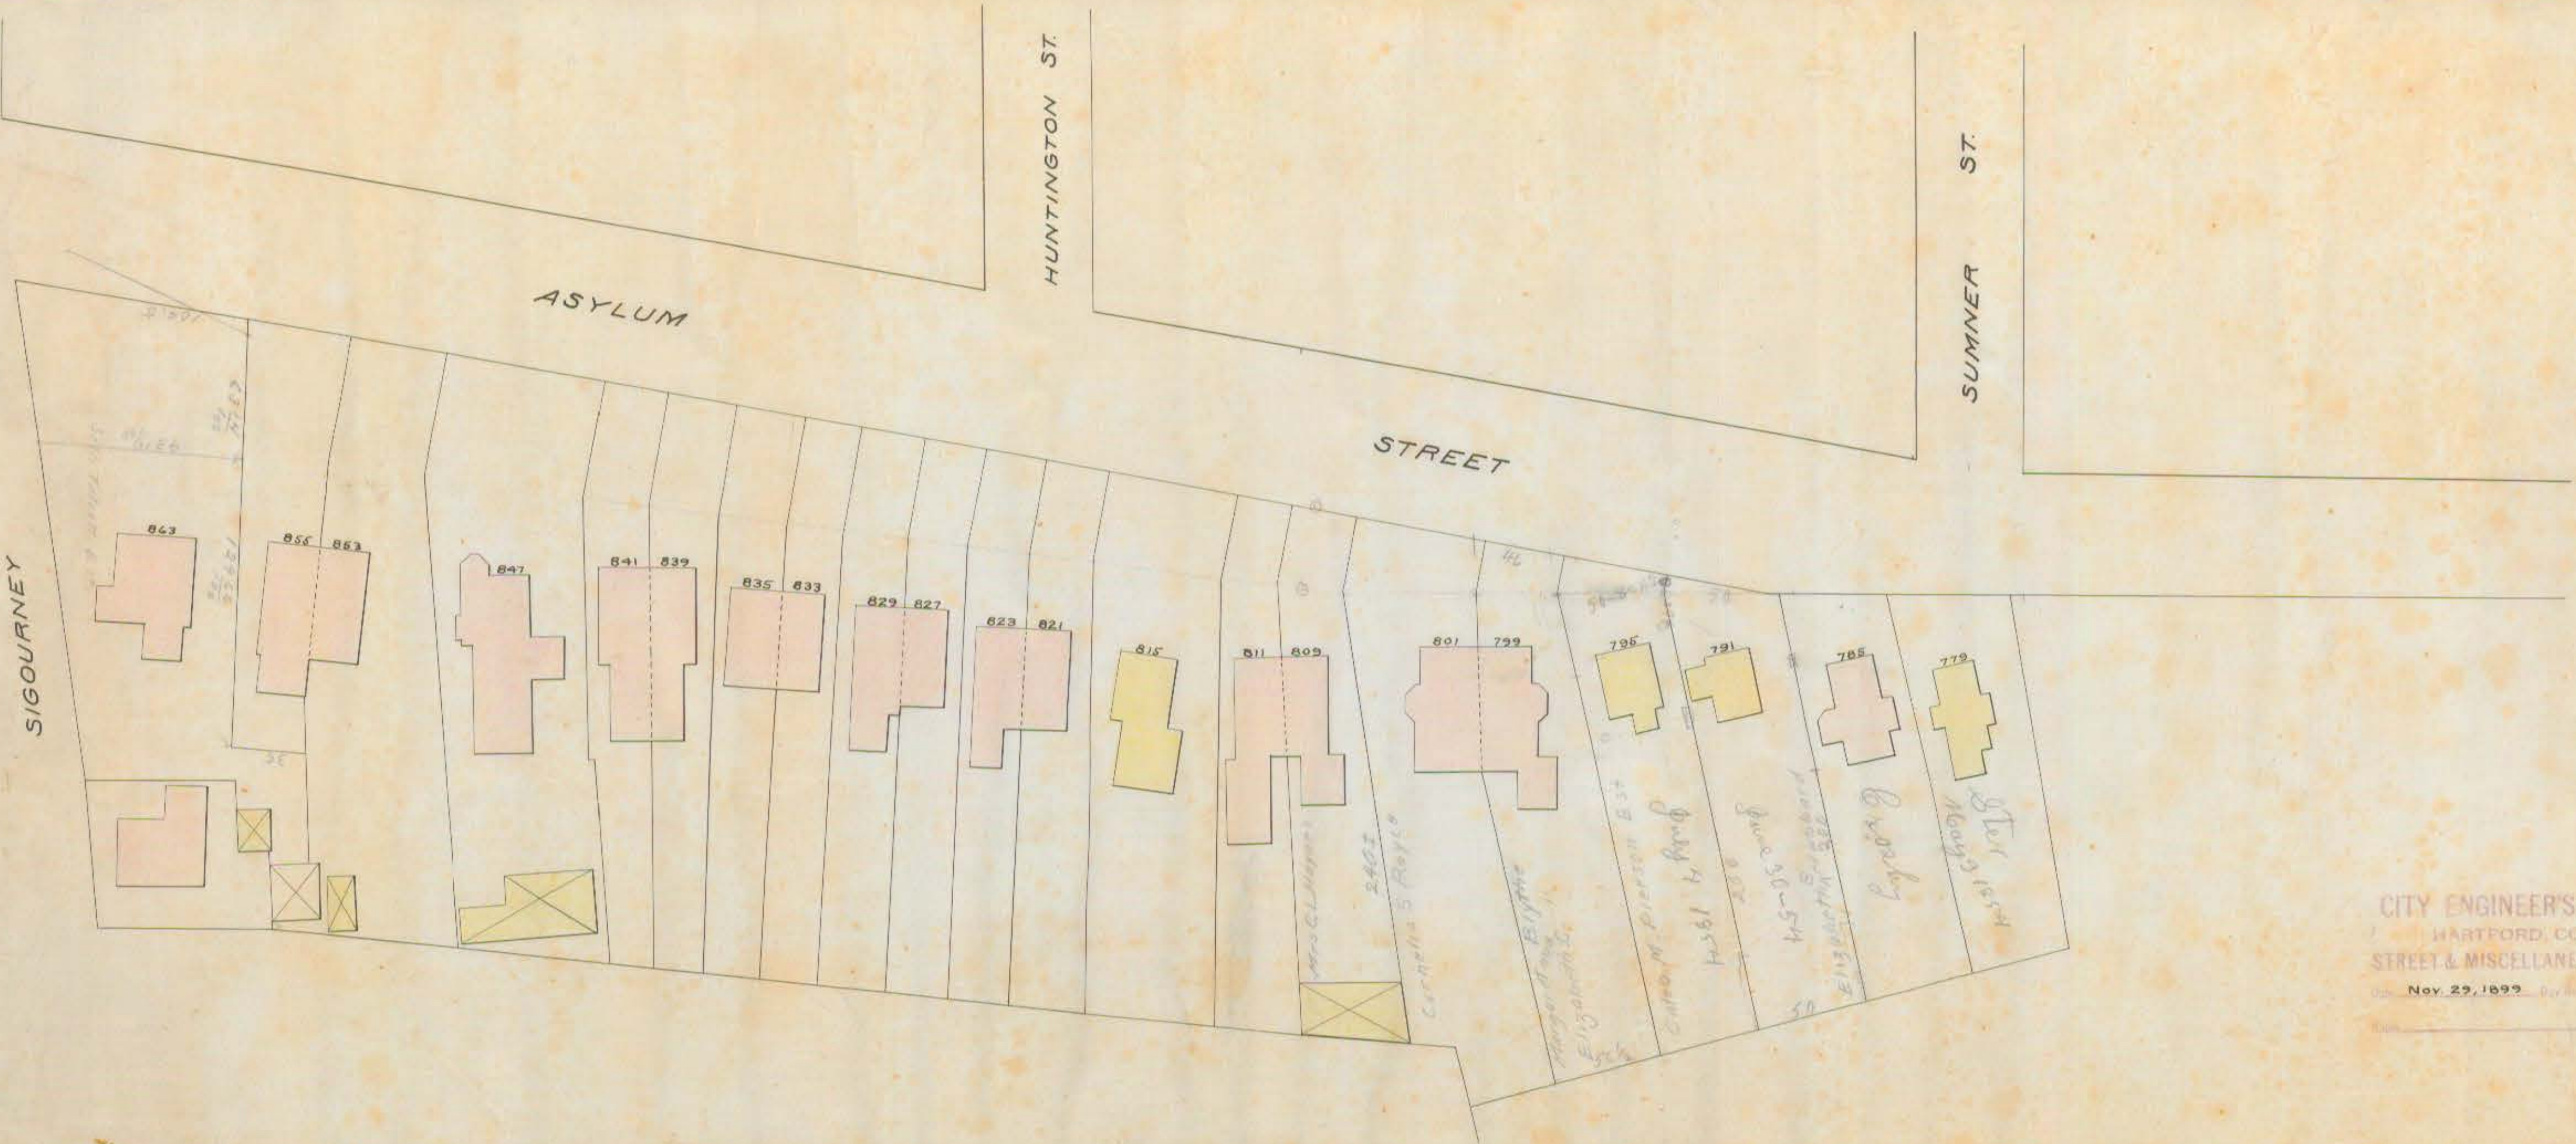

HUNTINGTON ST.

ST.

SUMNER

STREET

CITY ENGINEER'S OFFICE
HARTFORD, CONN.
STREET & MISCELLANEOUS DEPT.
Date Nov. 29, 1899 Day Book No. 0698