


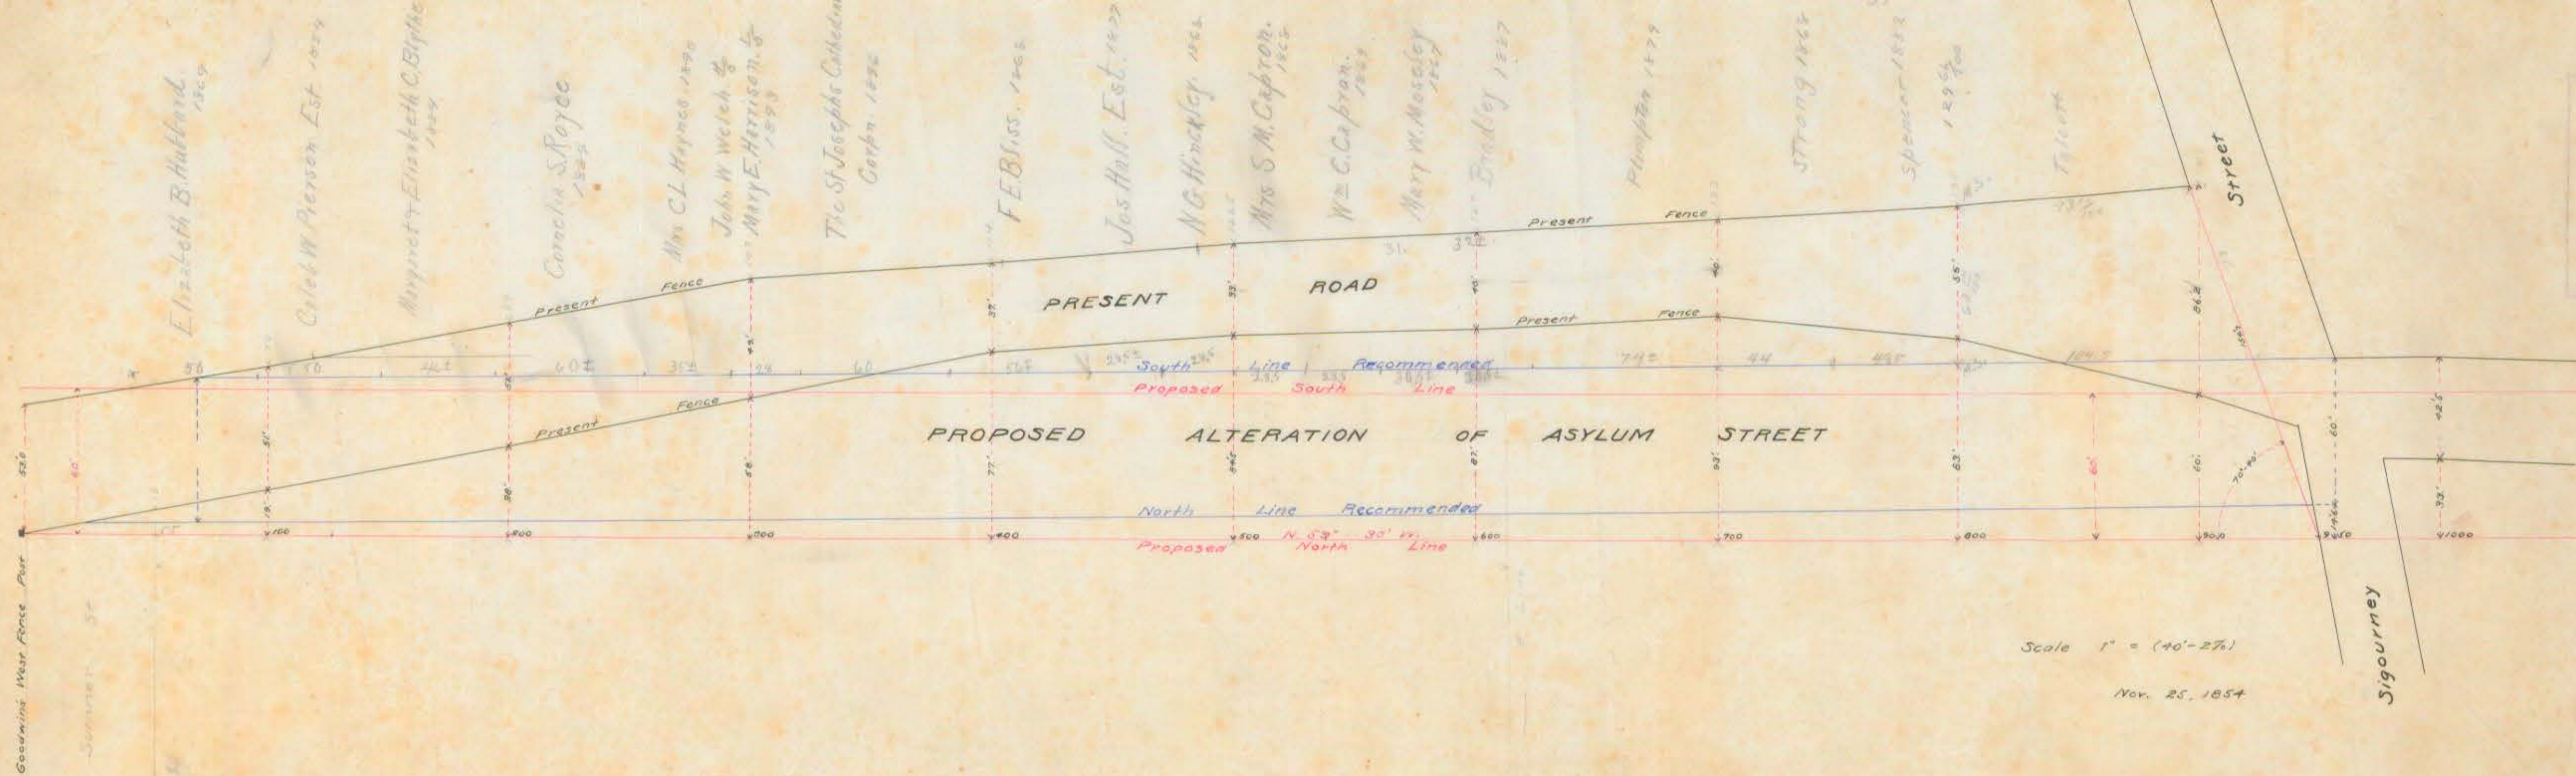

Scale 1" = (40'-2")

Nov. 25, 1854

