

③
73 Starwood St.
File # 12111
Alfred J. Boudria
Lettie C. " (or surv.)


See Sheet 186

GOSHEN
STREET


NEPAUG
STREET

See Sheet 112


Street, Building S T R E E T Lines of May 23, 1921 Vol. 6-326

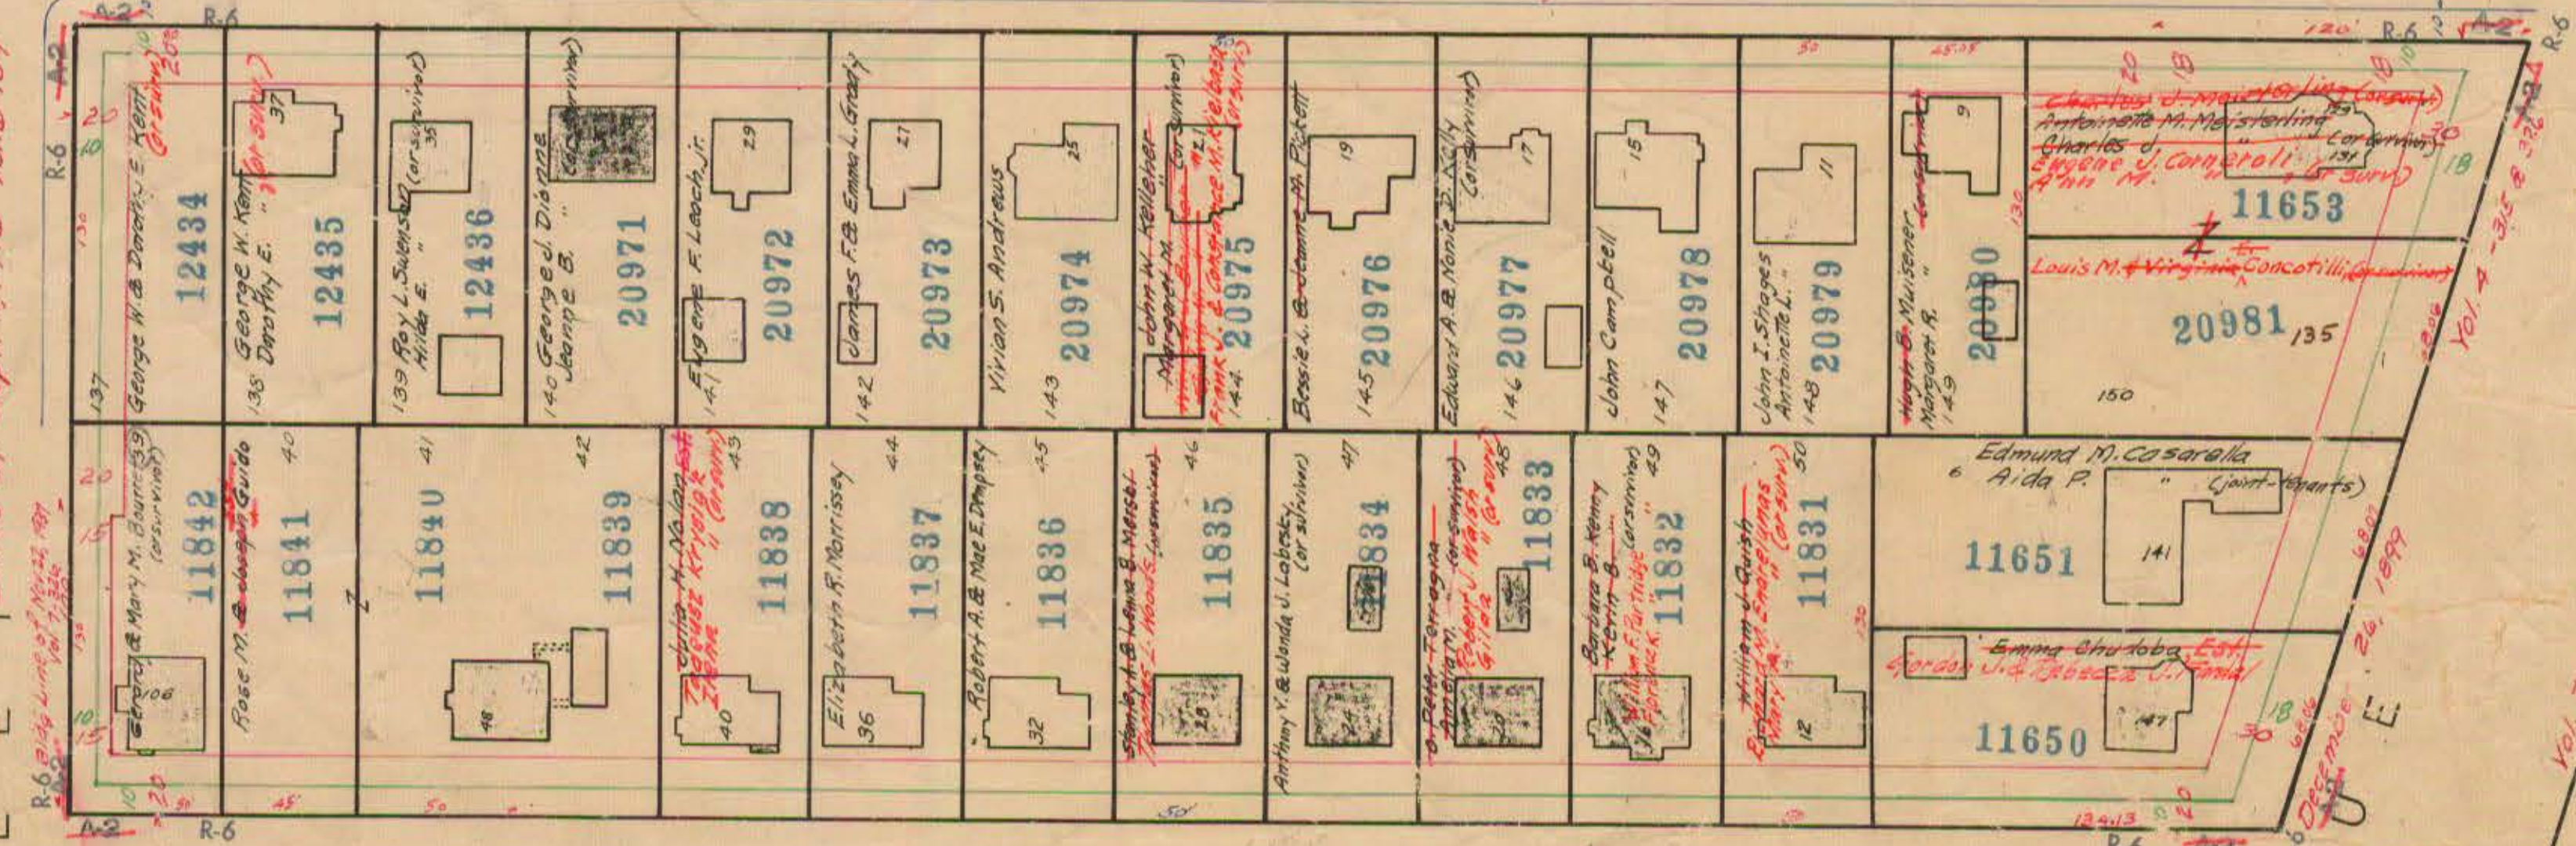

W I N D H A M S T R E E T

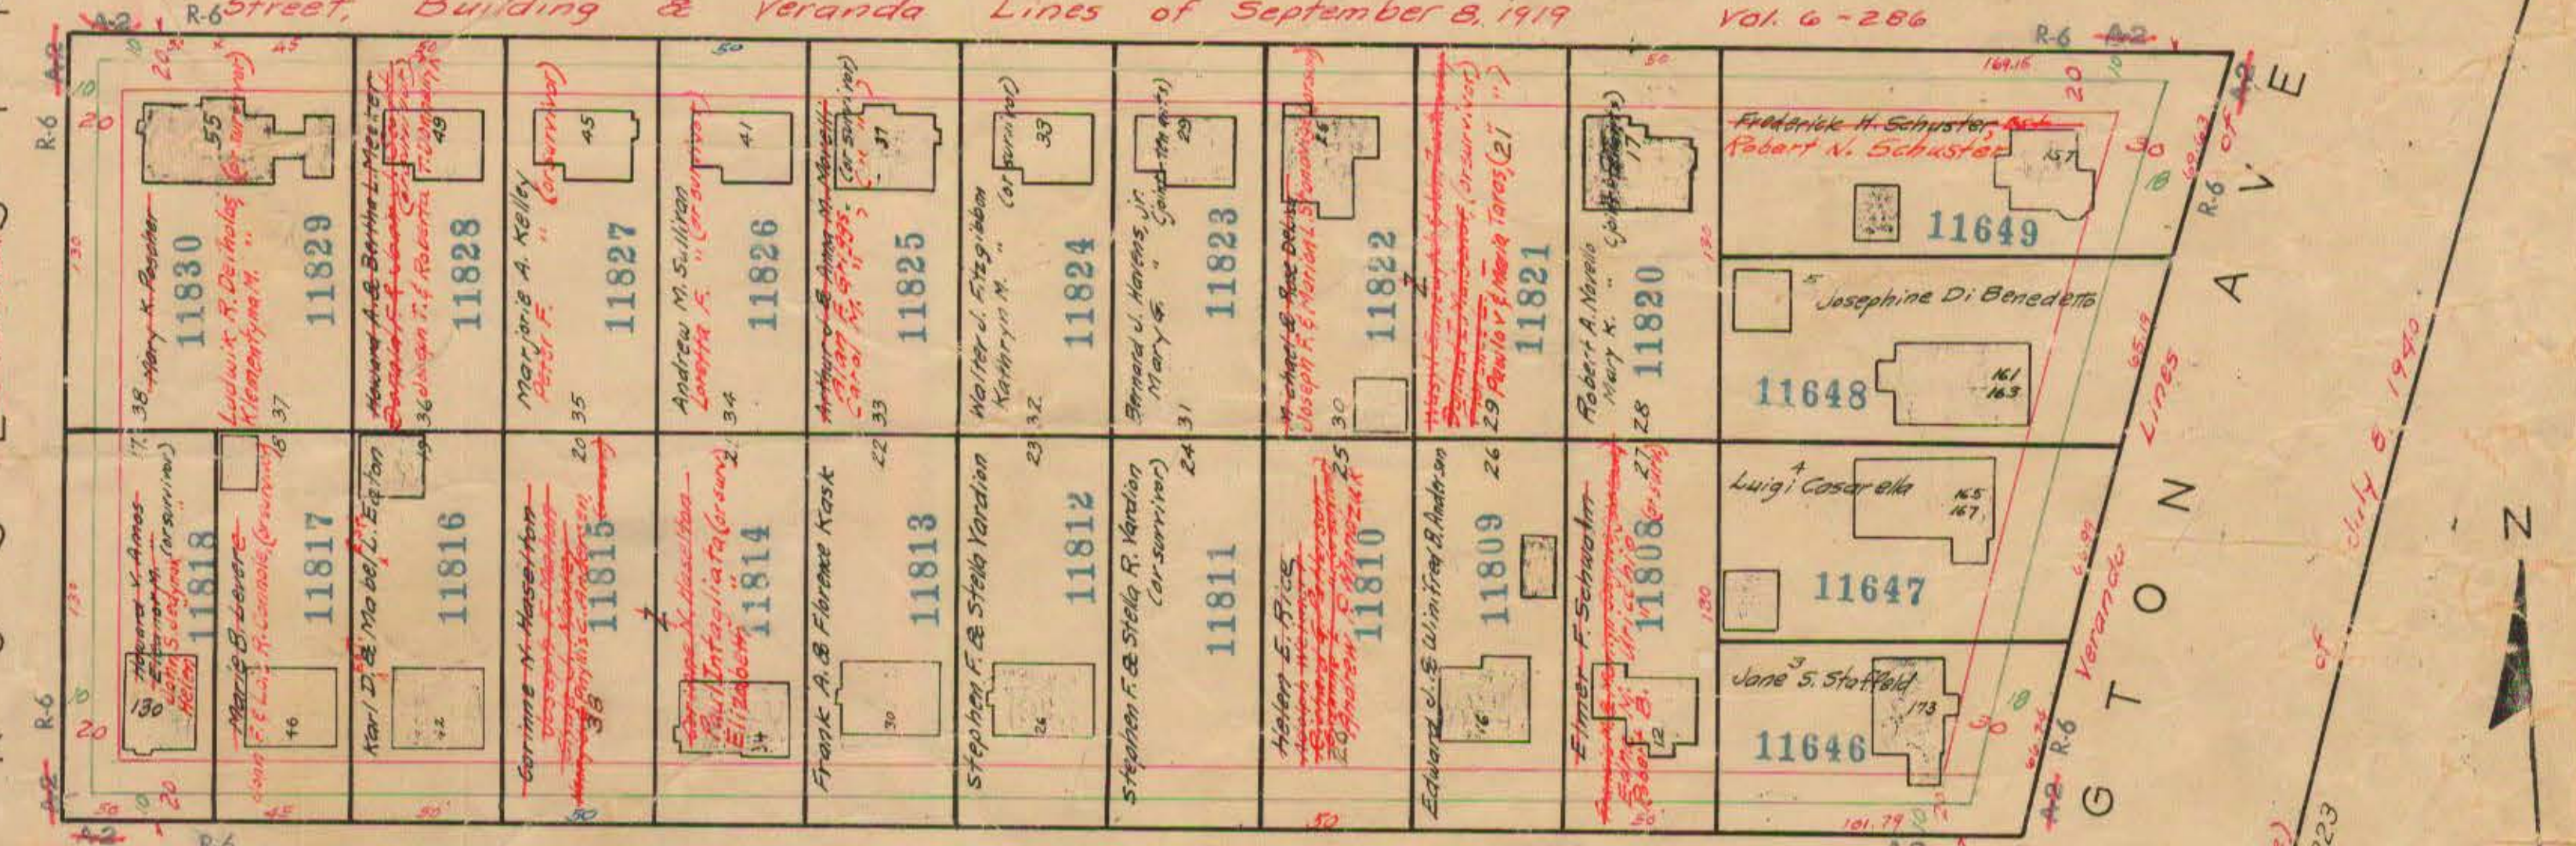

S P R A G U E S T R E E T
Building & Veranda Lines of September 8, 1919 Vol. 9-285

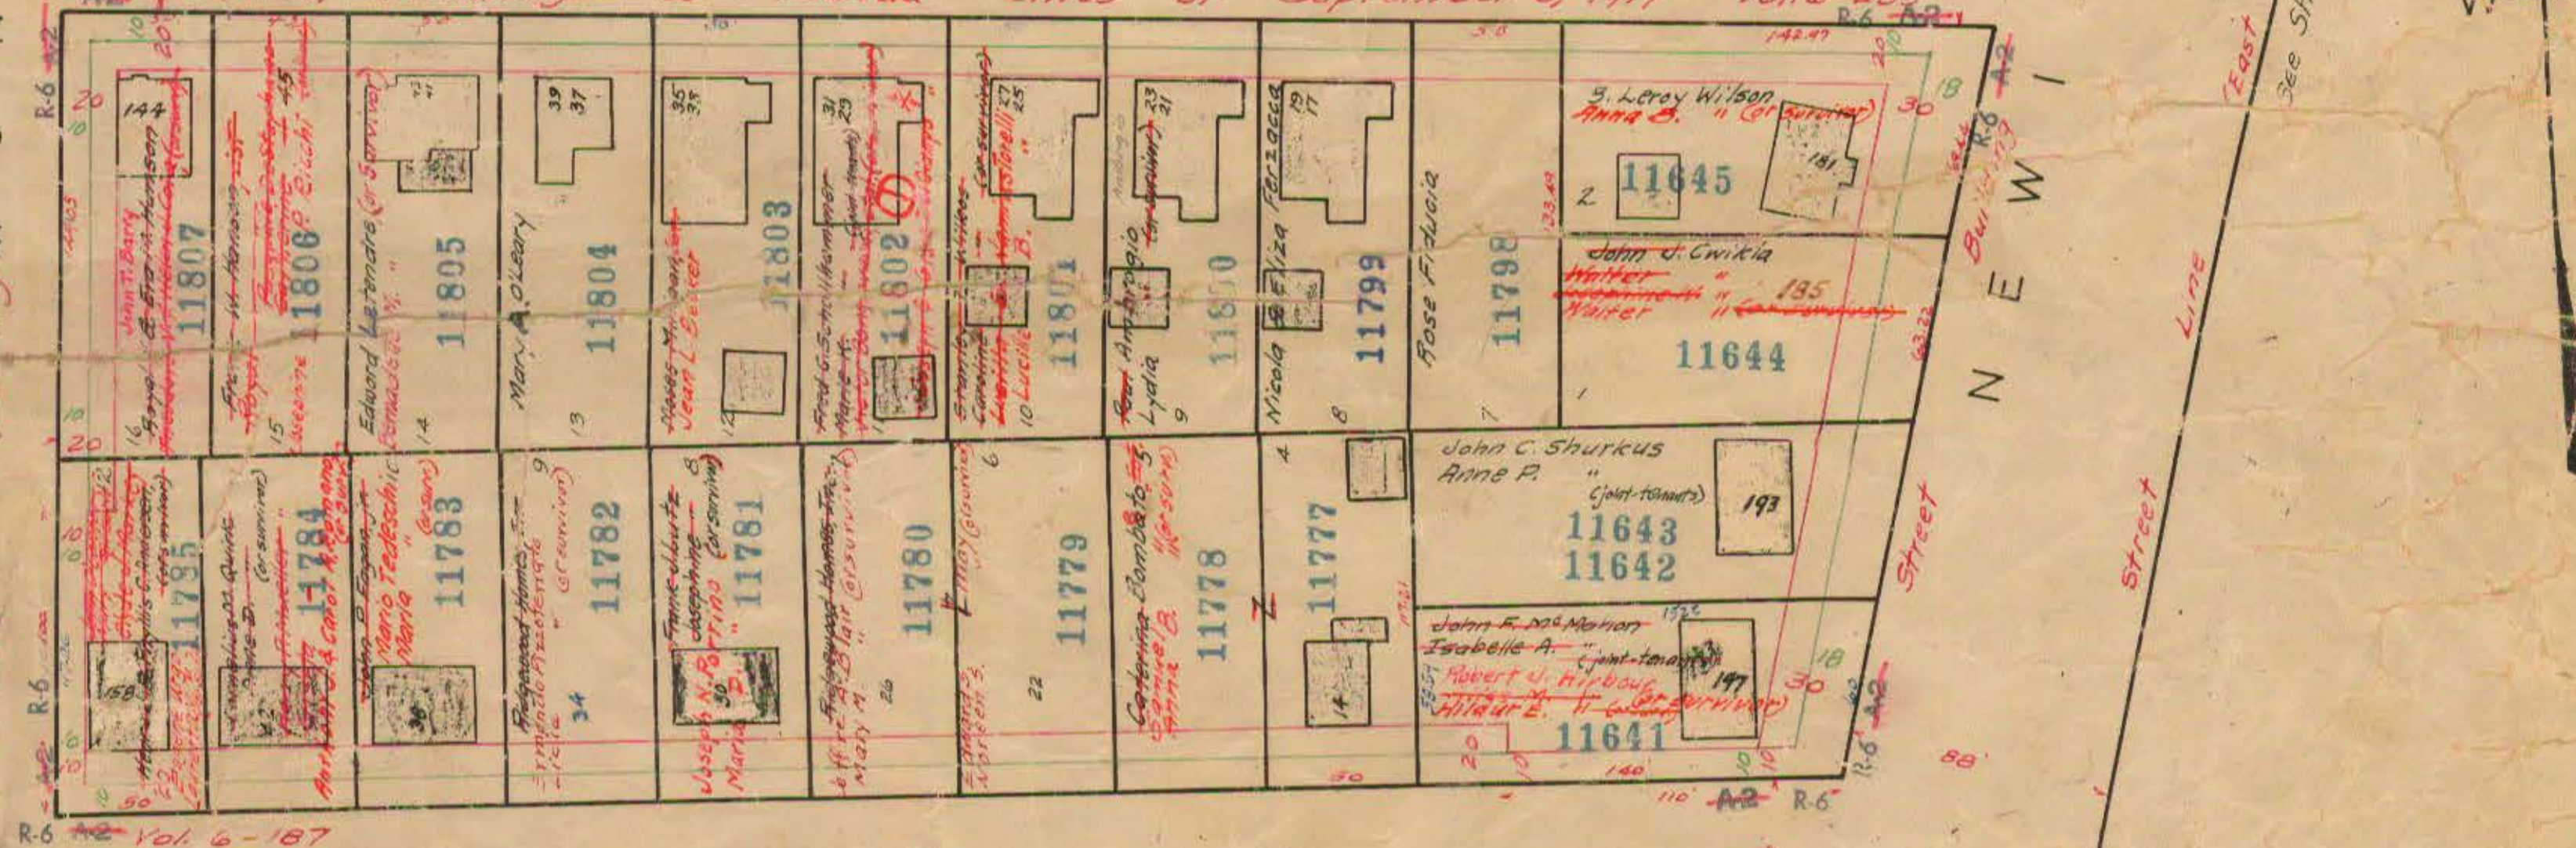

S T R E E T

See Sheet 188

20-71 Sprague St.
file # 1982
(1)
Zander W. Gorb
" " "
" " "
" " "

of Engineering

②
file # 12099
125 Roslyn St.
Rocco A. Nesta, Jr. (or survivor)
Mary A. "