


Out of Service, April 26-1939

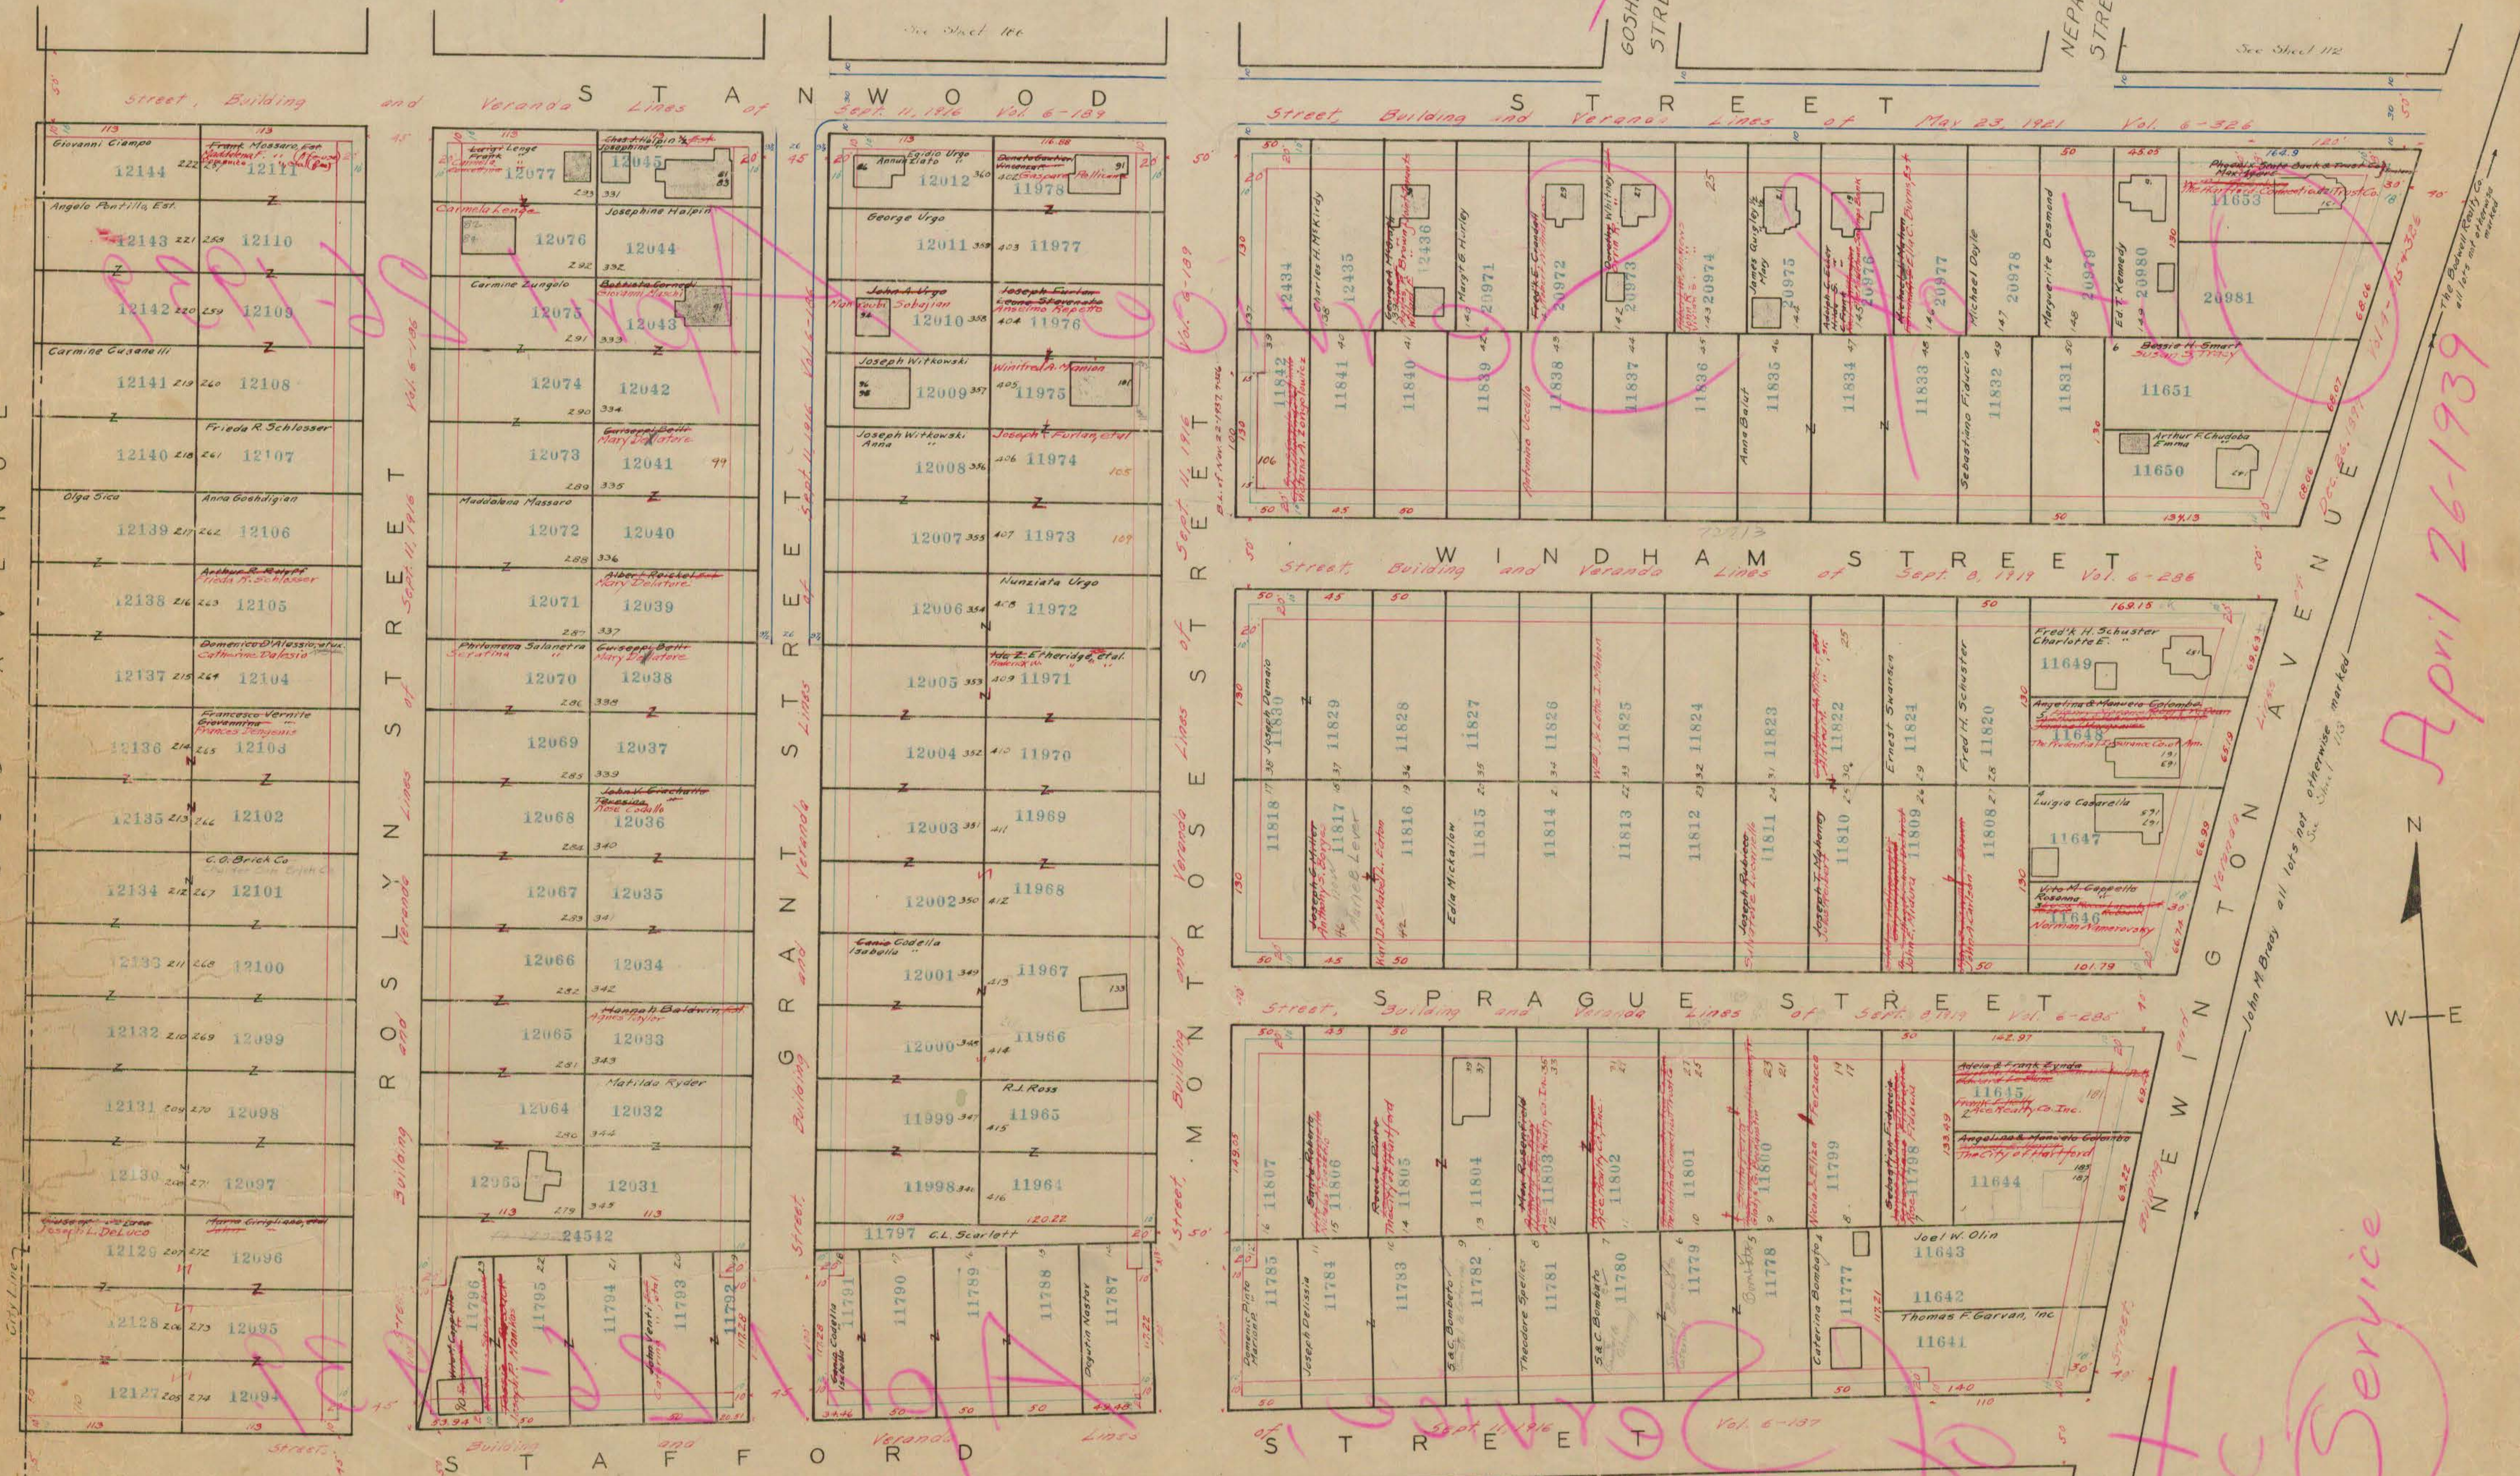

City of Hartford, Dept. of Engineering
April 1928

Area on this Sheet formerly
part of Sheet 112, 100 Scale

See Sheet 108.

Out of Service. April 26-1939

Out of Service, April 26-1939

Out of Service

April 26-1939