



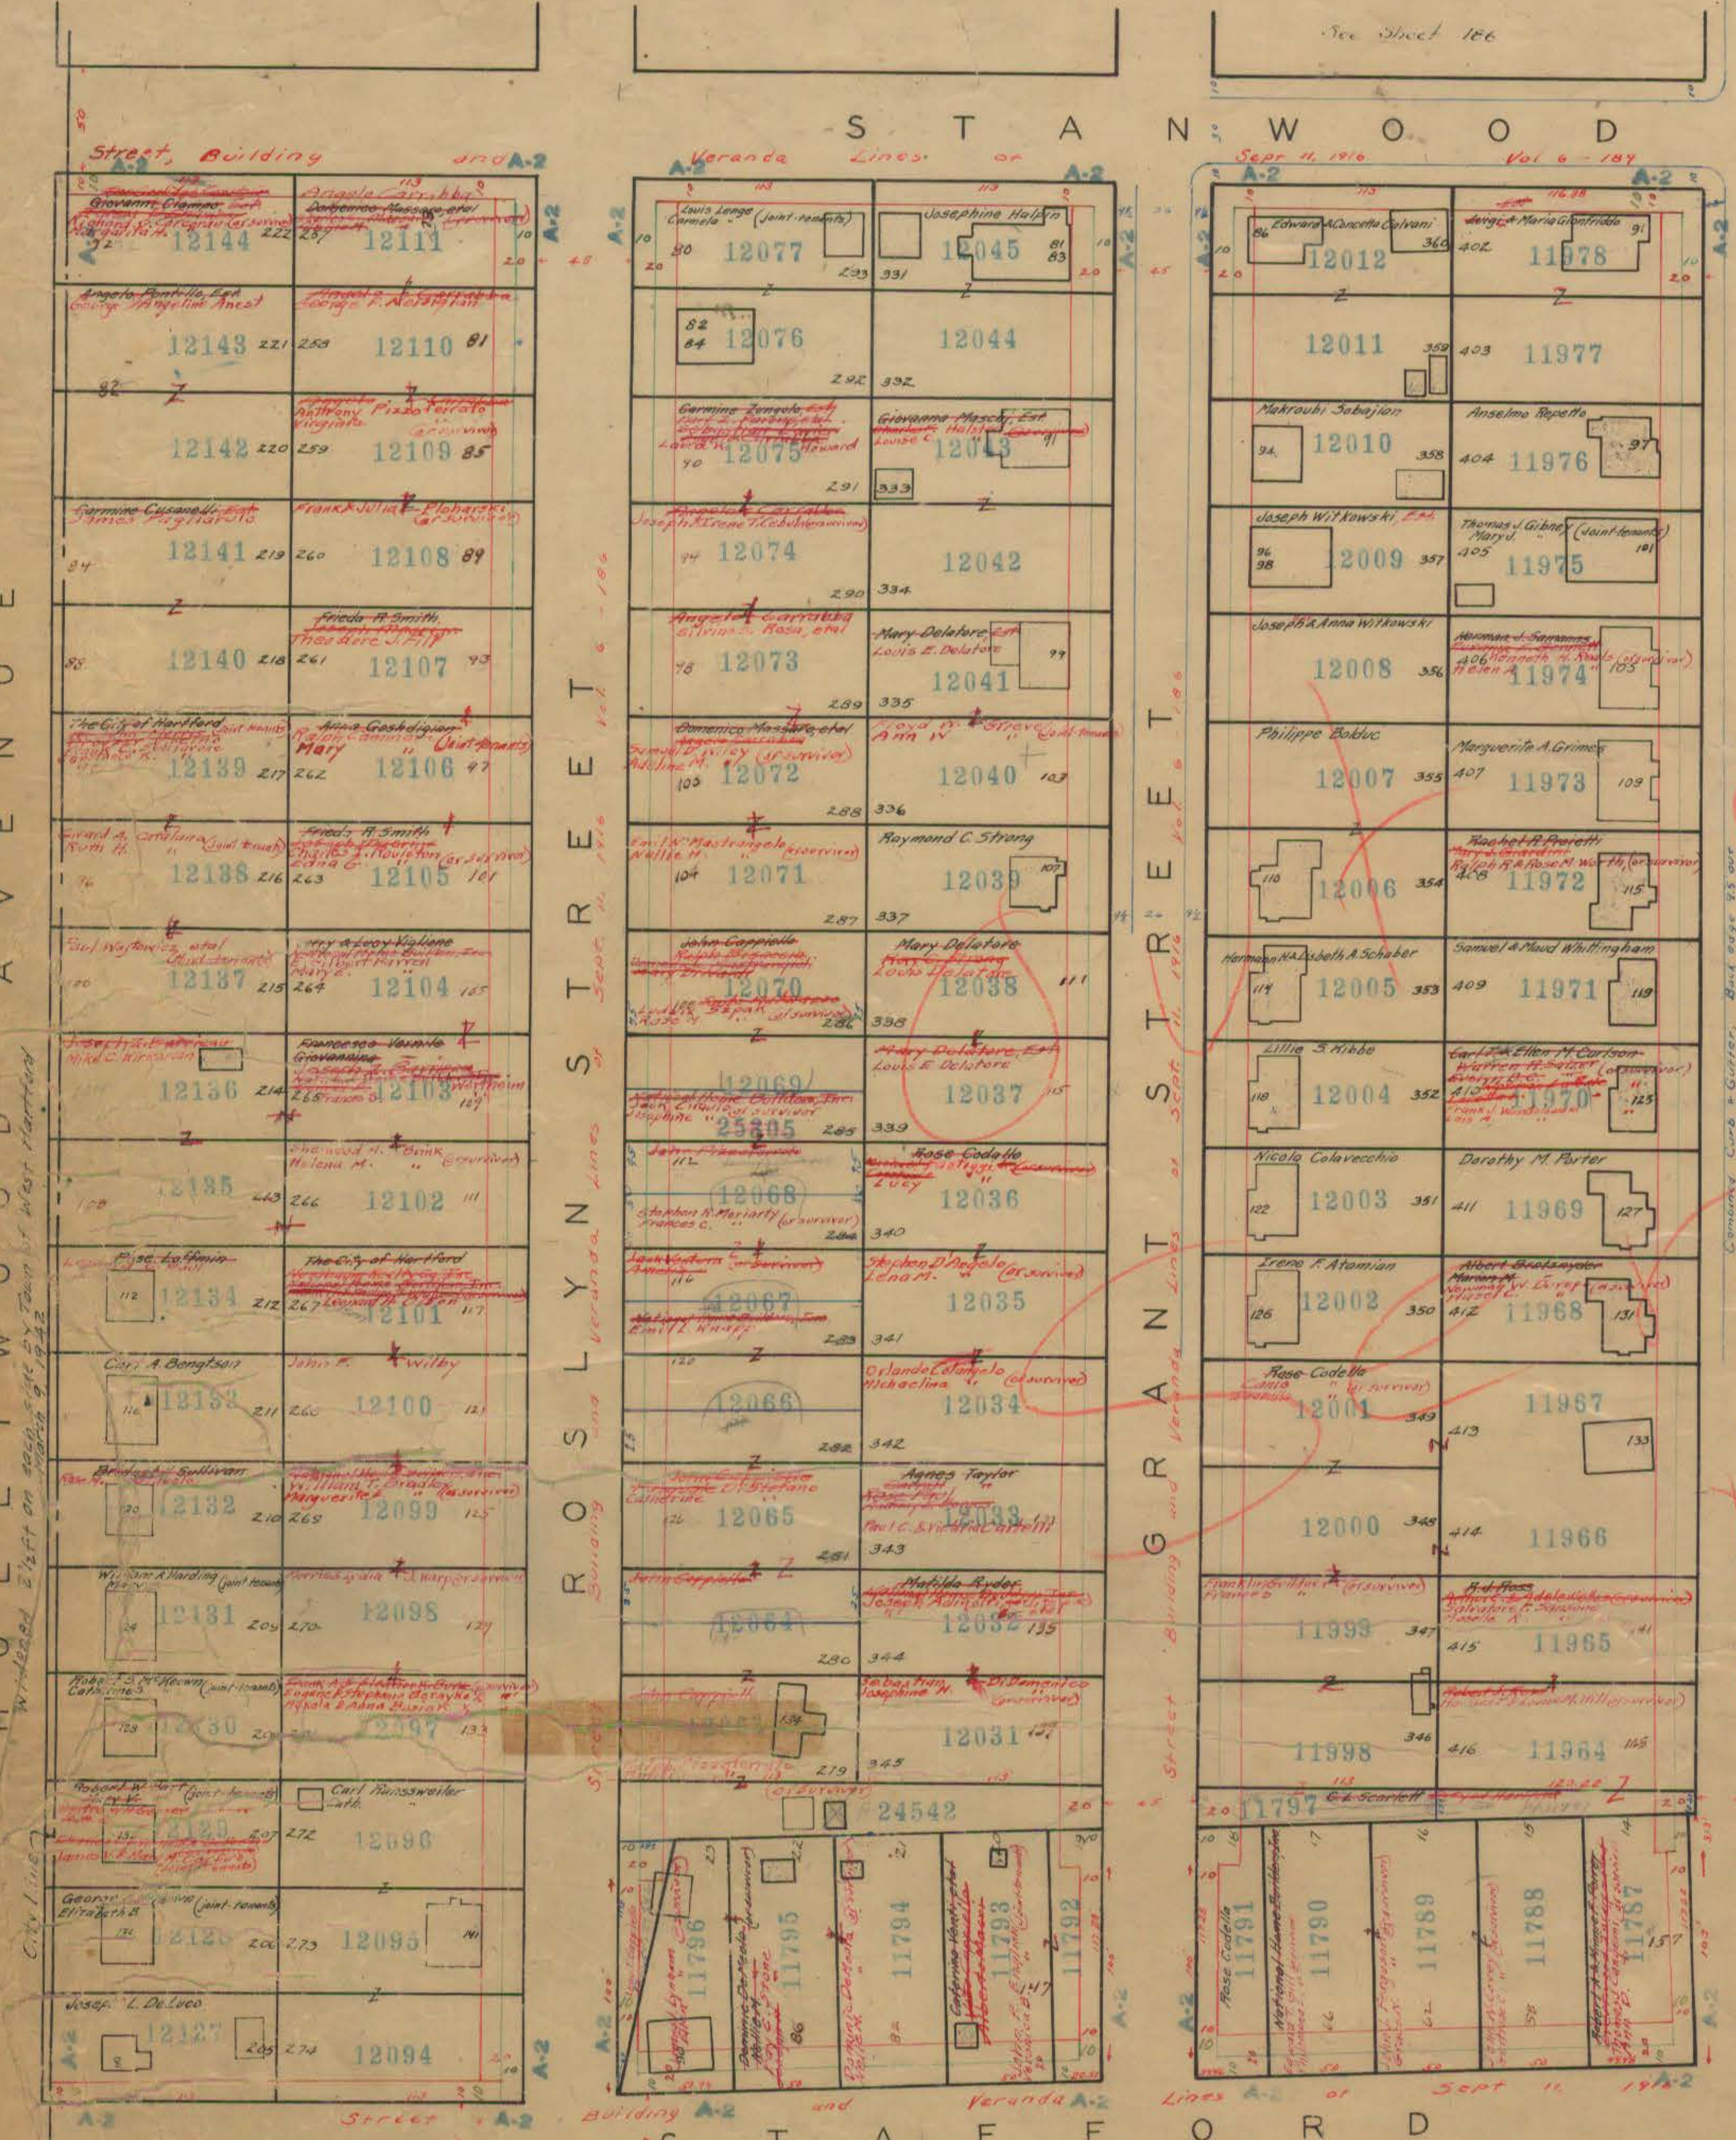

City of Hartford, Dept of Engineering
April 1928

See Sheet 188

(East side)
See Sheet 229

