
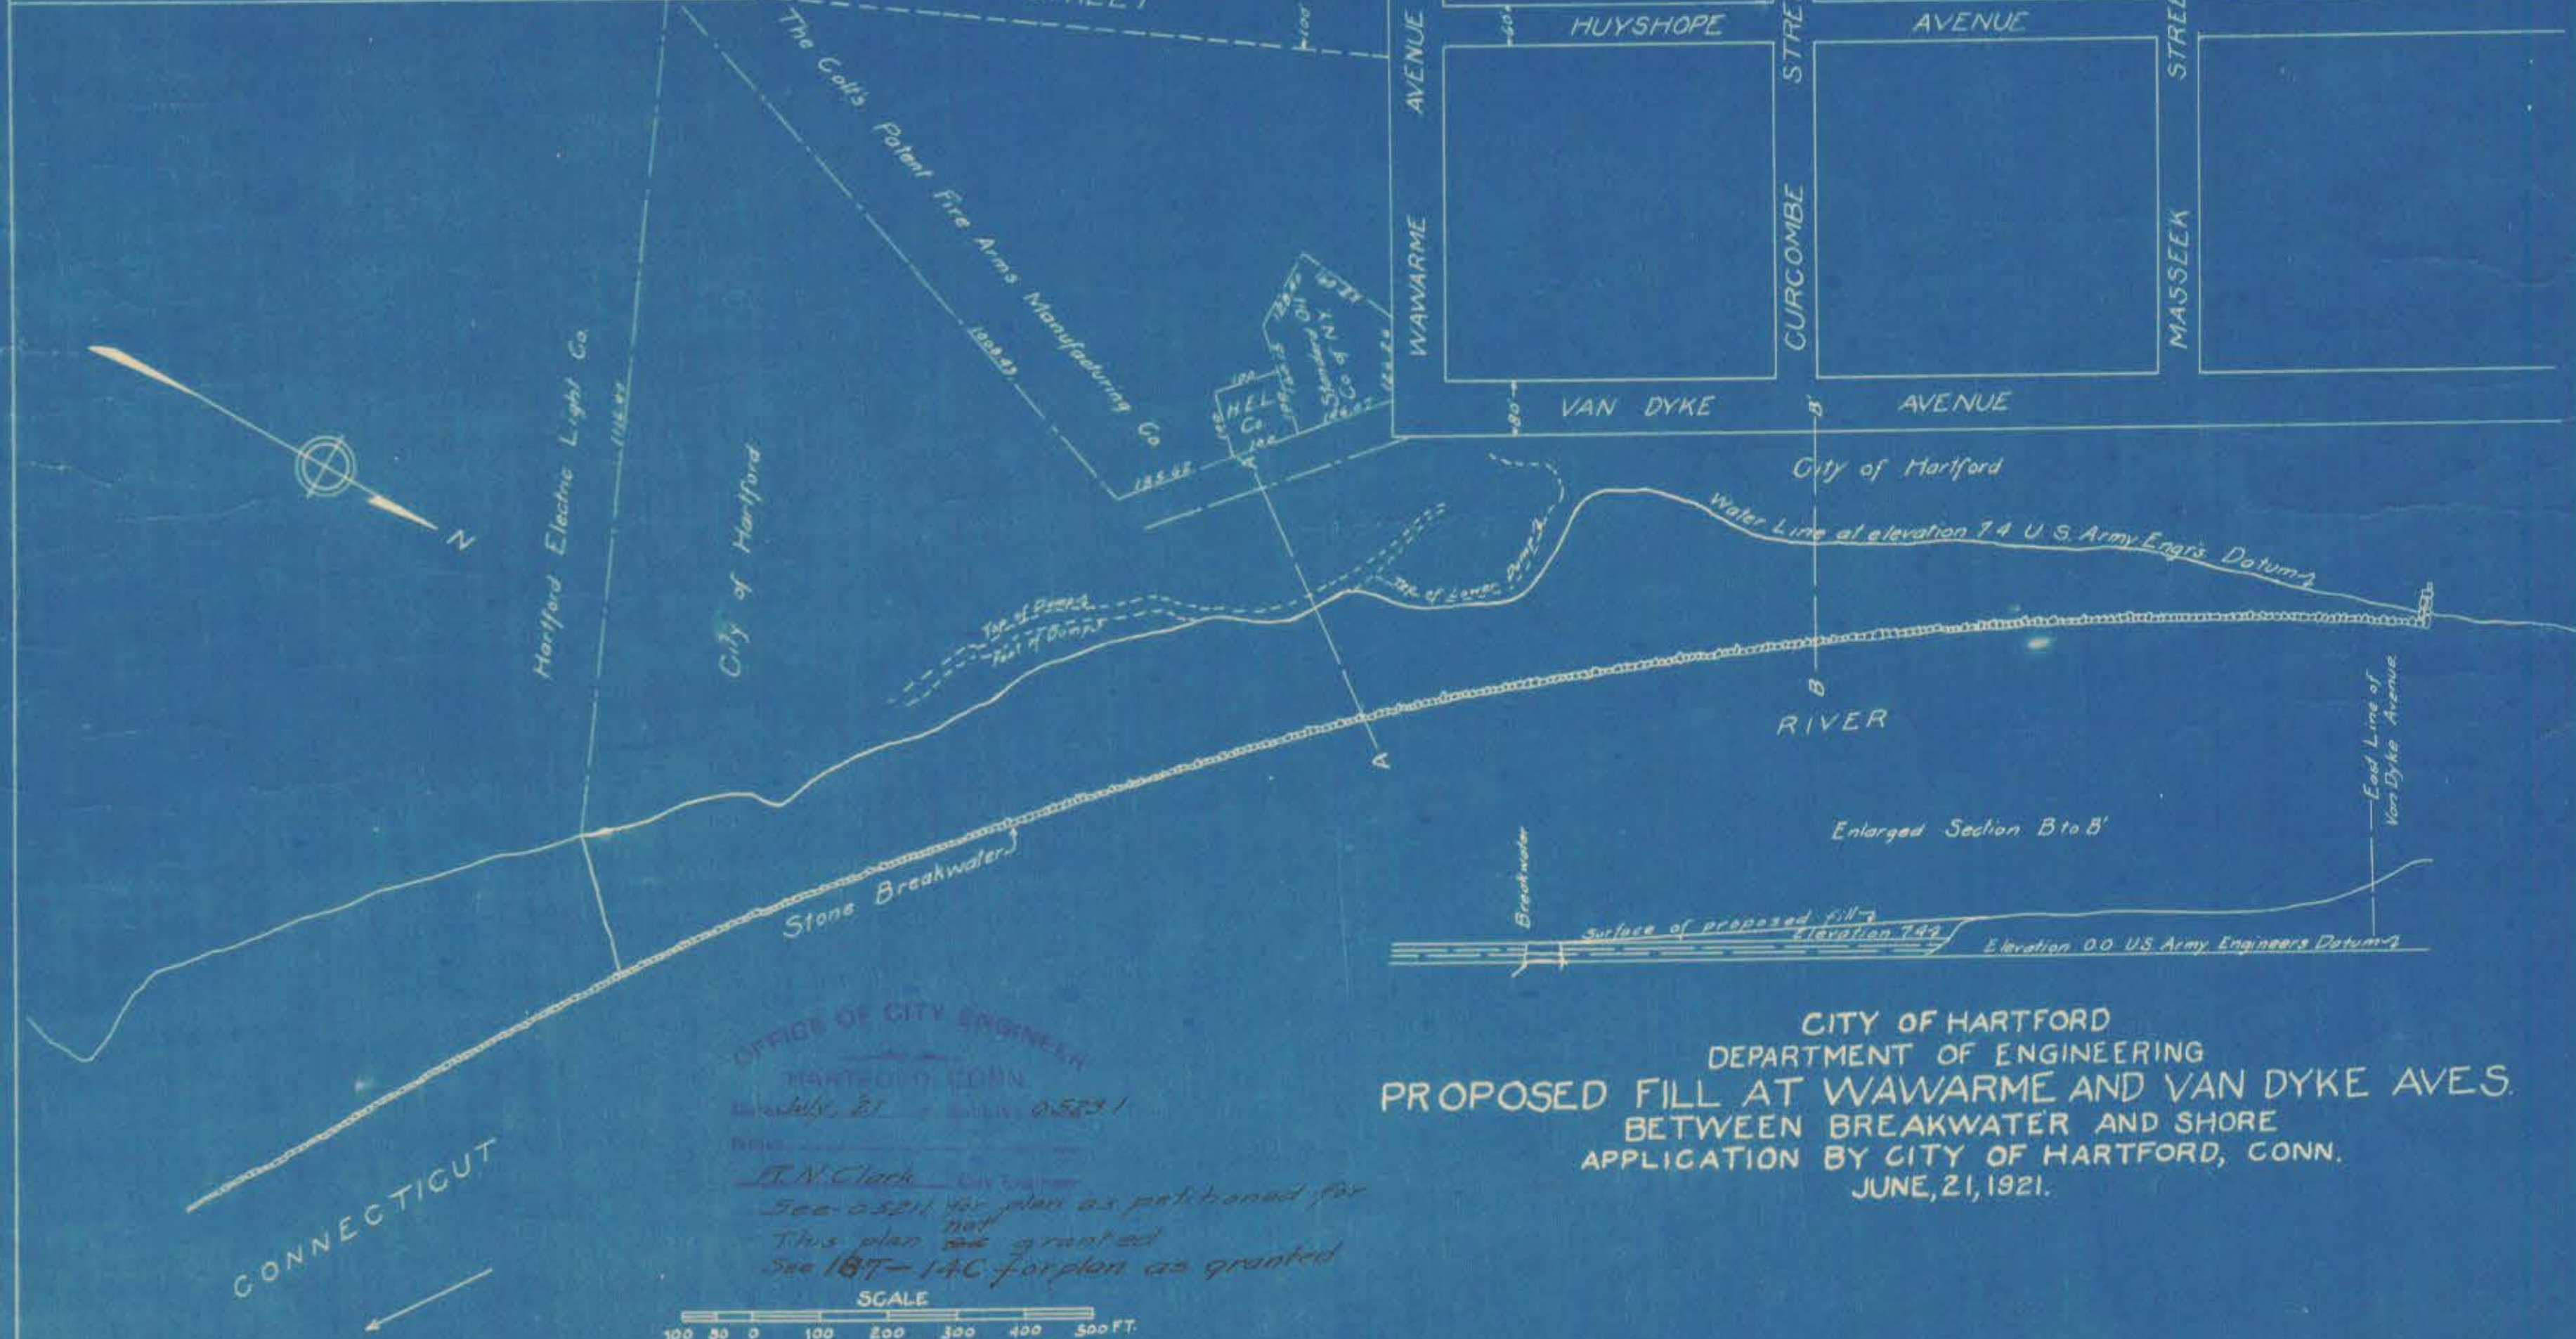


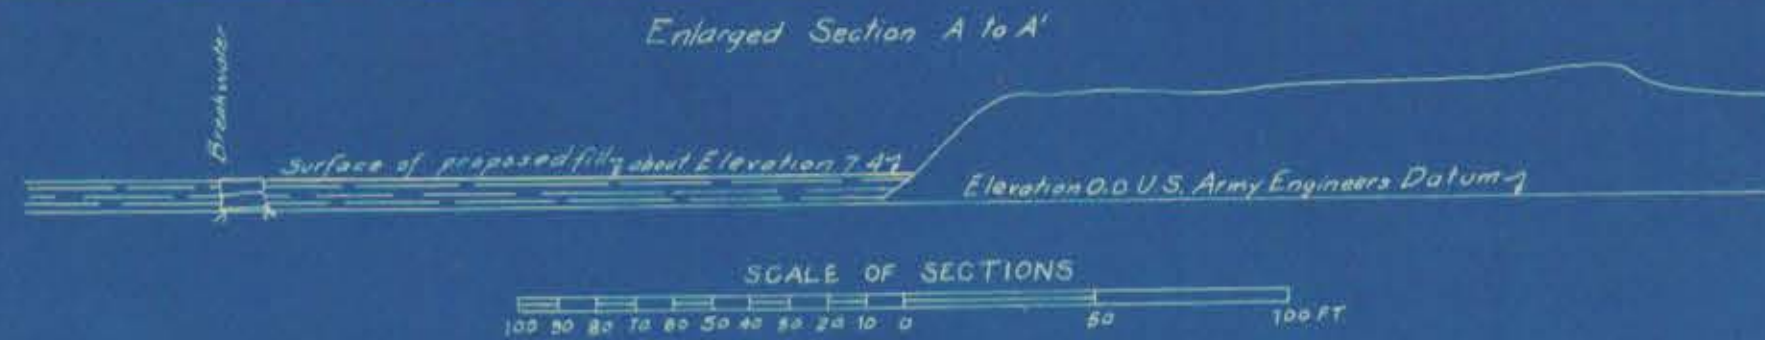

CITY OF HARTFORD
DEPARTMENT OF ENGINEERING
PROPOSED FILL AT WAWARME AND VAN DYKE AVES.
BETWEEN BREAKWATER AND SHORE
APPLICATION BY CITY OF HARTFORD, CONN.
JUNE, 21, 1921.