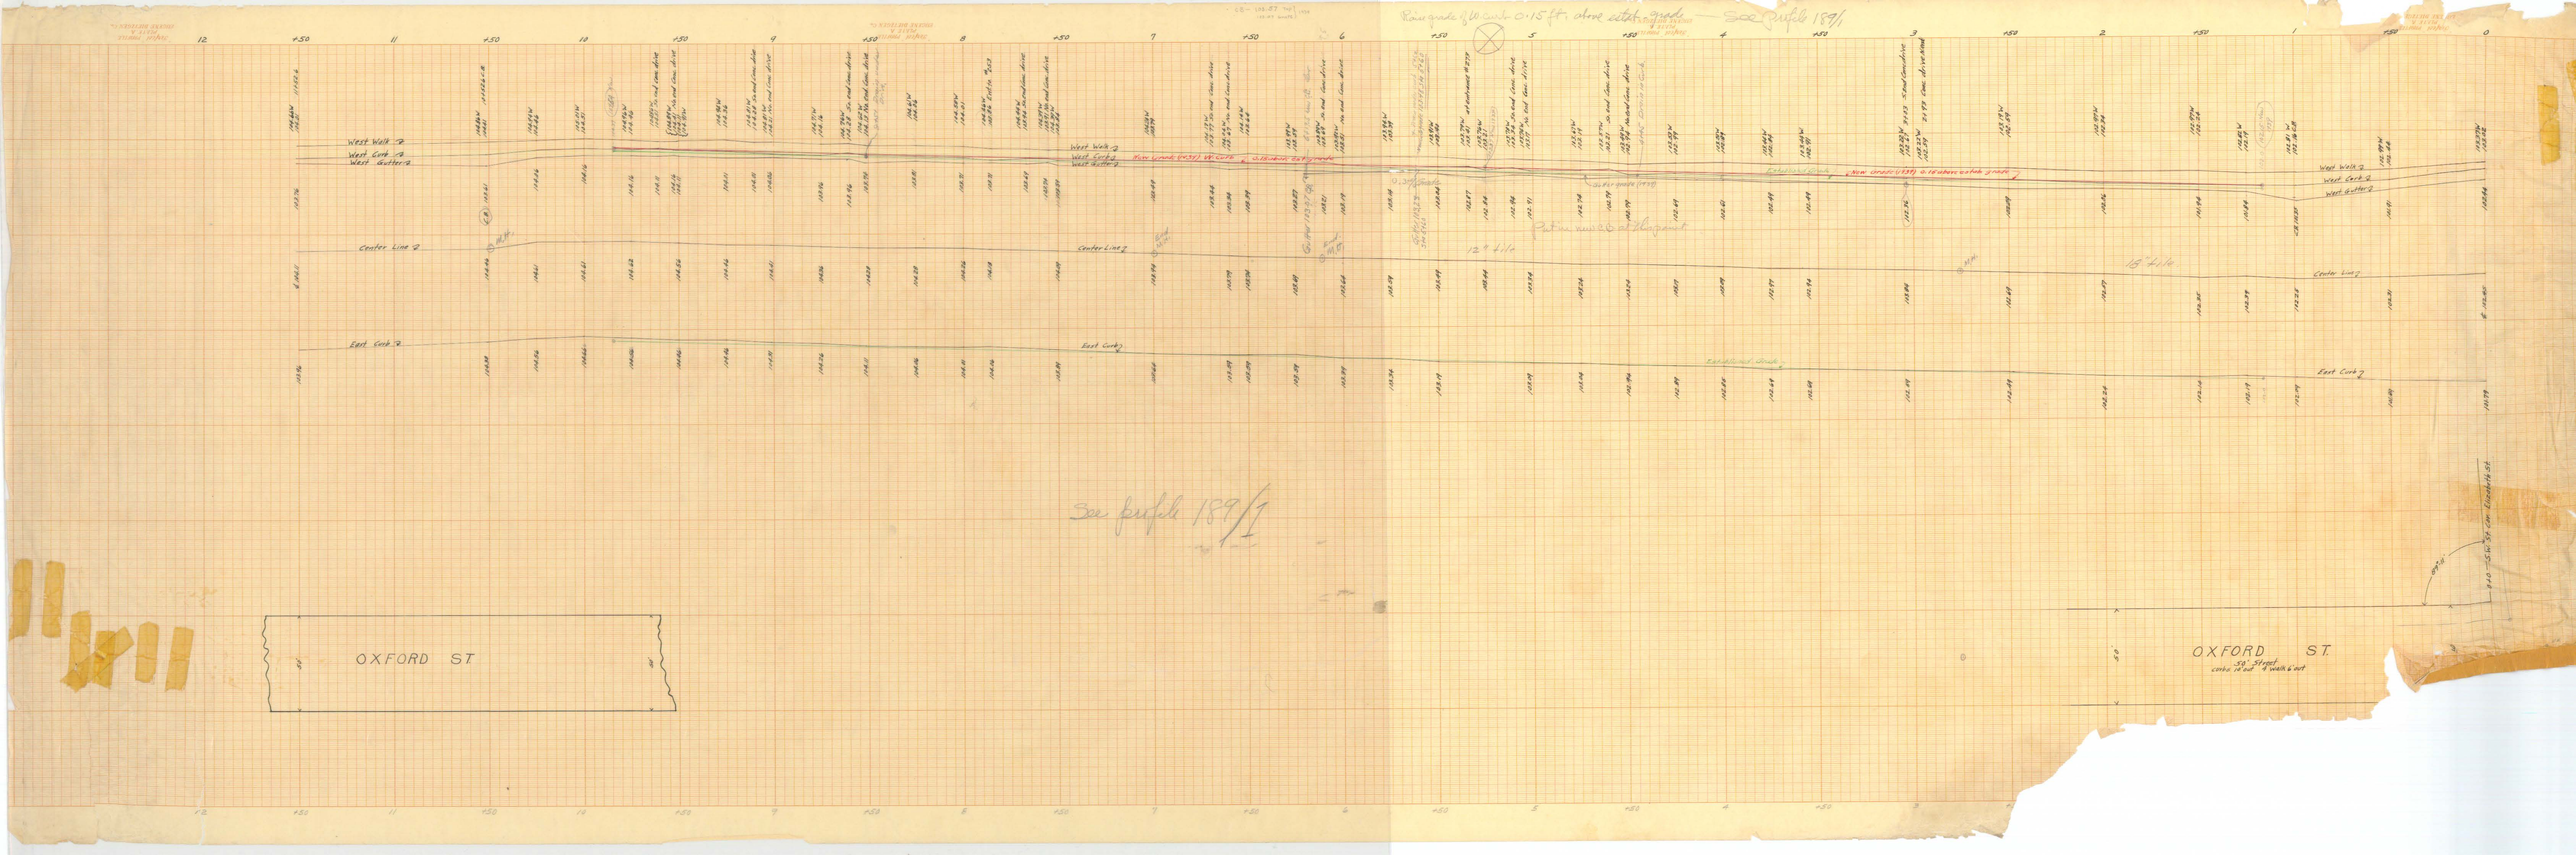
West Walk ℄
West Curb ℄
West Gutter ℄
Center Line ℄
East Curb ℄
OXFORD ST.
See profile 189/1
See profile 189/1
OXFORD ST.