


See Sheet 126

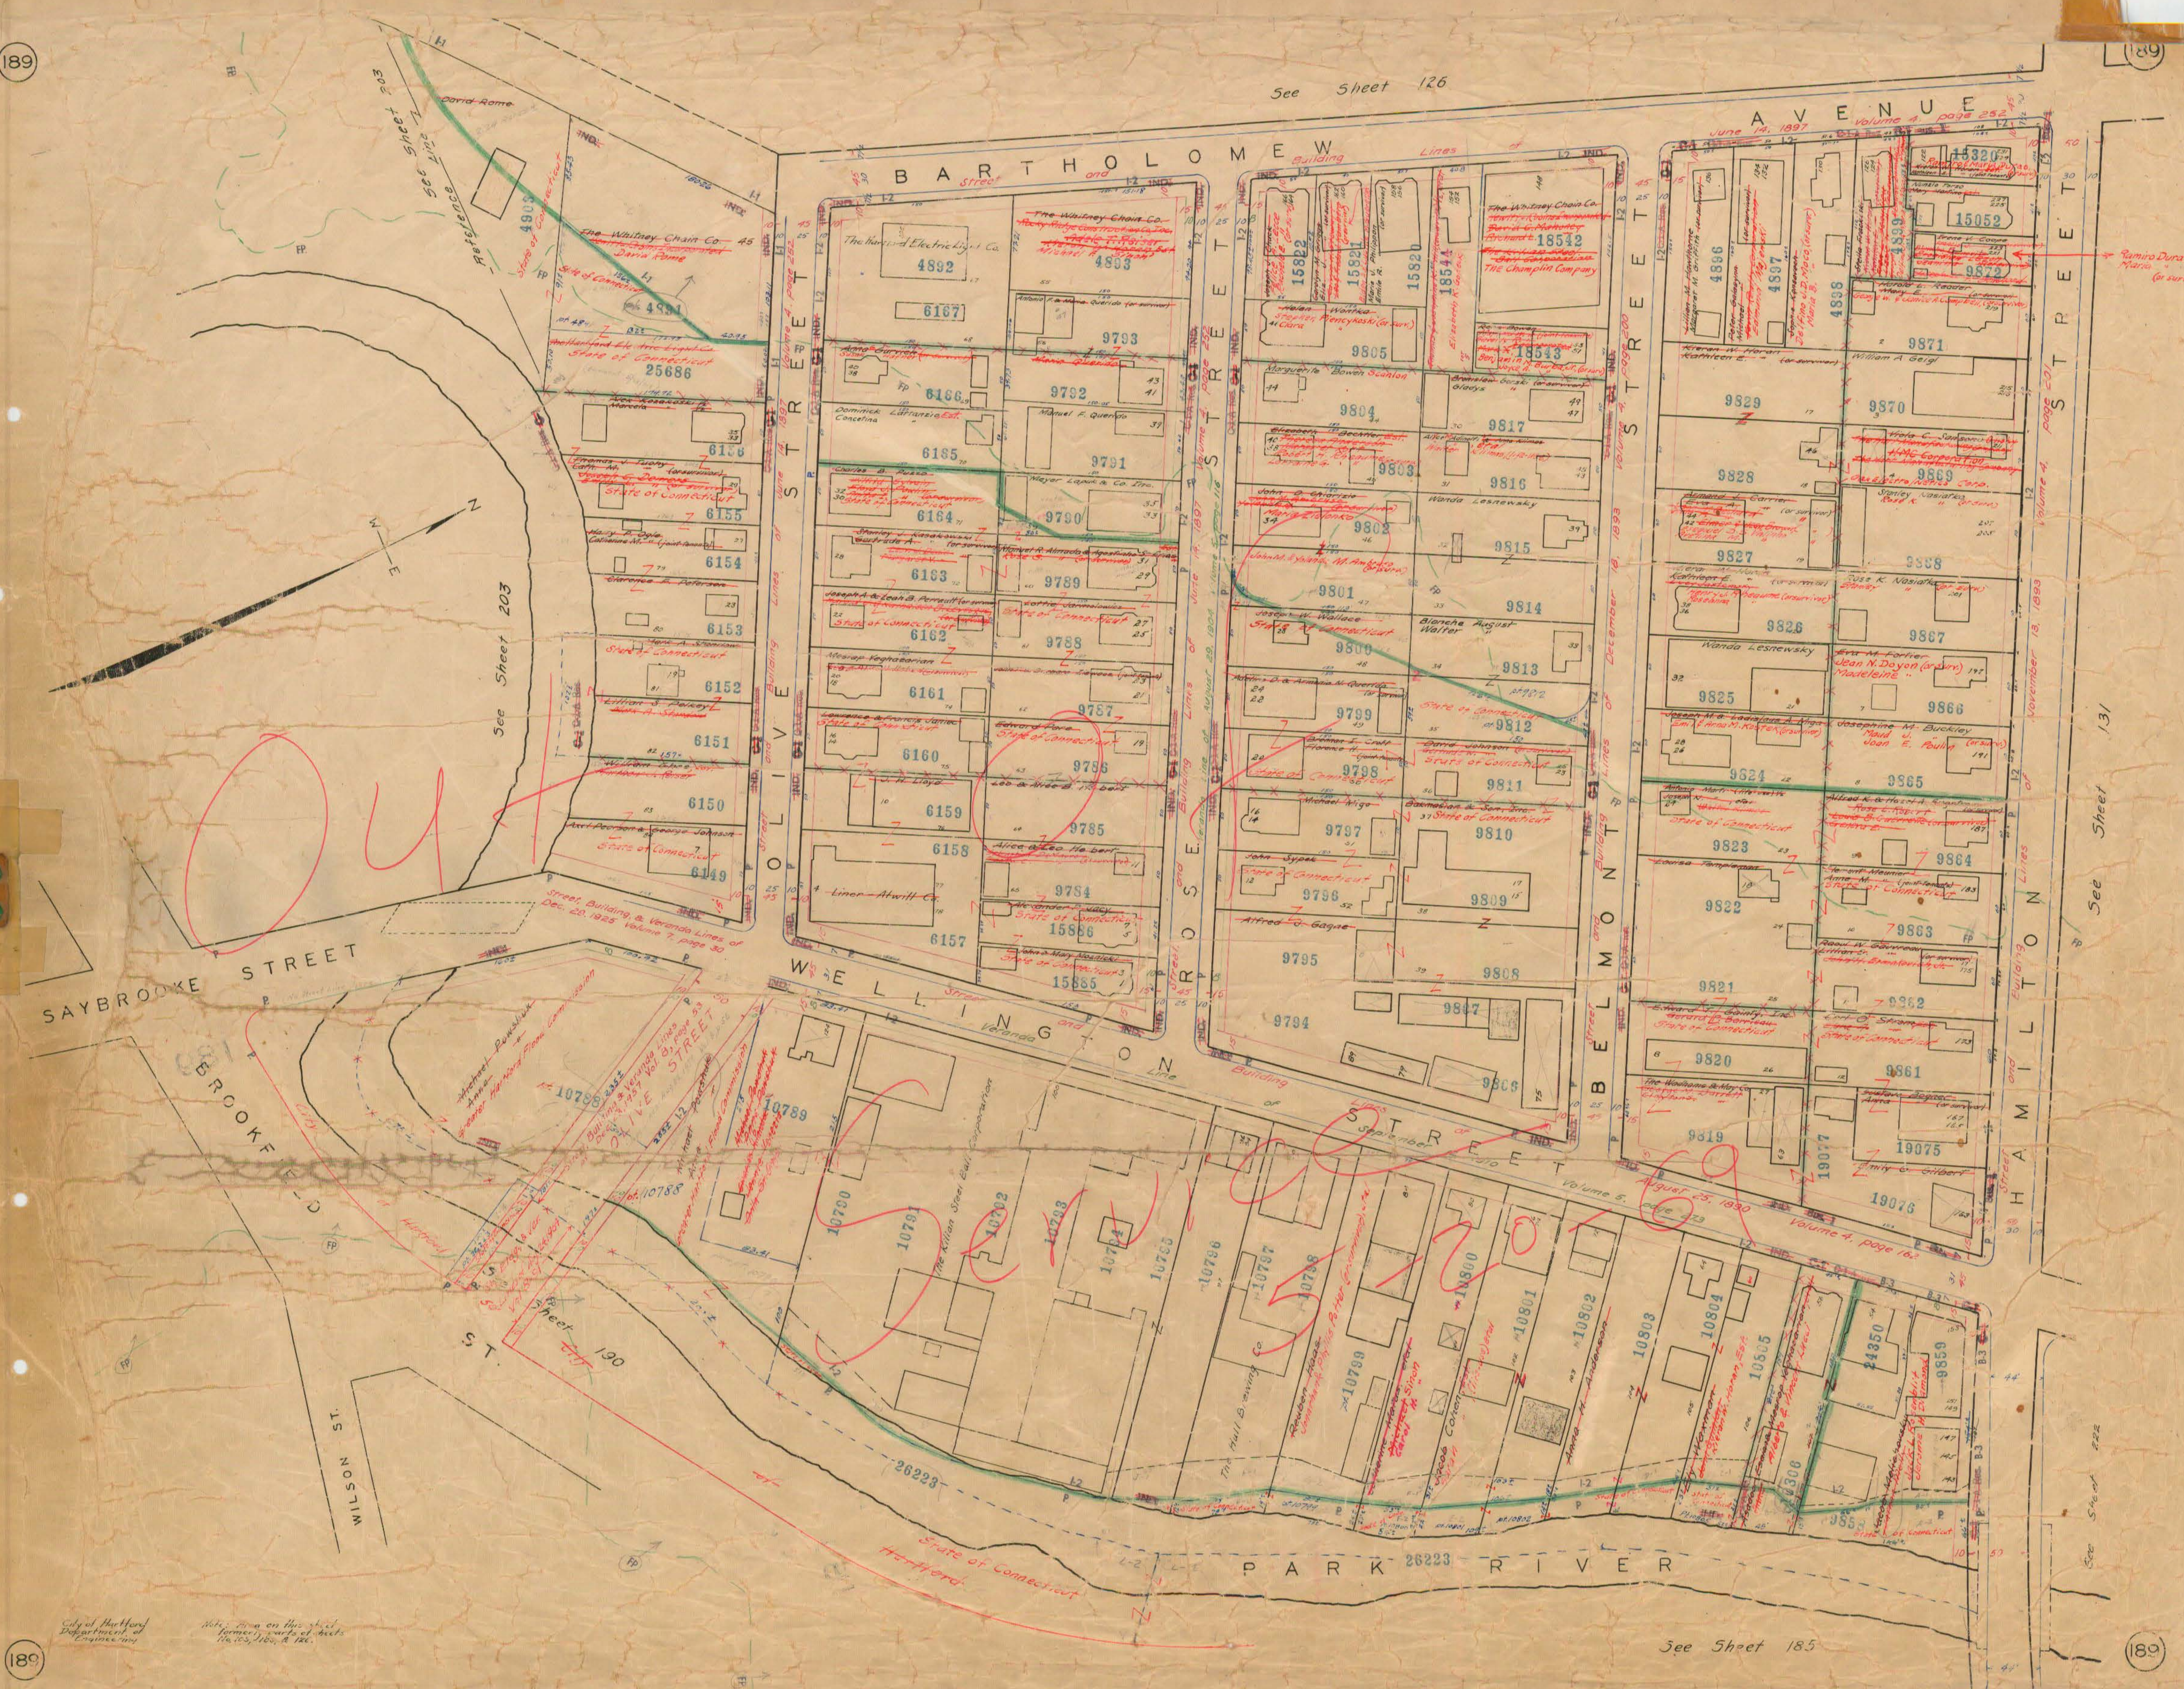

See Sheet 185