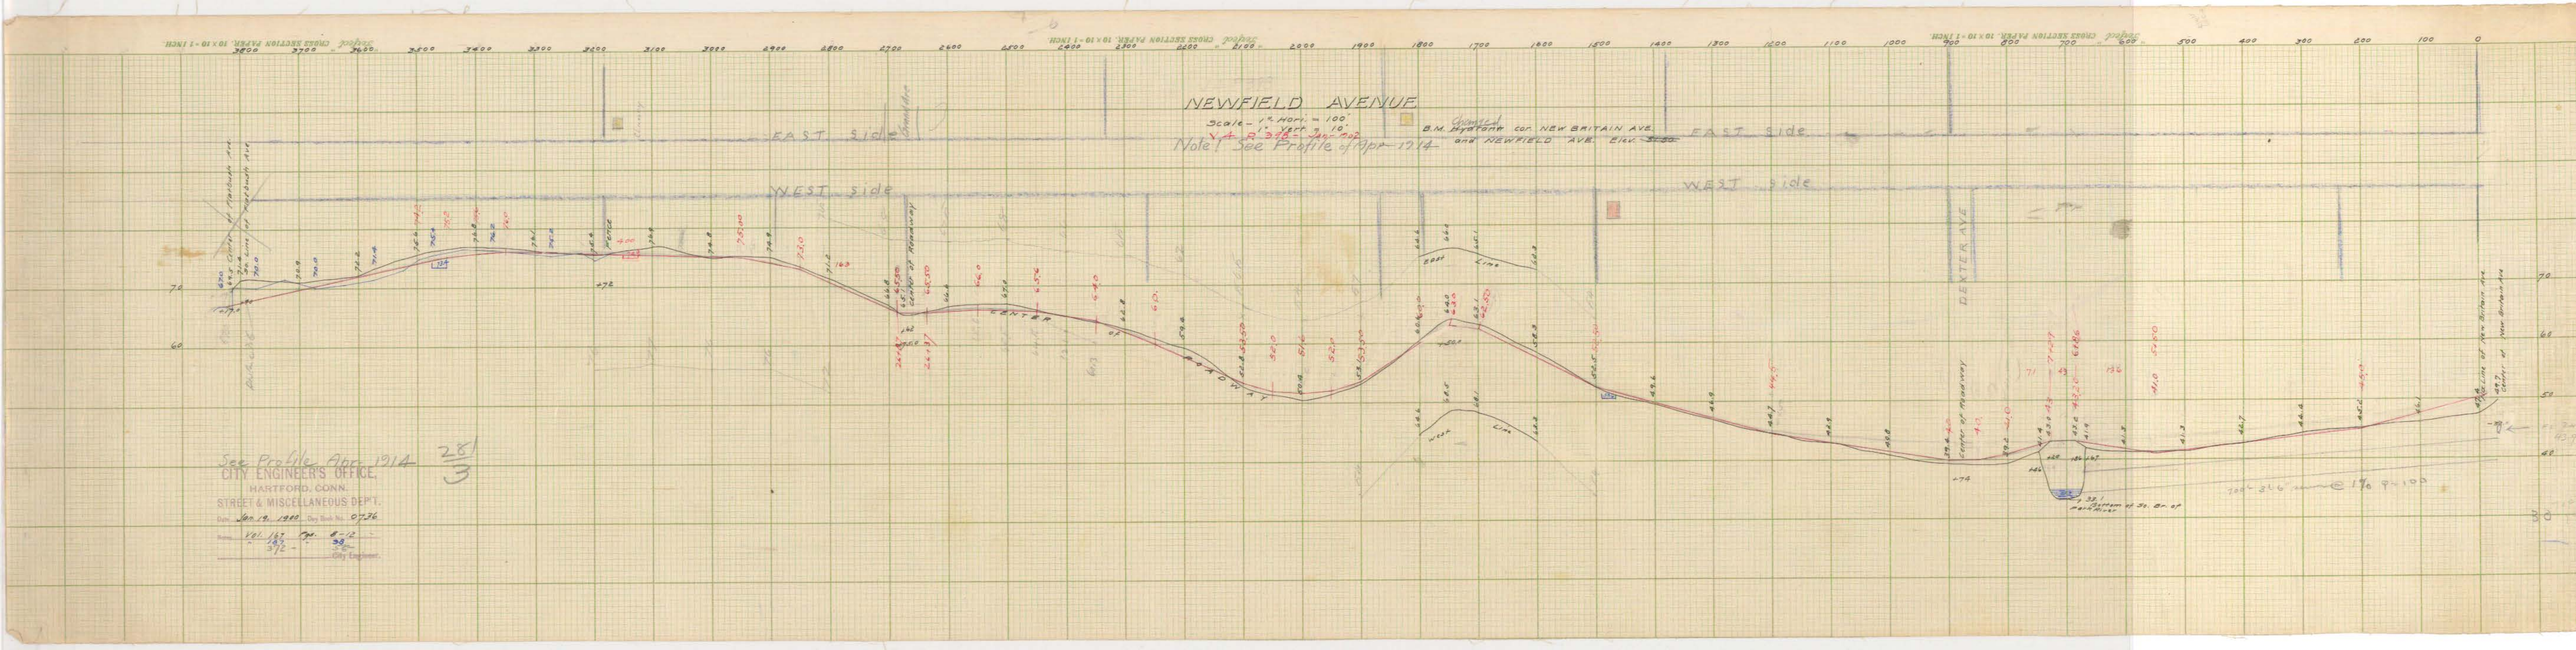
NEWFIELD AVENUE
Scale - 1" Hori. = 100'
Vert. = 10'
Note! See Profile of Apr. 1914
B.M. Hydrant cor. NEW BRITAIN AVE. and NEWFIELD AVE. Elev. 72.00
EAST Side
WEST Side
DEXTER AVE.
See Profile Apr. 1914
CITY ENGINEER'S OFFICE,
HARTFORD, CONN.
STREET & MISCELLANEOUS DEP'T.
Date Jan. 19, 1940. Dy. Bk. No. 0-76
Book Vol. 187 Pg. 6-2
" 188 " 39
" 372 " 36
City Engineer.