


Perfect CROSS SECTION PAPER. 10 X 10 - 1 INCH.

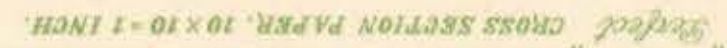

CITY ENGINEER'S OFFICE
HARTFORD, CONN.
SEWER & UNDERGROUND DEPT.
Jan. 21-1900 Day Book No. 0740
Vol. 166 - pp 54-57

City Engineer.

B.M. E1.79.35 - Hydrant opposite Frankfort St.