

See Sheet 203

Street Building & Veranda Lines of Aug 12, 1918 Vol. 6-255



Vol. 6-255

Street Building & Veranda Lines of August 12, 1918

Street Building & Veranda Lines of August 12, 1918 Vol. 6-254

DEPT. OF ENGINEERING
CITY OF HARTFORD
Scale 1"=20'

BANNISTER ST.

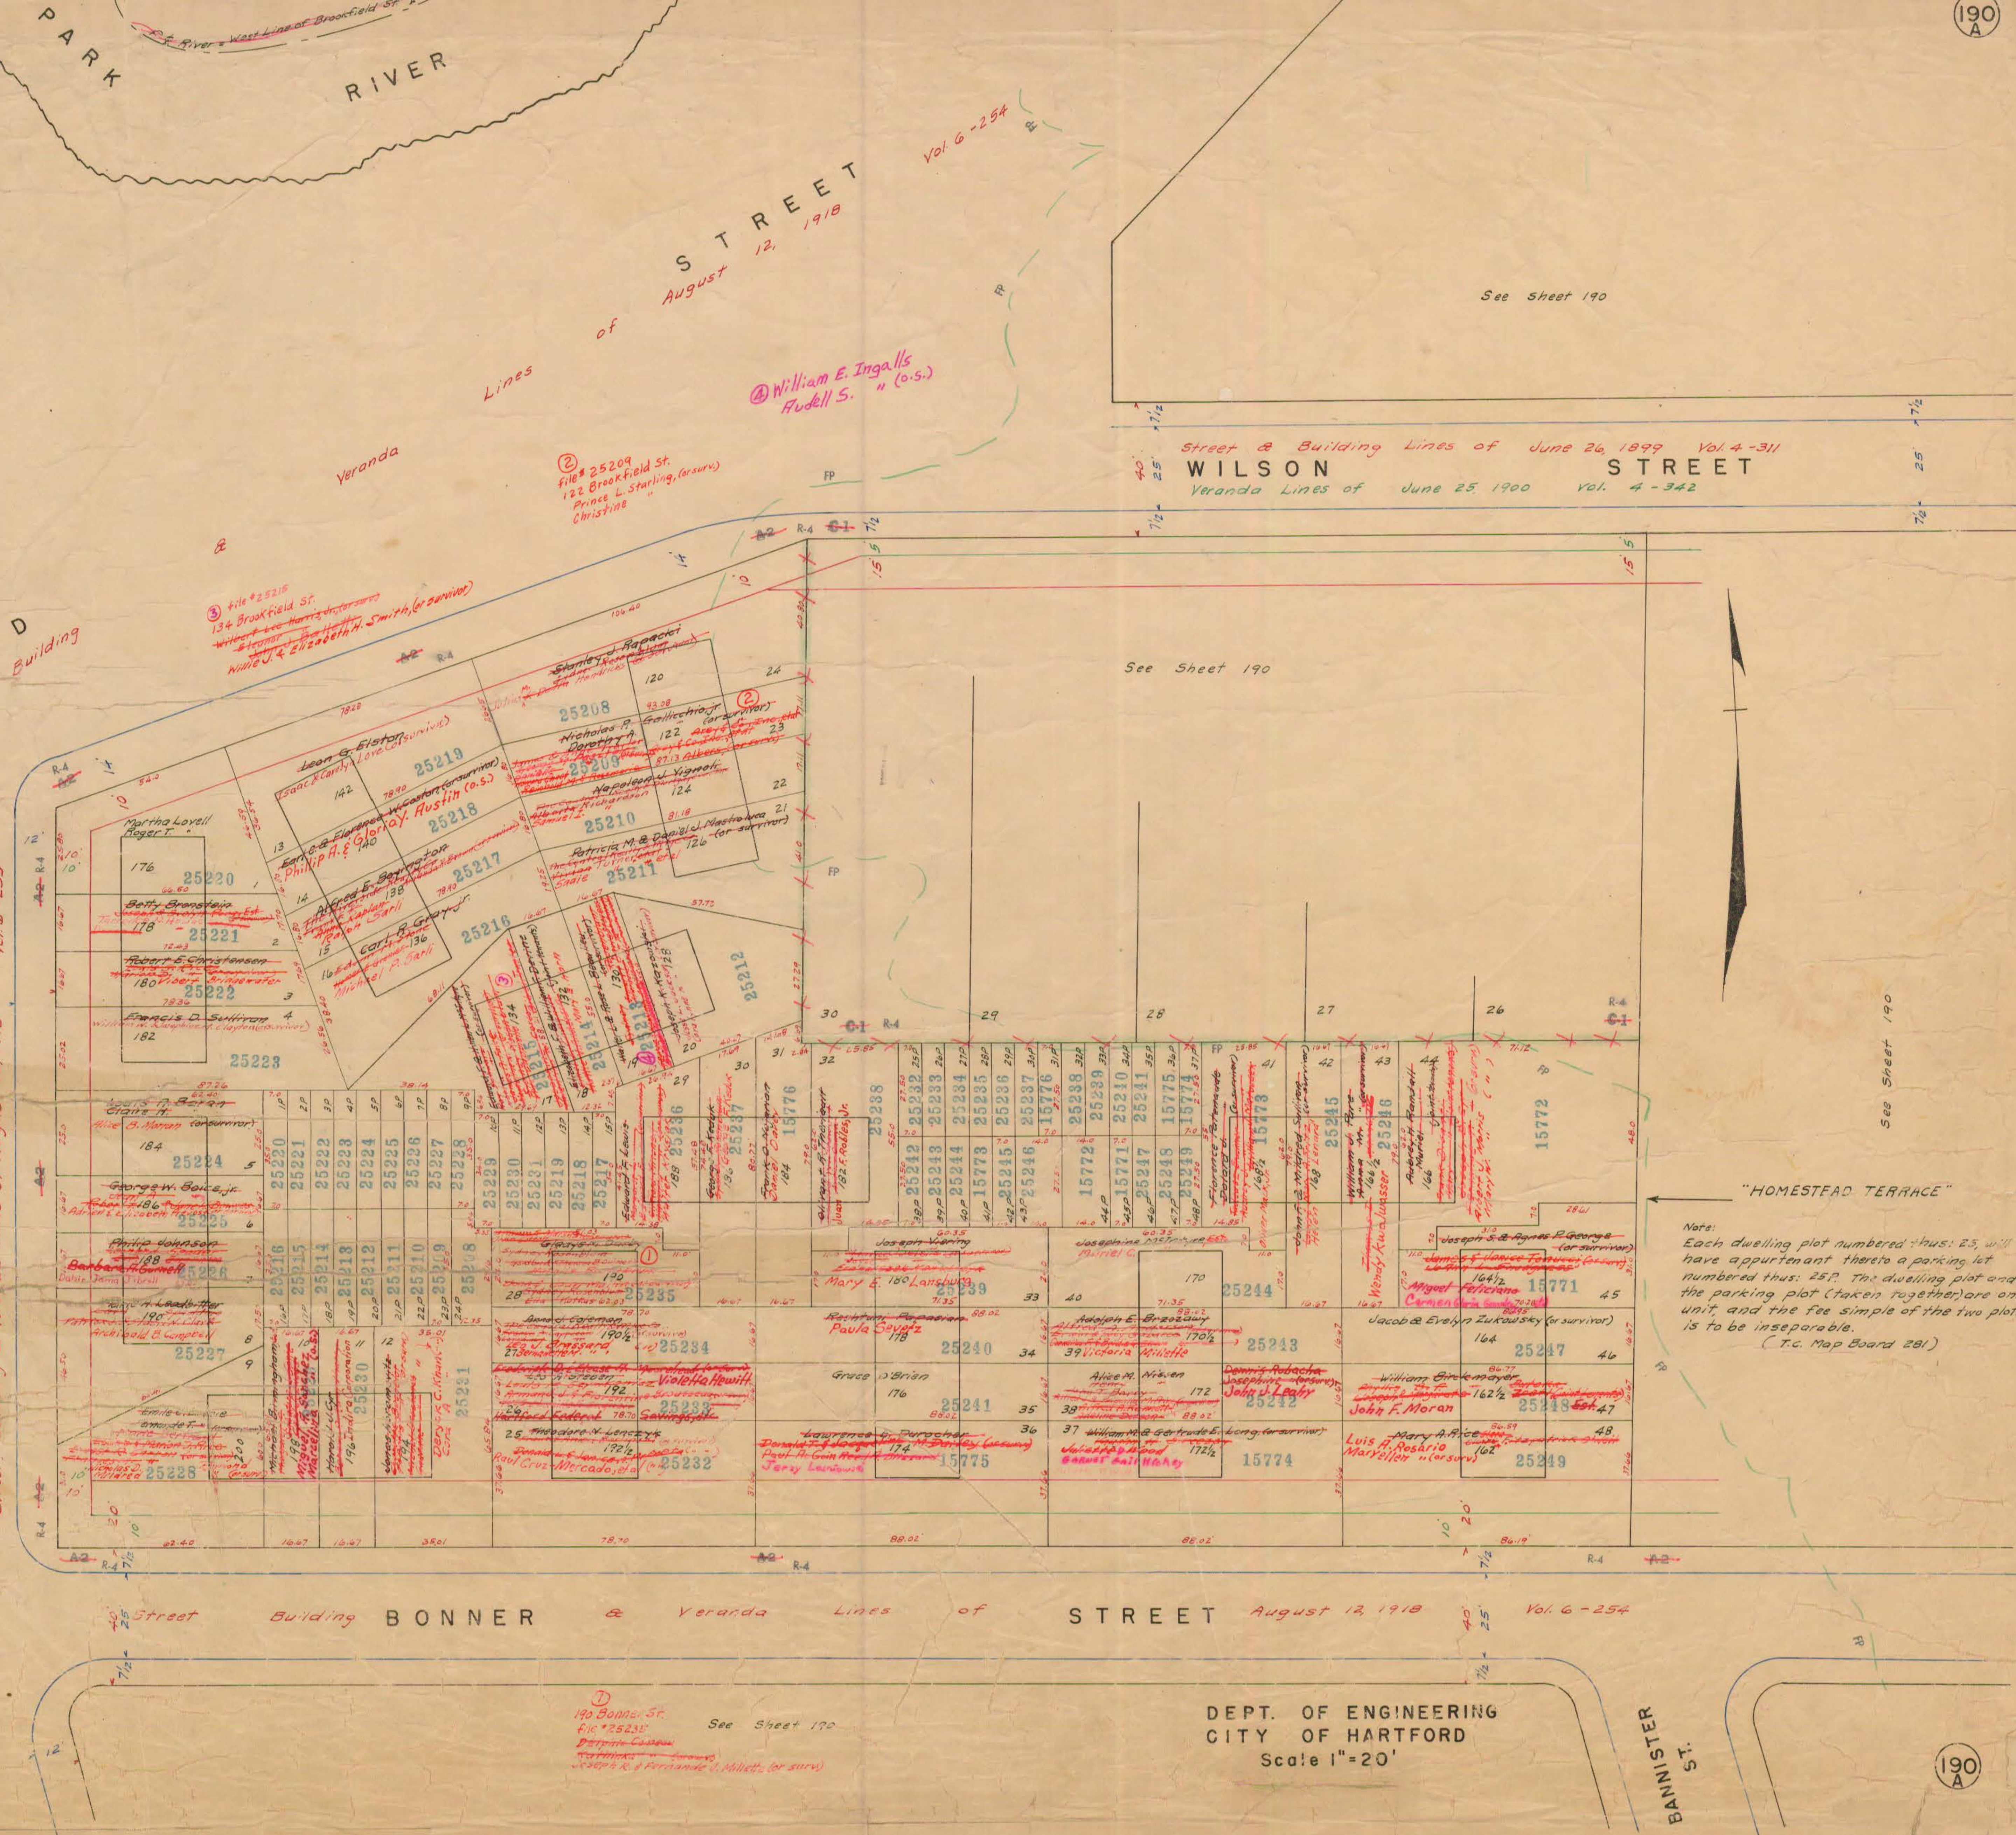

Note:
Each dwelling plot numbered thus: 25, will
have appurtenant thereto a parking lot
numbered thus: 25P. This dwelling plot and
the parking plot (taken together) are one
unit, and the fee simple of the two plots
is to be inseparable.
(T.C. Map Board 281)

① 190 Bonner St.
File #25231
See Sheet 190
Doris C. Galt
Doris C. Galt & Ferdinand J. Millett (or surv)

② File #25209
122 Brookfield St.
Prince L. Starling, (or surv)
Christine

④ William E. Ingalls
Hudell S. " (o.s.)

③ File #25216
134 Brookfield St.
Walter Lee Harris (or surv)
Elmer J. Harris
Walter J. & Elizabeth H. Smith, (or surv)