
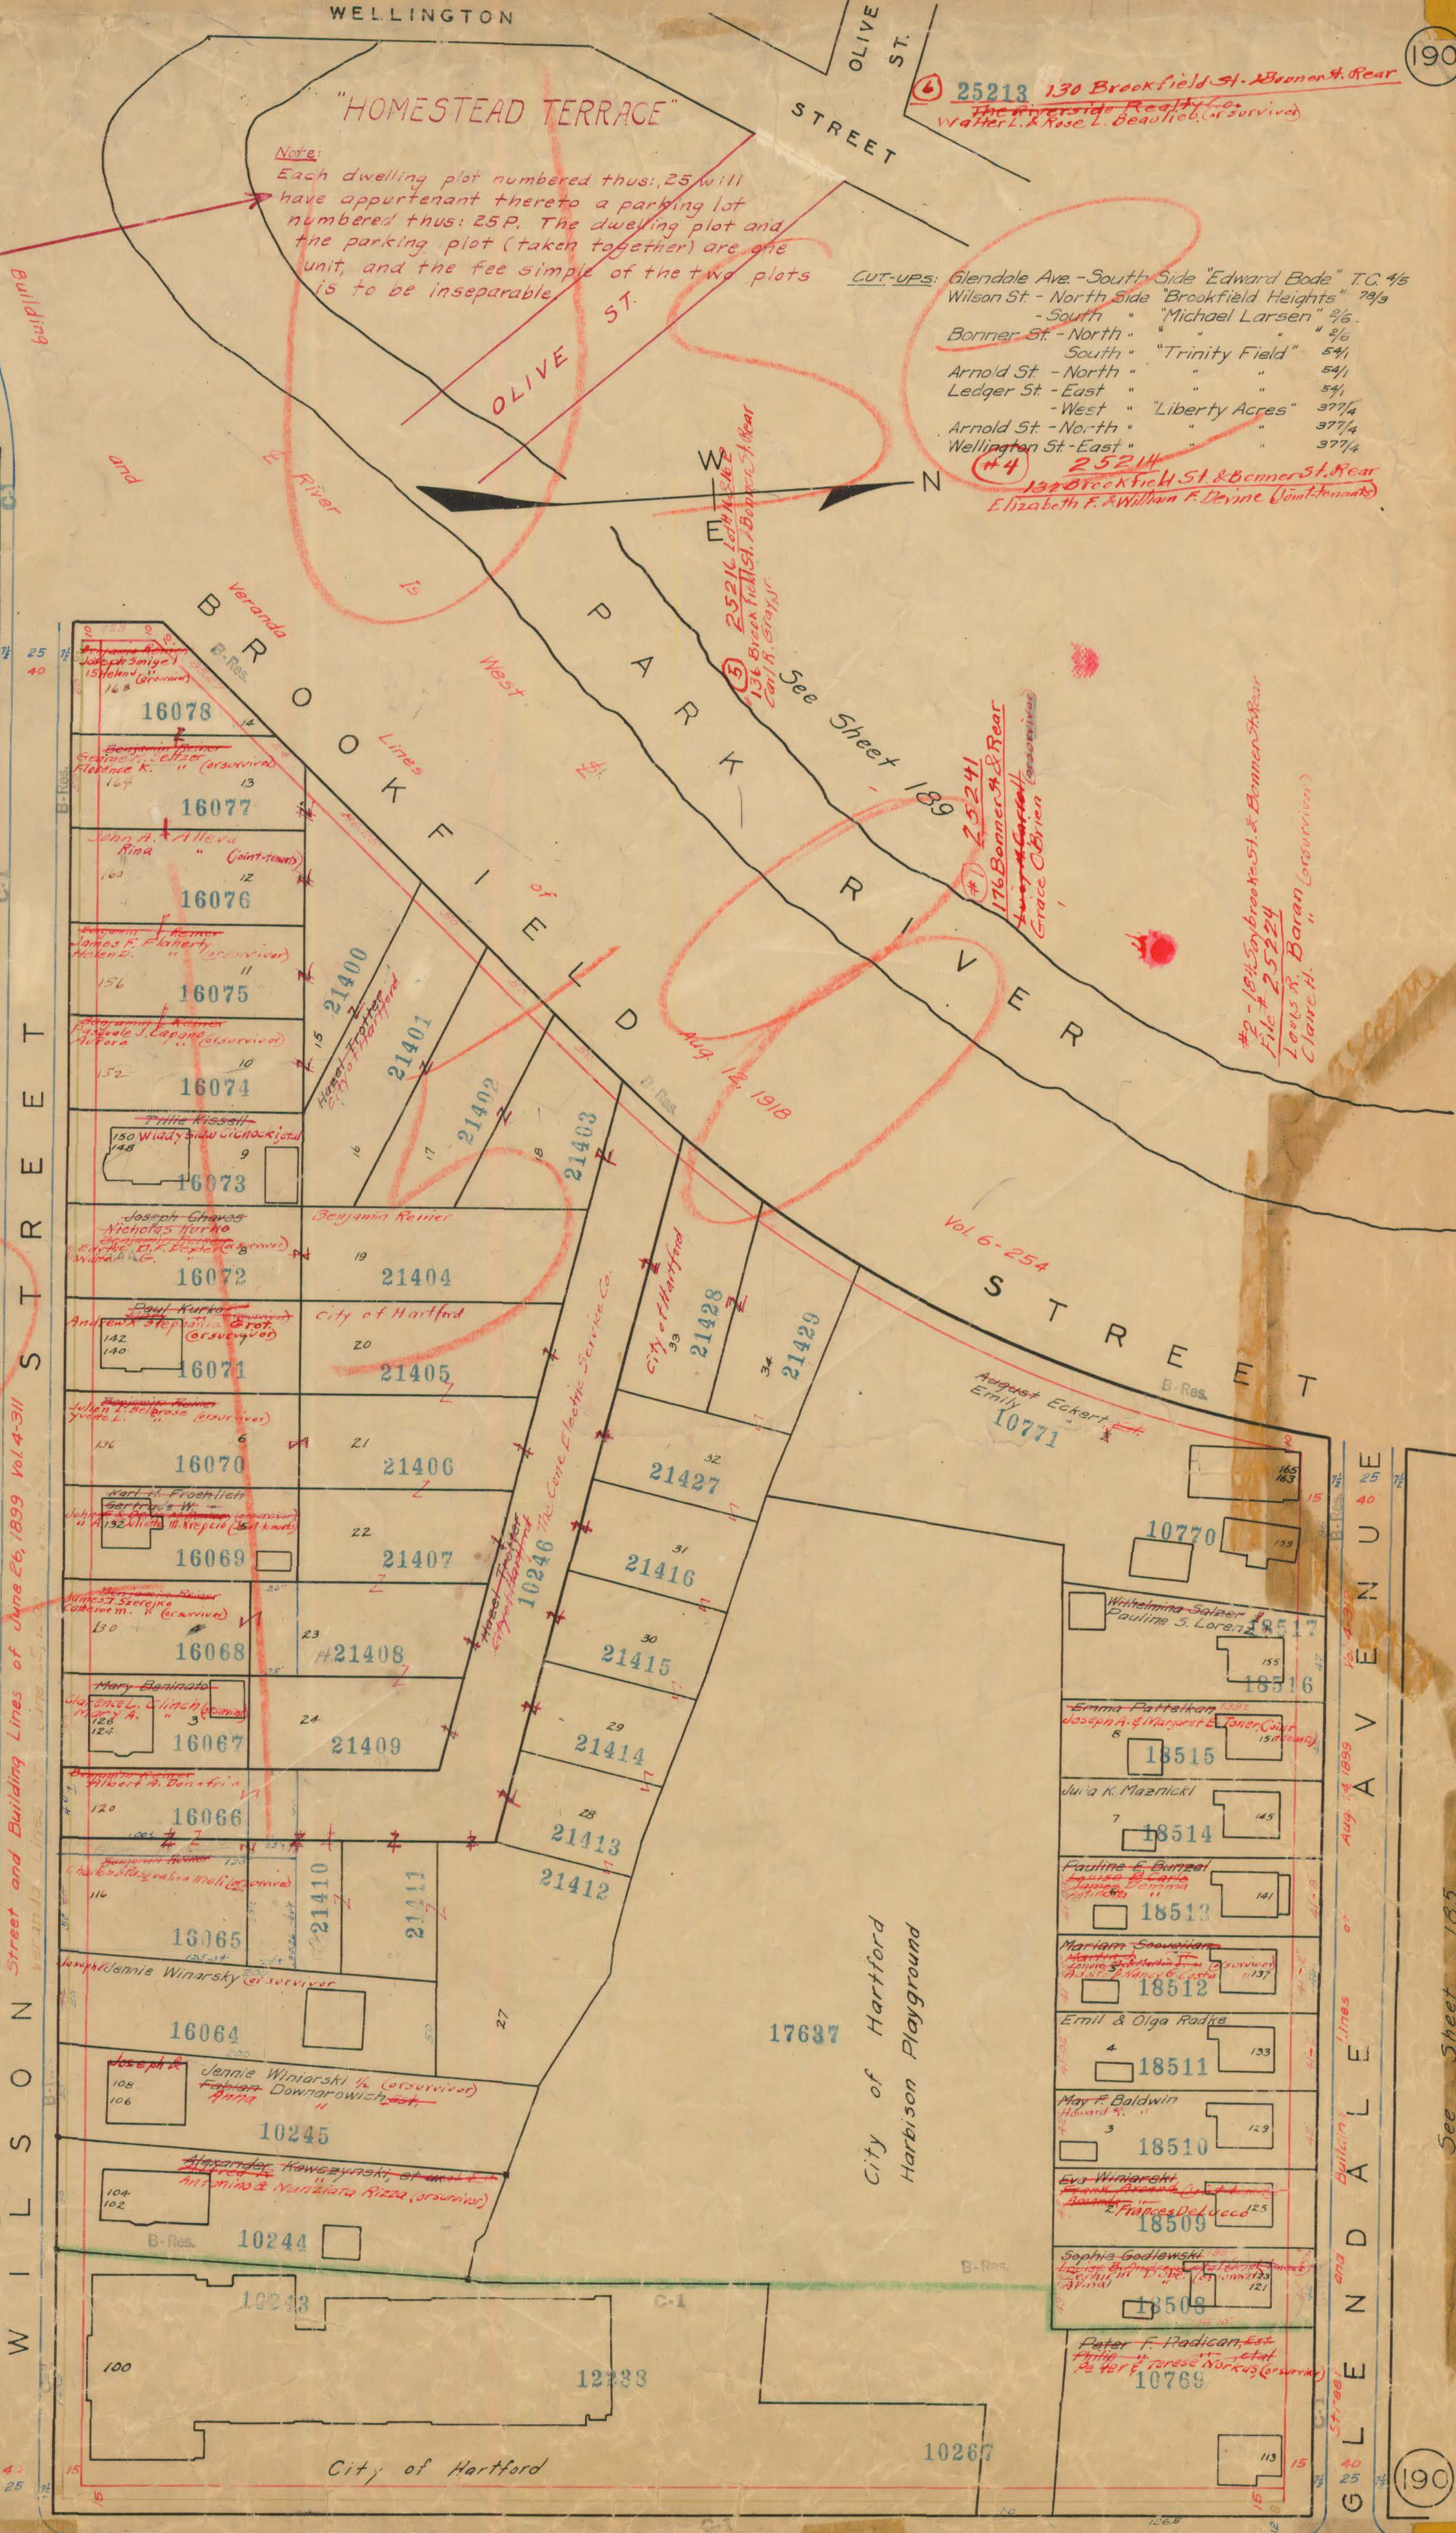


See Sheet 109

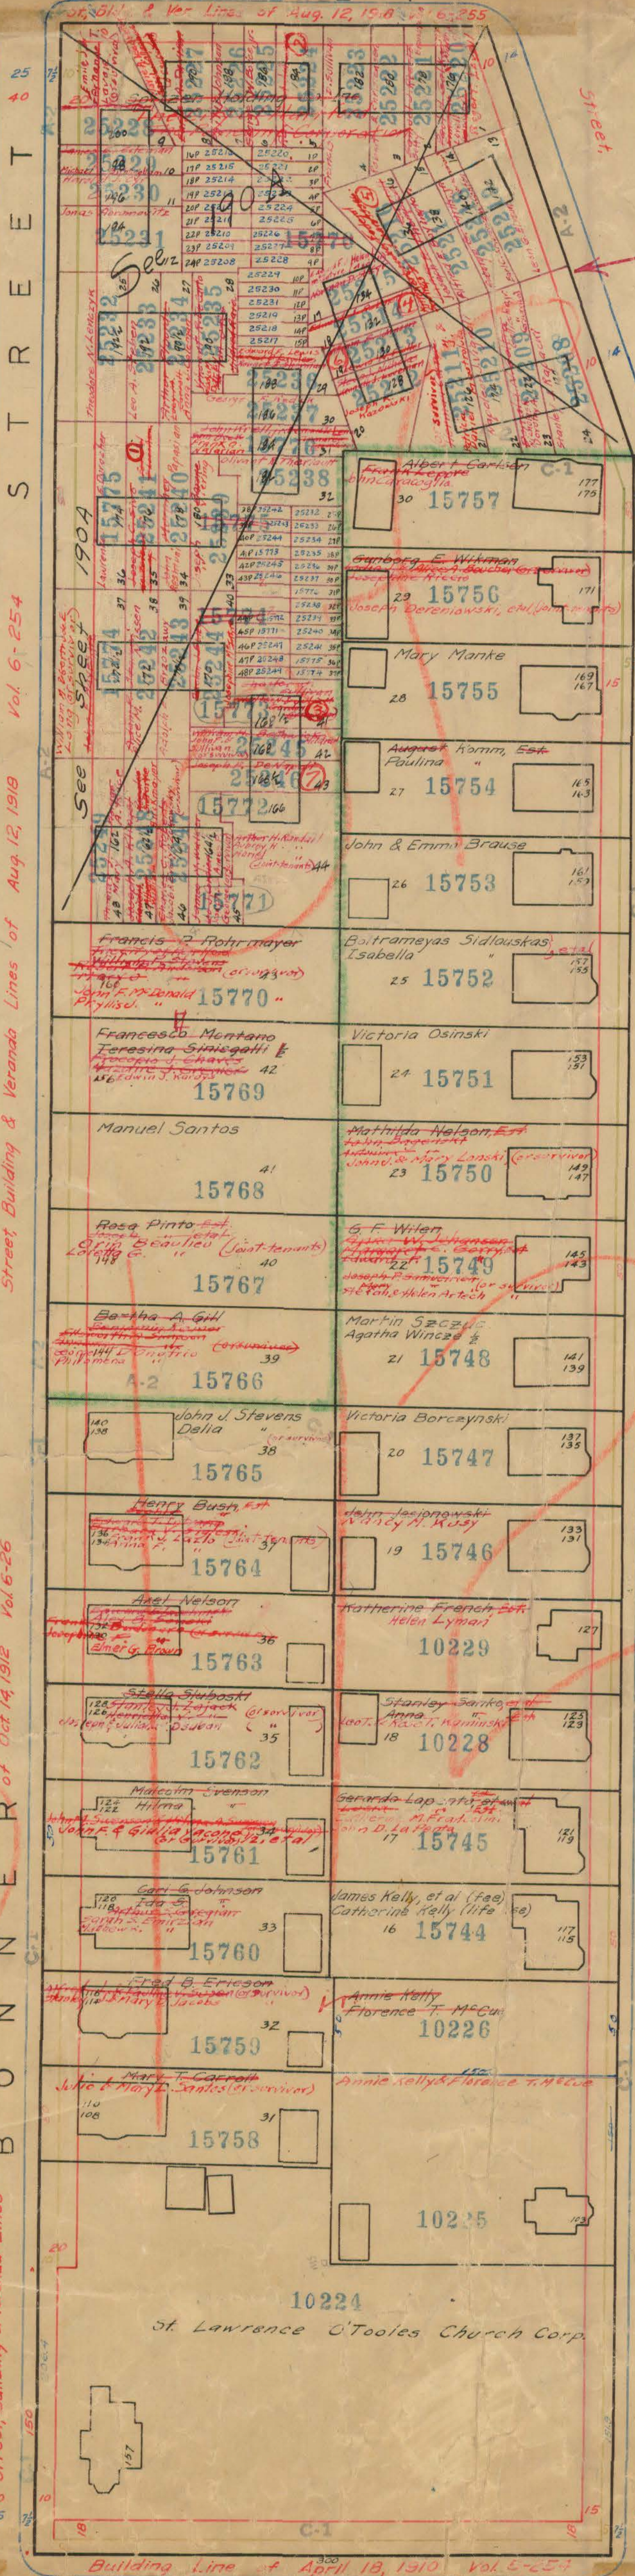

City of Hartford
Dept of Engineering
Aug 1928
Area on this sheet formerly
part of Sheet 103, 100 Scale