


PAVEMENT SECTION FOR BUS STOPS

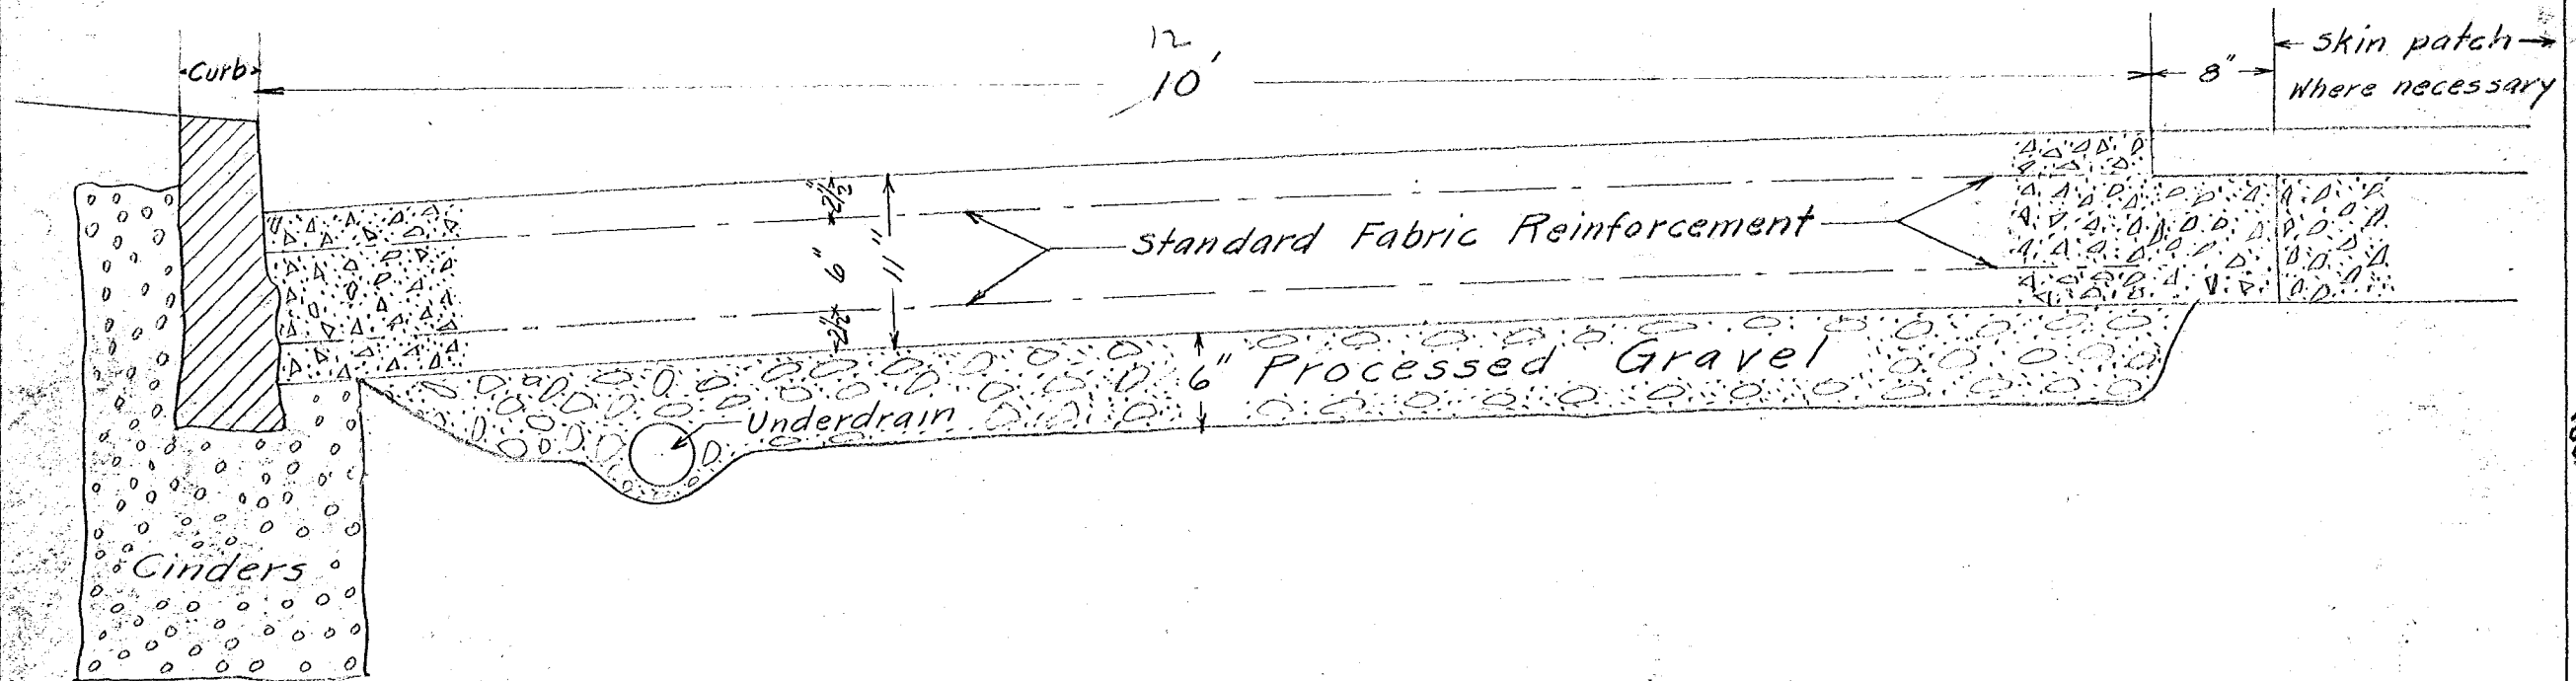

Sheet 1.

CITY OF HARTFORD
 DEPARTMENT OF ENGINEERING
 SCALE - 1" = 1' AUG. 1950
 DAYBOOK NO. 09125