


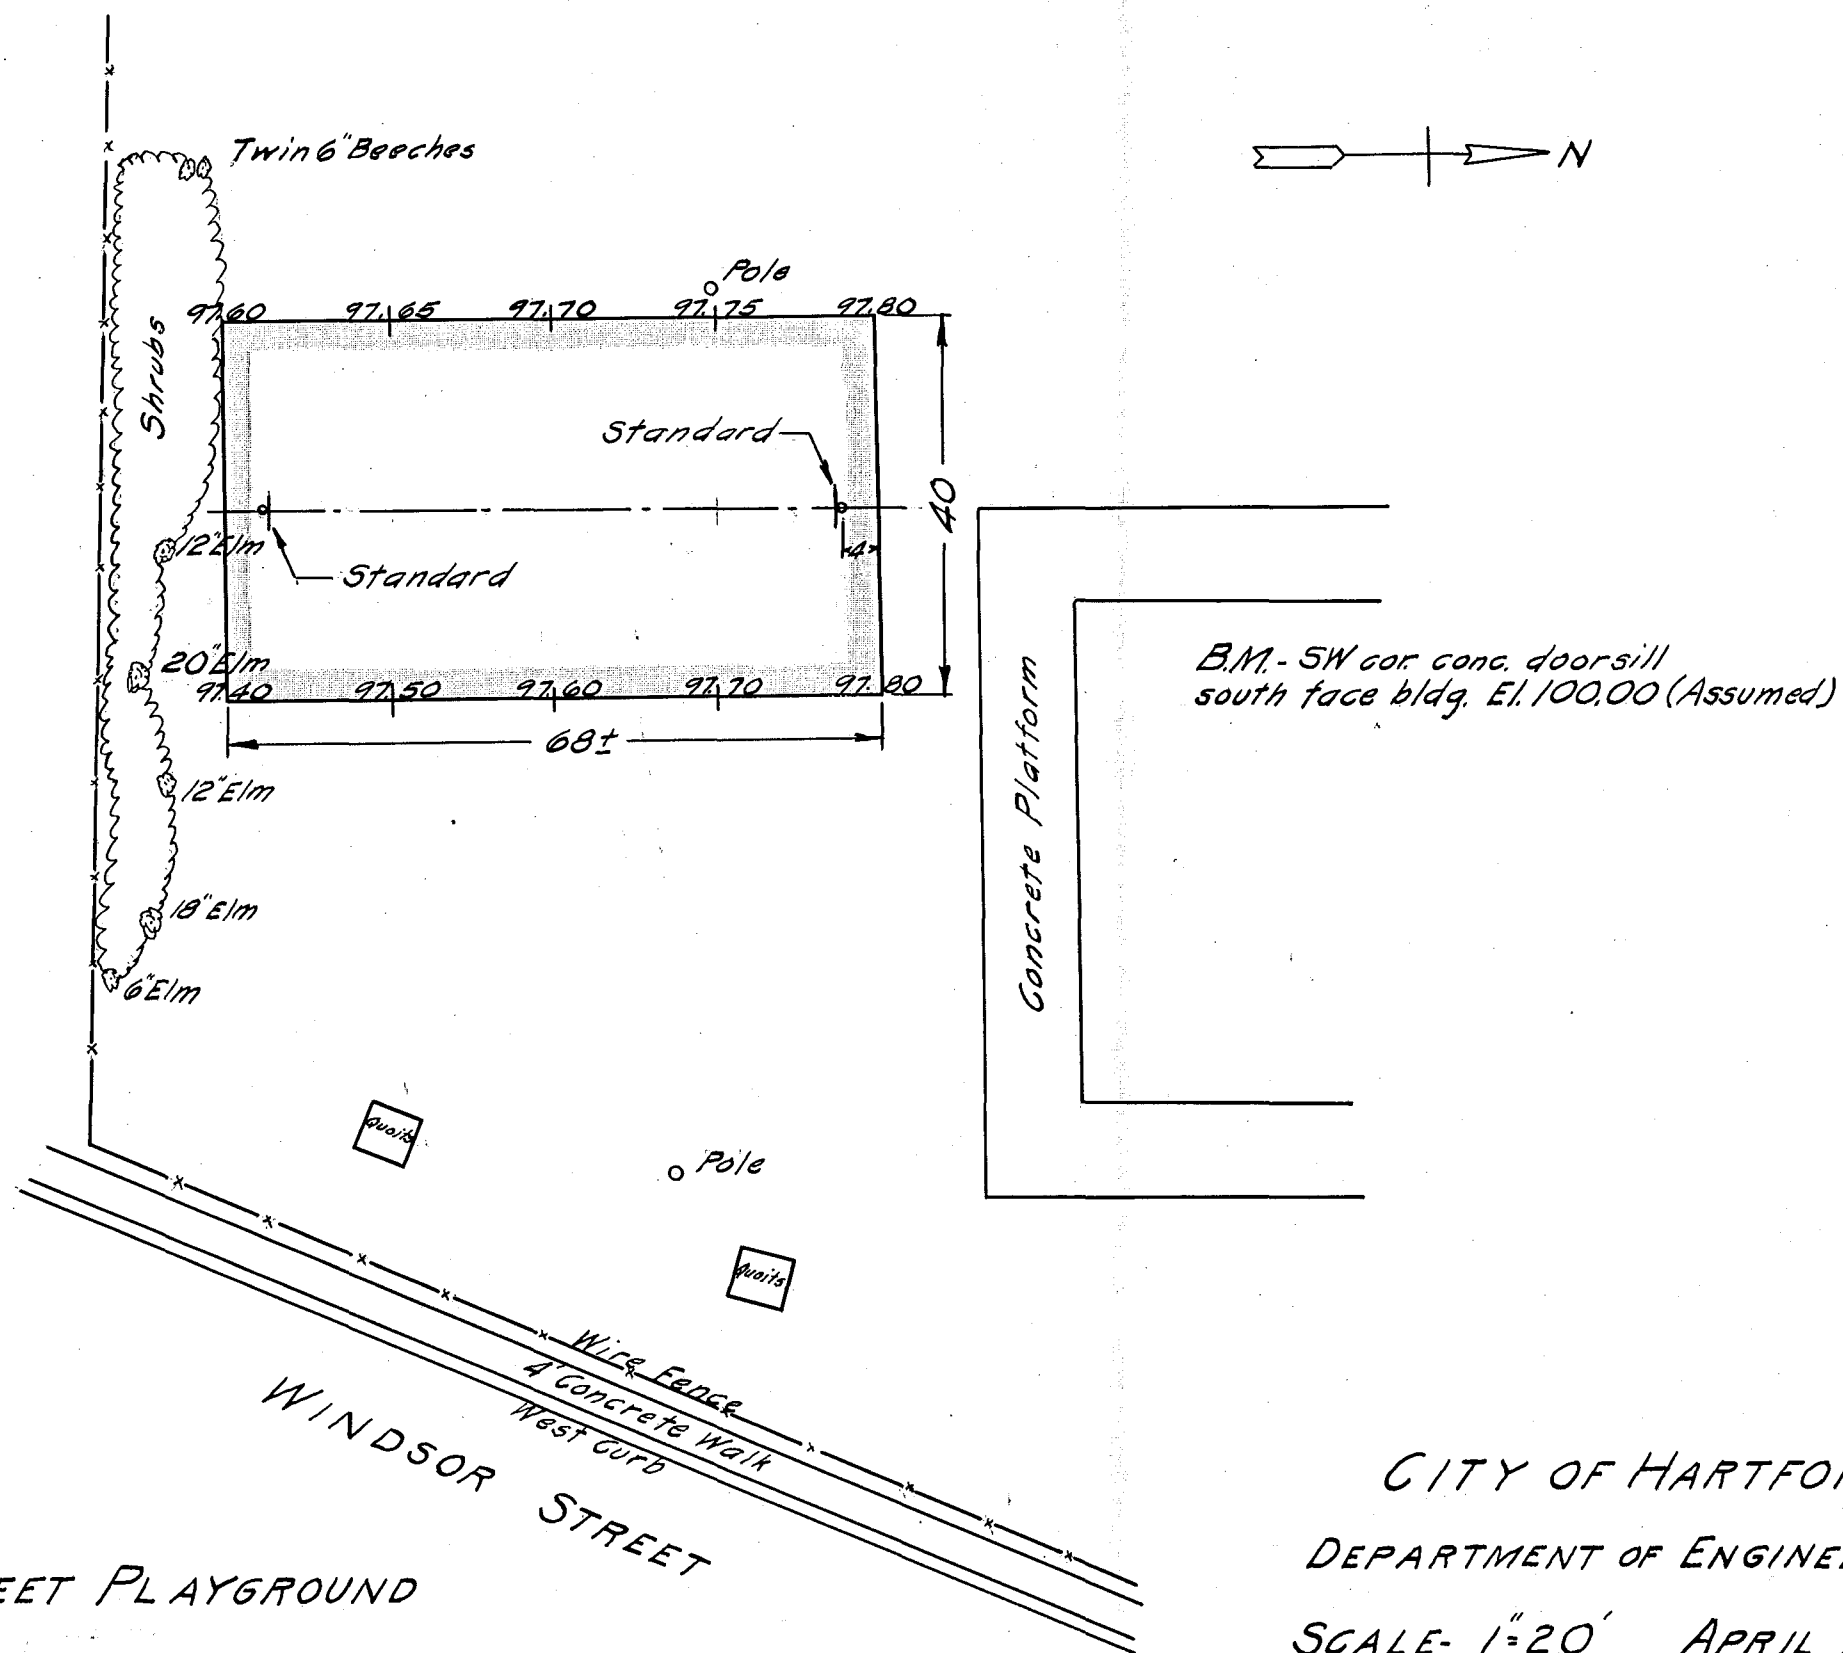

WINDSOR STREET PLAYGROUND

BASKETBALL COURT

CITY OF HARTFORD
DEPARTMENT OF ENGINEERING
SCALE- 1"=20' APRIL 1951
DAYBOOK No. 09148

CITY OF HARTFORD

DEPARTMENT OF ENGINEERING

SCALE- 1"=20' APRIL 1951

DAYBOOK No. 09/48