


Albany Dr



Westbound PKY

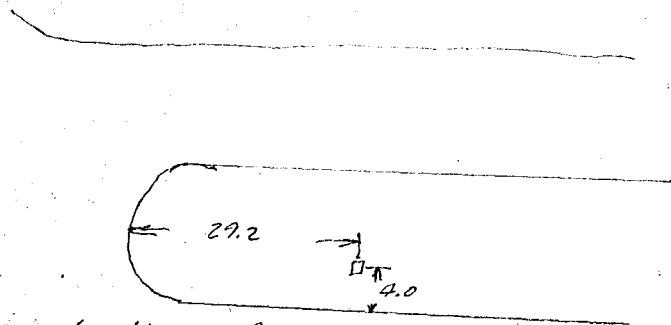