

CP-63C Middletown Quad
CONNECTICUT GEODETIC SURVEY
NEW HAVEN, CONN.

14-149A

DISTANCES AND DIRECTIONS TO REFERENCE MARKS

COMP. VOL.

STATION NO.: 2616

TOWN: Hartford

COUNTY: Hartford

DATE: Mar. 25, 1940

OBJECT	DIST. FT.	DIRECTION	PLANE AZIMUTH
Mon. #2610-	1197.33	0 00 00	0
R.M. #1	29.96	37 57 00	255 16 00.9
R.M. #2	33.46	103 24 00	
R.M. #3	69.05	297 57 00	
		PLANE COORDINATES (FEET)	ELEVATION FEET:
		X 619,974.78	
		Y 330,145.21	METERS:


STATION MARK IS U.S.C. & G.S. & STATE SURVEY BRONZE DISK
STAMPED: 2616, set in the top of a reinforced concrete
post, the top flush with the ground.

The station is on the south side of Preston Street and
100 feet west of Franklin Avenue. It is 8.6 feet east
of the east edge of the walk leading to the house at 97
Preston Street, and 0.3 foot south of the south edge of
the sidewalk on Preston Street.

R.M. #1: Southeast of station: The northwest rear corner
of a 3-storied red brick apartment house at #377 Franklin
Avenue.

R.M. #2: South of station: The northeast front corner of
a 2 $\frac{1}{2}$ -storied house at #97 Preston Street.

R.M. #3: Northeast of station: The southwest rear corner
of a 3-storied red brick apartment house at #369 Franklin
Avenue.

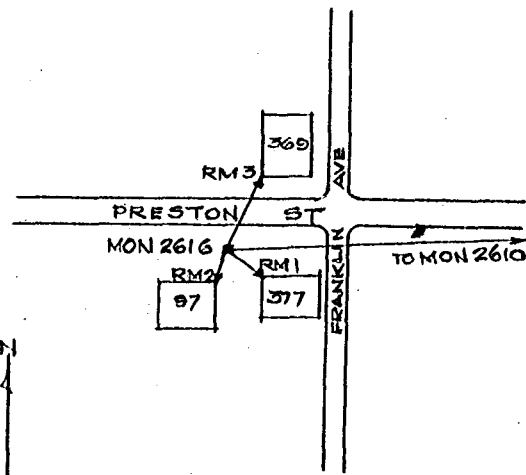

XXXXXX Preliminary Coordinates
XXXXXXXXXXXXXXXXXXXX

October 1959