

CP-63C MIDDLETOWN QUAD. FILE
CONNECTICUT GEODETIC SURVEY
NEW HAVEN, CONN.

#14-149

DISTANCES AND DIRECTIONS TO REFERENCE MARKS

COMP. VOL. 112

STATION NO.: 2615
TOWN: Hartford
COUNTY: Hartford
DATE: Mar. 25, 1940

OBJECT	DIST. FT.	DIRECTION	PLANE AZIMUTH
Mon. #2614	800.96	0 00 00	85 13 28.5
R.M. #1	60.61	45 47 00	
R.M. #2	55.04	157 41 00	
R.M. #3	40.71	279 56 00	

PLANE COORDINATES (FEET)	ELEVATION FEET:
X 612,136.50	
Y 327,880.94	
	METERS:


STATION MARK IS U.S.C. & G.S. & STATE SURVEY BRONZE DISK
STAMPED: 2615, set in the top of a reinforced concrete
post, the top flush with the ground.

The station is on the south side of US. #6A (New Britain
Avenue), and 50 feet west of the west sidewalk on Cumber-
land Street. It is between the sidewalk and the curb,
0.8 feet north of the north edge of the sidewalk, and
2.0 feet south of the curb.

R.M. #1: North of station: The top center of a fire hy-
drant, at the driveway leading to the house at #700 New
Britain Avenue.

R.M. #2: East of station: The center of a circular man-
hole cover, at the intersection of New Britain Avenue
and Cumberland Street, and 4 feet south of the south
trolley rail.

R.M. #3: South of station: The northwest corner (rear)
of the concrete foundation of the house at #3 Cumberland
Street.

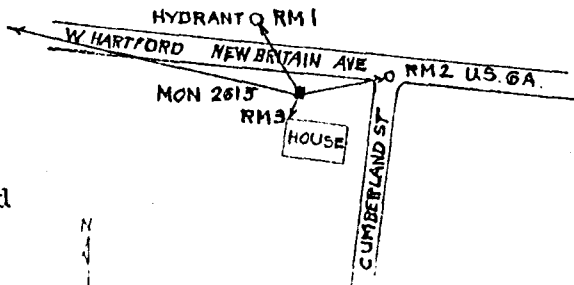

Add loc. by Dist 1 Dec '57

October 1959

032-26