

CP-63C MIDDLETOWN QUAD, FILE
CONNECTICUT GEODETIC SURVEY
NEW HAVEN, CONN.

#14-148

DISTANCES AND DIRECTIONS TO REFERENCE MARKS

COMP. VOL. 112

STATION NO.: 2614
TOWN: Hartford
COUNTY: Hartford
DATE: Mar. 25, 1940

OBJECT	DIST. FT.	DIRECTION	PLANE AZIMUTH
Mon. #2615	800.96	0 00 00	0 0 0
R.M. #1	82.31	182 25 00	265 13 28.5
R.M. #2	83.29	282 57 00	
Mon. #3193	710.85	0 00 00	70 04 02.8

PLANE COORDINATES (FEET)	ELEVATION
X 611,338.32	FEET:
Y 327,814.26	METERS:


STATION MARK IS U.S.C. & G.S. & STATE SURVEY BRONZE DISK
STAMPED: 2614, set in the top of a reinforced concrete
post, the top 2 inches below the ground.

The station is on the northeast side of U.S. #6A (New
Britain Avenue), and 80 feet east of the east sidewalk
on Clermont Street. It is between the sidewalk and the
curb, 0.8 feet south of the south edge of the sidewalk,
6.71 feet north of the curb, and 22 feet west of the
west edge of the walk leading to the house at #770 New

Britain Avenue.

R.M. #1: Northwest of station: The southeast corner of
the iron catch basin on the east side of Clermont Street,
and 5 feet north of New Britain Avenue.

R.M. #2: Northeast of station: The northwest corner
(rear) of the stone foundation of the house at #770 New
Britain Avenue.

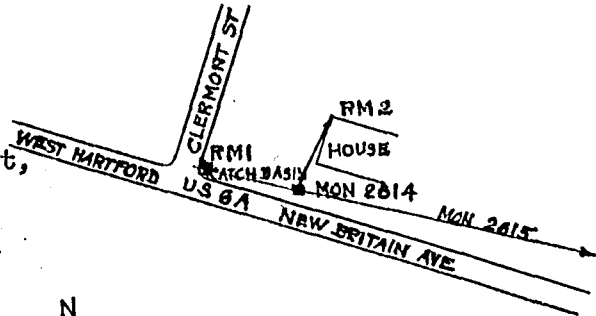

Possibly affected by Project 155-45
Dist 1 to re-reference Dec '57

October 1959

1132-27