

CP-63C MIDDLETOWN QUAD. FILE
CONNECTICUT GEODETIC SURVEY
NEW HAVEN, CONN.

#14-145

"DISTANCES AND DIRECTIONS TO REFERENCE MARKS

COMP. VOL. 101

STATION NO.: 2611
TOWN: Hartford
COUNTY: Hartford
DATE: July 31, 1940

OBJECT	DIST. FT.	DIRECTION	PLANE AZIMUTH
Mon. #2610-X	938.61	0 00 00	177 55 28.8
R.M. #1	19.36	149 12 20	
R.M. #2	40.08	242 37 20	
R.M. #3	66.40	320 00 00	
		PLANE COORDINATES (FEET)	ELEVATION
		X 620,861.88	FEET:
		Y 331,775.21	METERS:

STATION MARK IS U.S.C. & G.S. & STATE SURVEY BRONZE DISK


STAMPED: 2611, set in the top of a reinforced concrete post, the top flush with the ground.

The station is on the southwest corner of Wethersfield Avenue and Barker Street in the city of Hartford. It is 12 feet north of the north side of the house at #435 Wethersfield Avenue, 8 feet west of the Wethersfield Avenue curb, 7.5 feet south of the Barker Street curb, and 1.5 feet south of the intersection of the sidewalks.

R.M. #1: Southeast of station: The center of the top nut on the hydrant on the west side of Wethersfield Avenue, and 40 feet south of Barker Street.

R.M. #2: Southwest of station: The northeast corner of the concrete block foundation of the house at #435 Wethersfield Avenue.

R.M. #3: Northwest of station: The southeast corner of the stone foundation of the house at #427 Wethersfield Avenue.

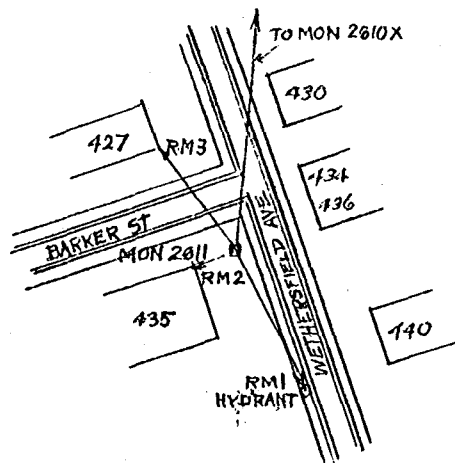

Monument lowered 0.750 feet May 9th 1947

September 1959