


Weth. Arc.

W Corb

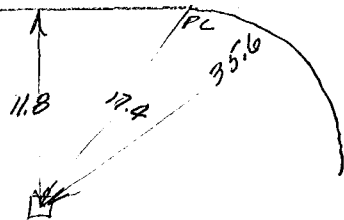

S.NET Co.



Bolton St