



0+0
1+39.5

22.21
Sewer M.H.

#56

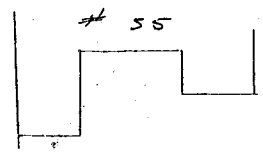

0+65.5 0+55
E. WALK

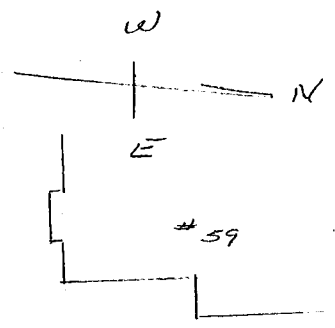

0+0