


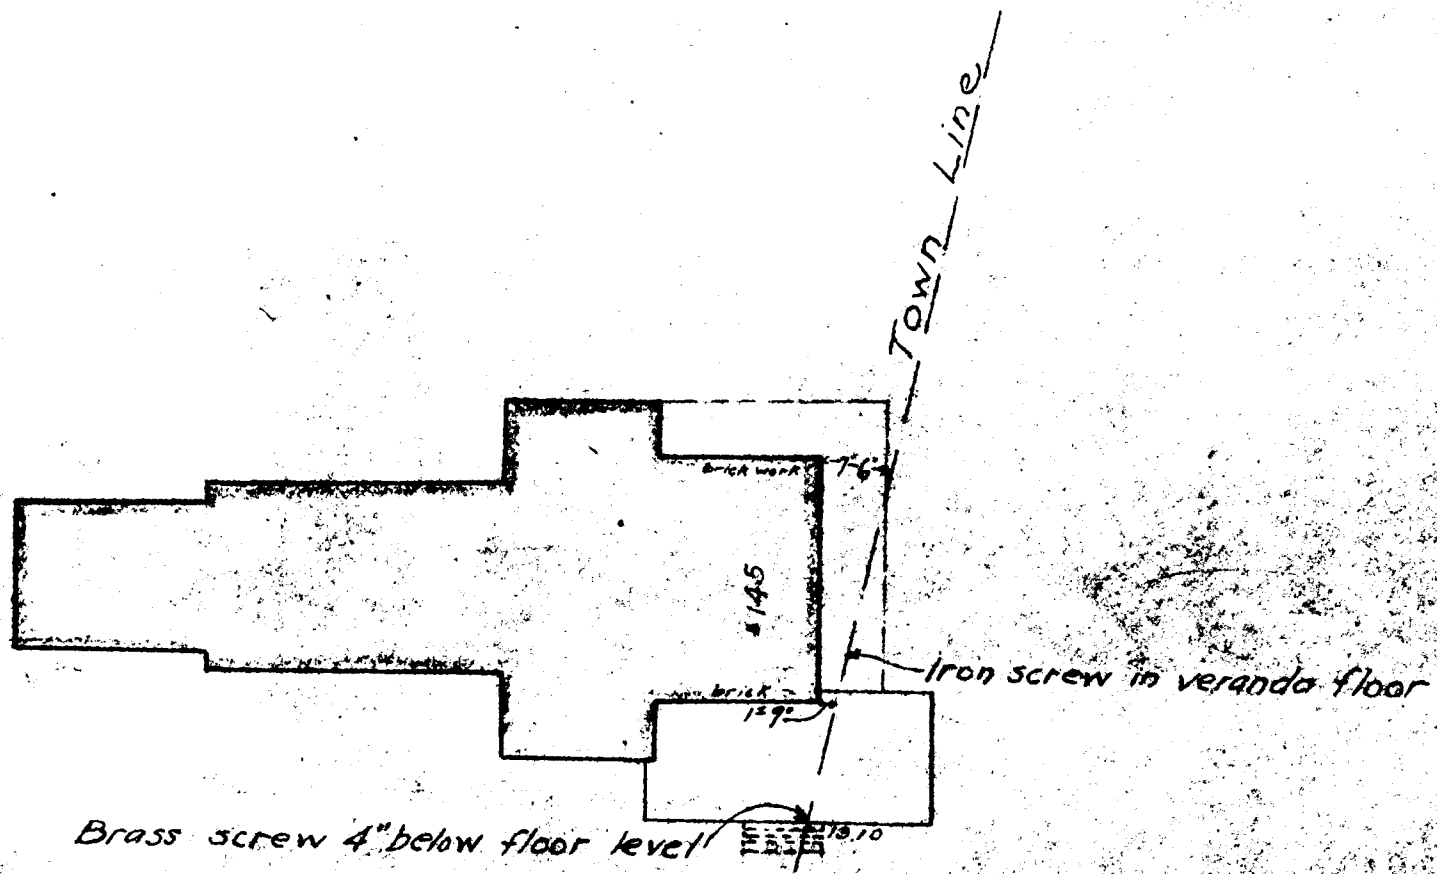

West line of Bloomfield Avenue

Jan 1923

Scale 1" = 20'