


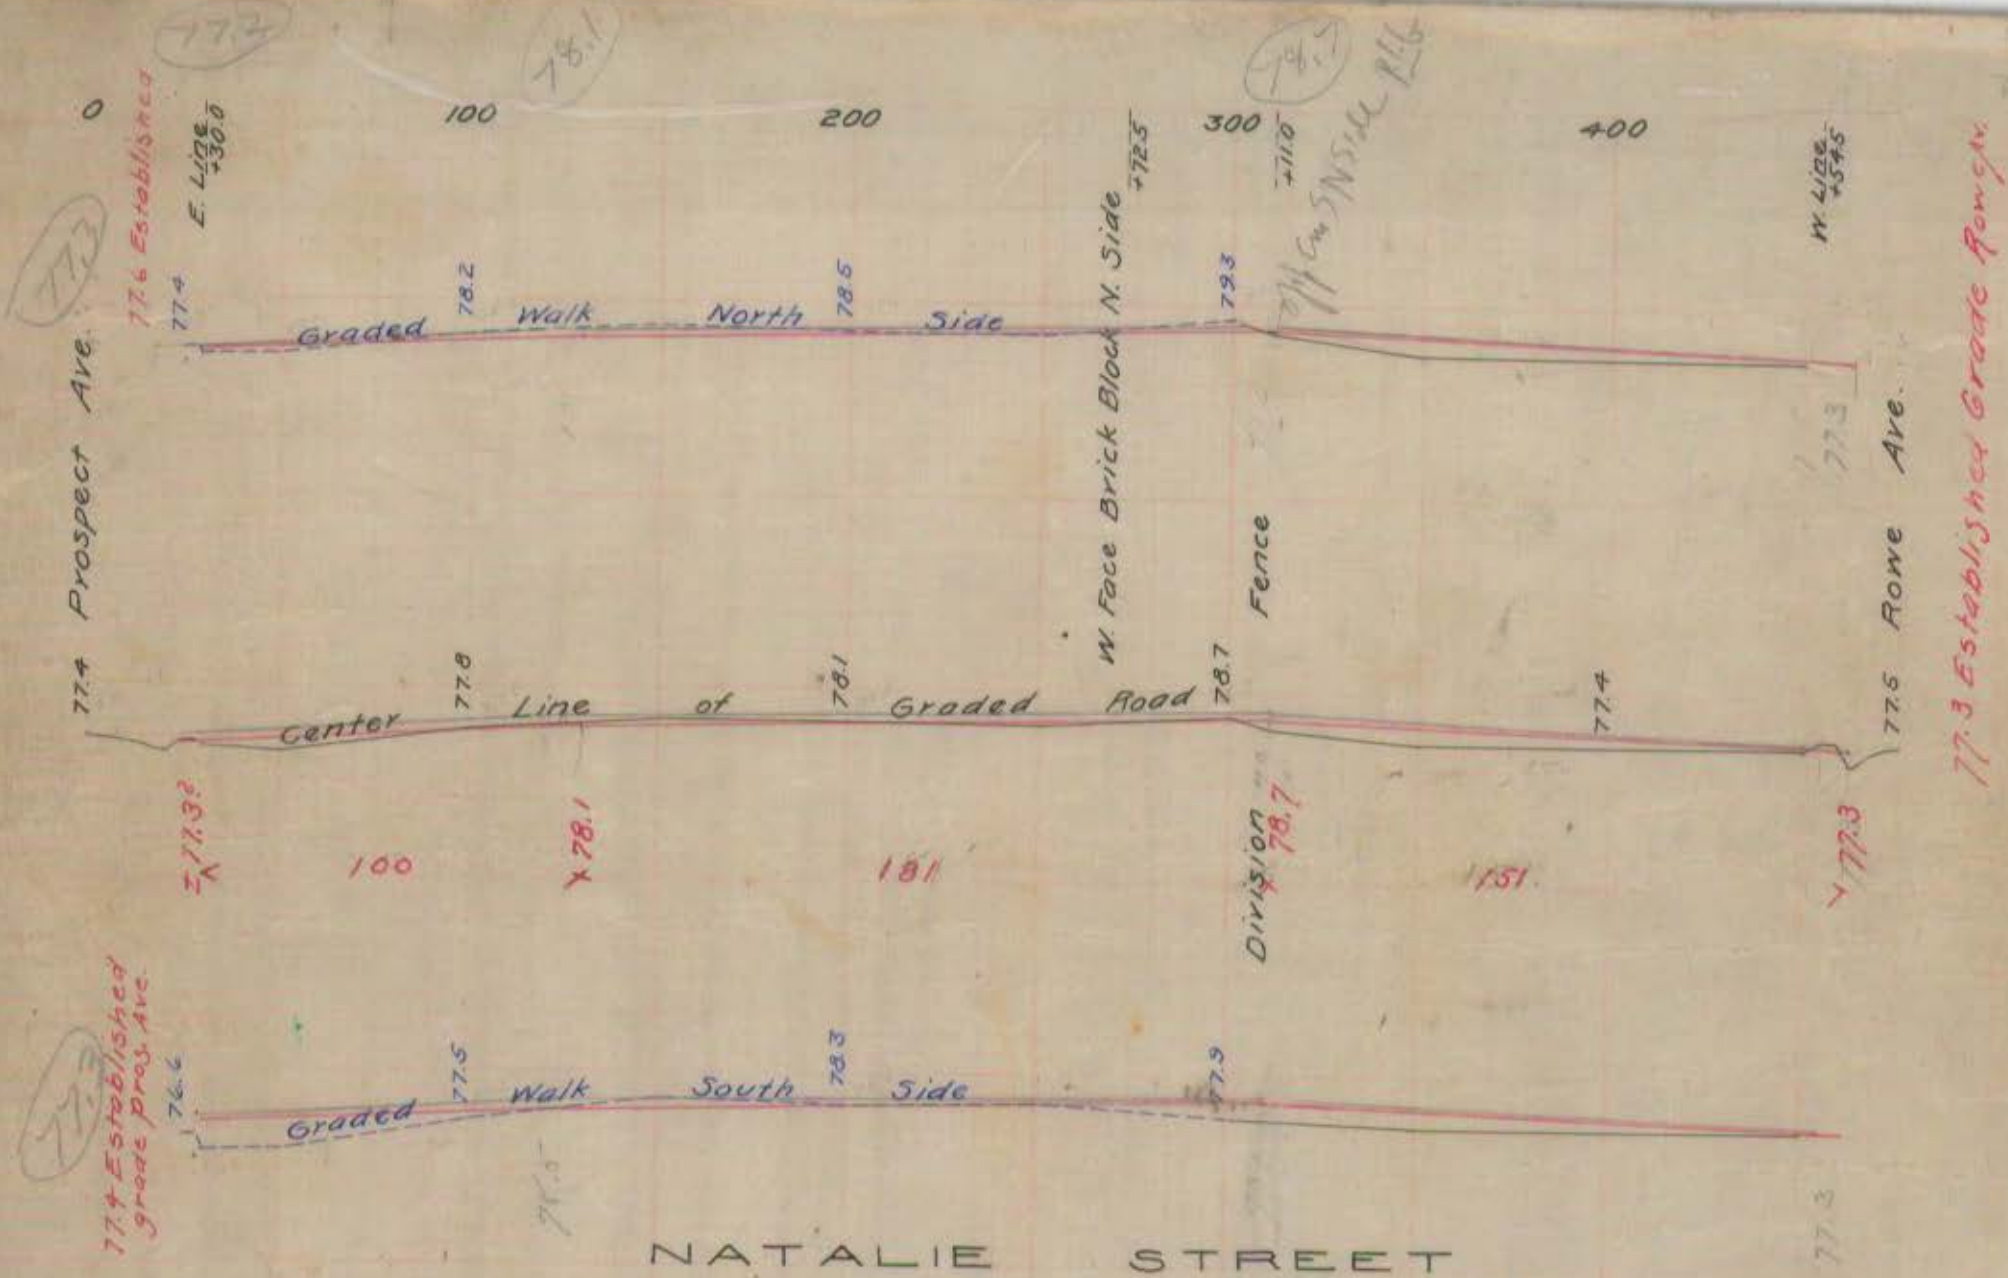

Comp 12 1/2
4 walk 8' out

13772
79.11

CITY ENGINEER'S OFFICE
HARTFORD, CONN.
STREET & MISCELLANEOUS DEPT.
Dec. 19, 1902 DIVISION 01324
Vol. 189 P.P. 39-40