


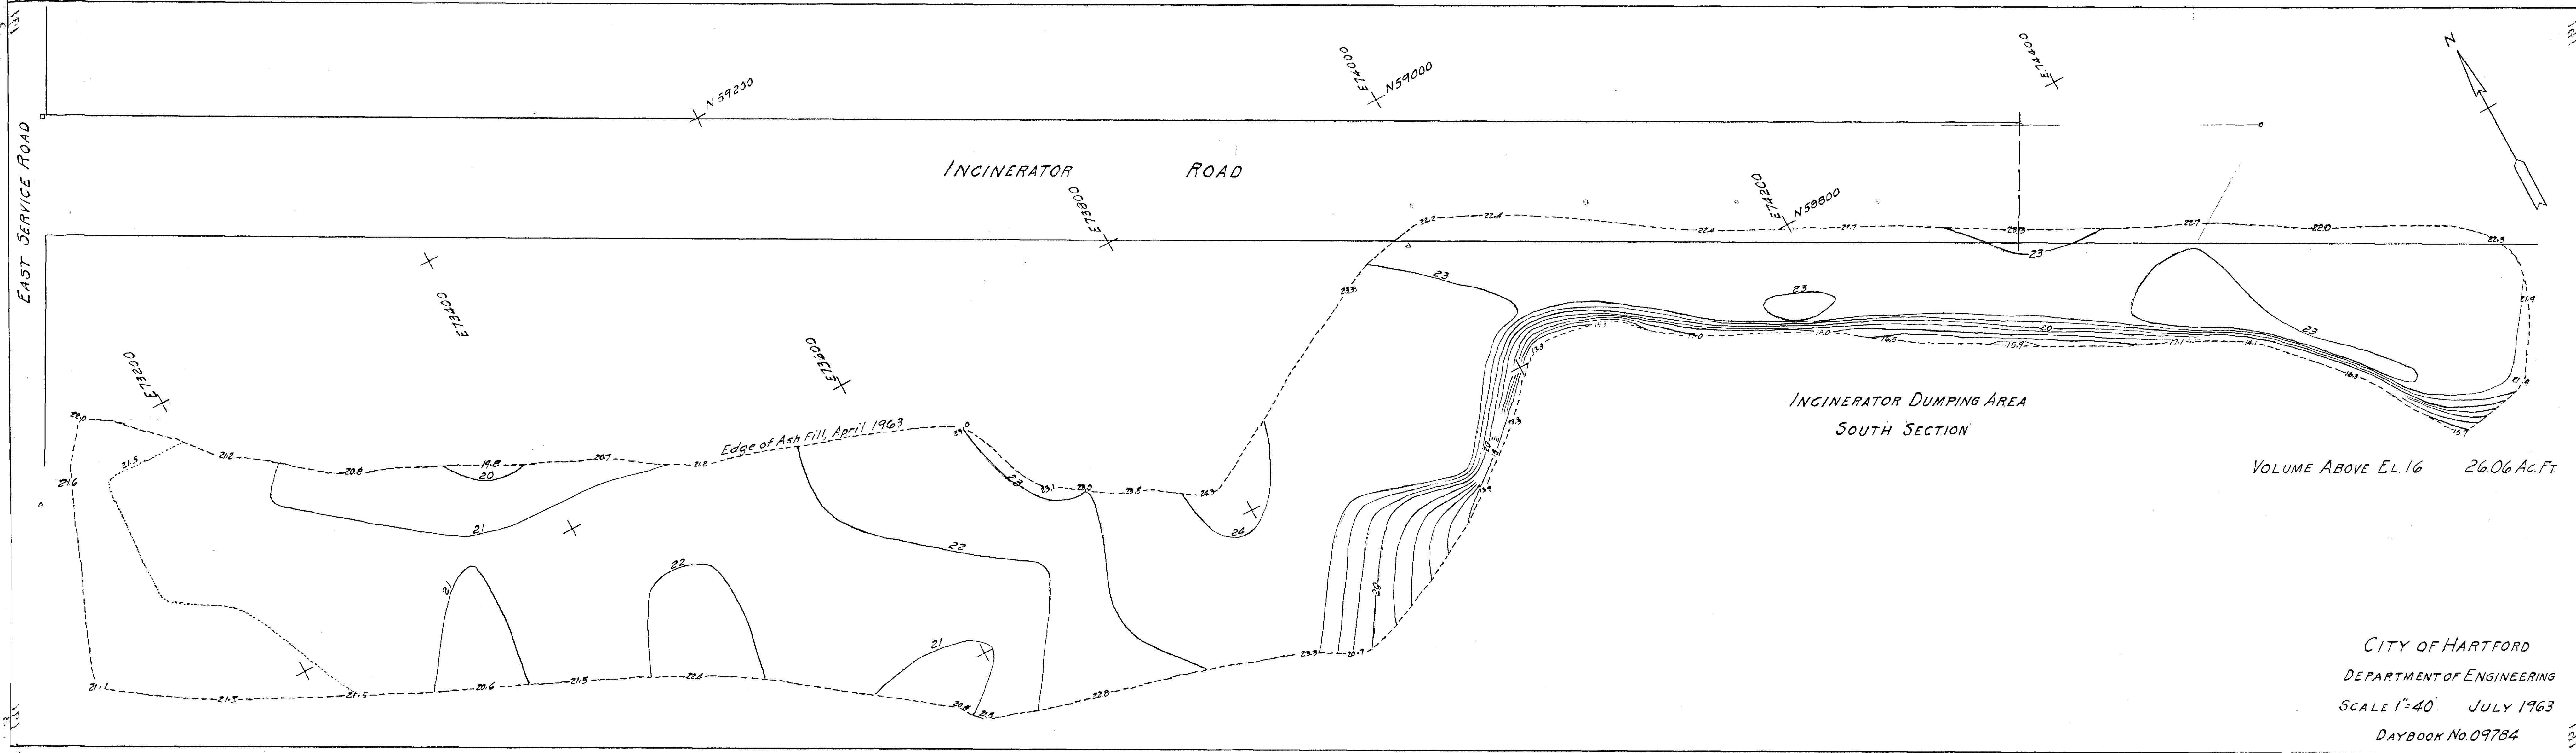

CITY OF HARTFORD
DEPARTMENT OF ENGINEERING
SCALE 1"=40' JULY 1963
DAYBOOK No. 09784