

12/11
008371 E
N 58800



N 58600

INCINERATOR ROAD

000400 E
142700

14+79.44
End of Layout

C.M.S.
16+38.52

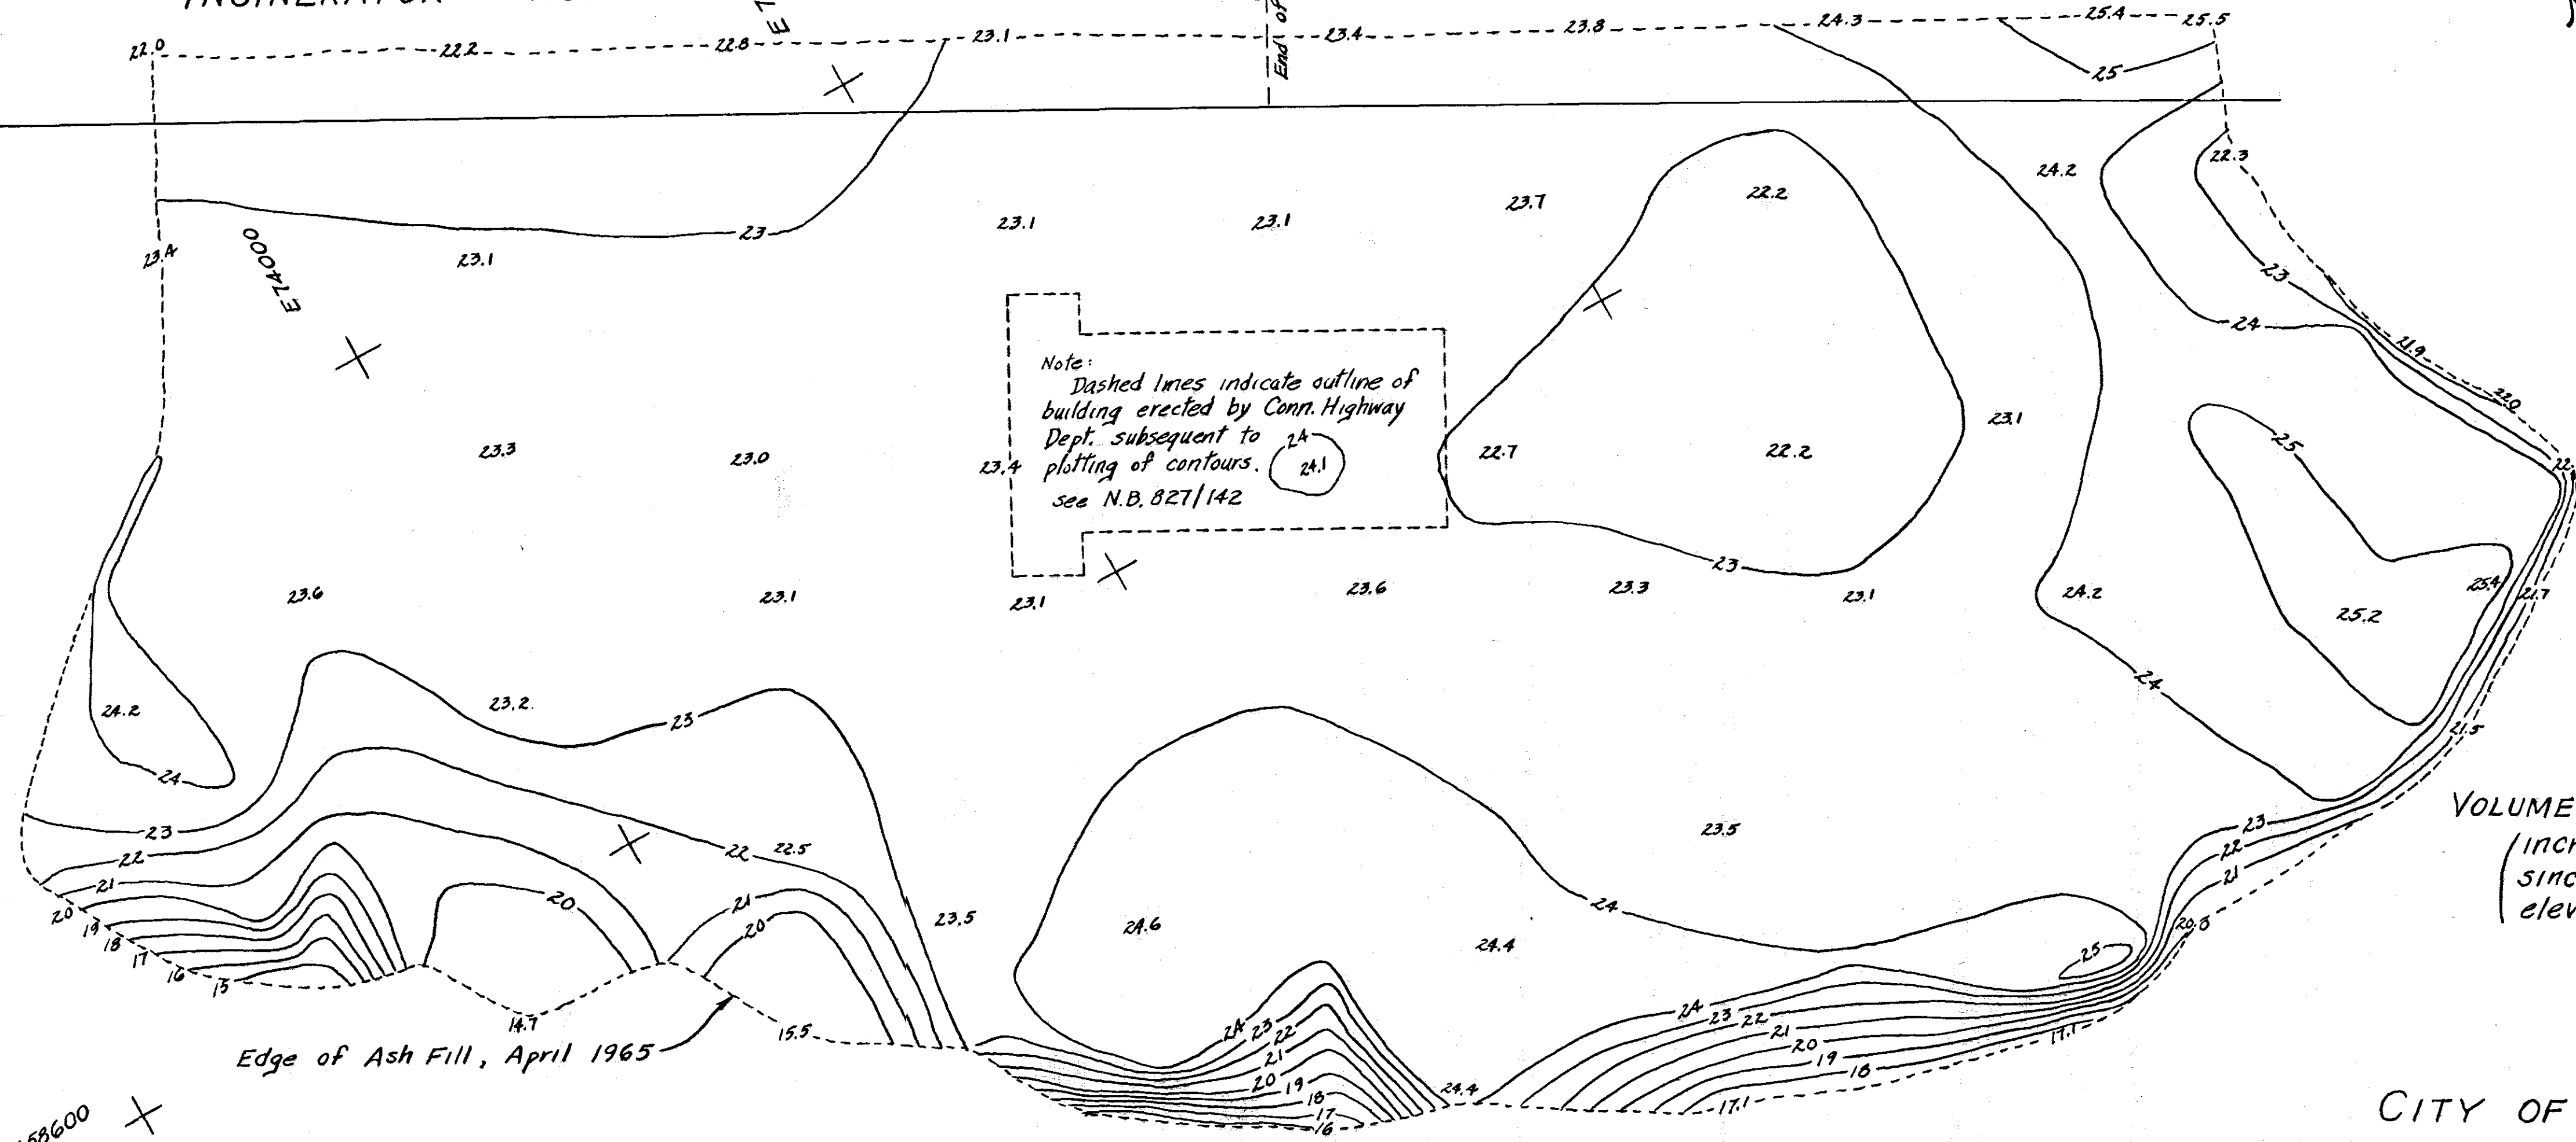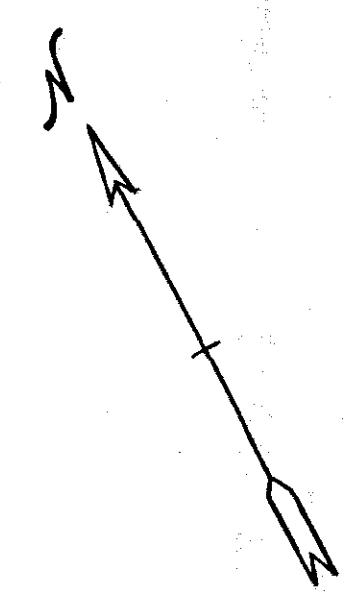

VOLUME 41.65 Ac. Ft.
(increase of fill volume
since April 1963 above
elevation 16)

INCINERATOR DUMPING AREA
SOUTH SECTION

CITY OF HARTFORD
DEPARTMENT OF ENGINEERING
Scale 1"=40' April 1965
Daybook No. 09881