


B.M. El. 91.14 Water table NW cor. house  
S.E. cor. Park and Putnam Sts.

B.M. El. 89.30 N end stone sill of rear door  
house # 69 Putnam St. S.W. cor. of New St

Putnam Heights  
5/136

Putnam Heights  
" Farm  
Now - Mortson St

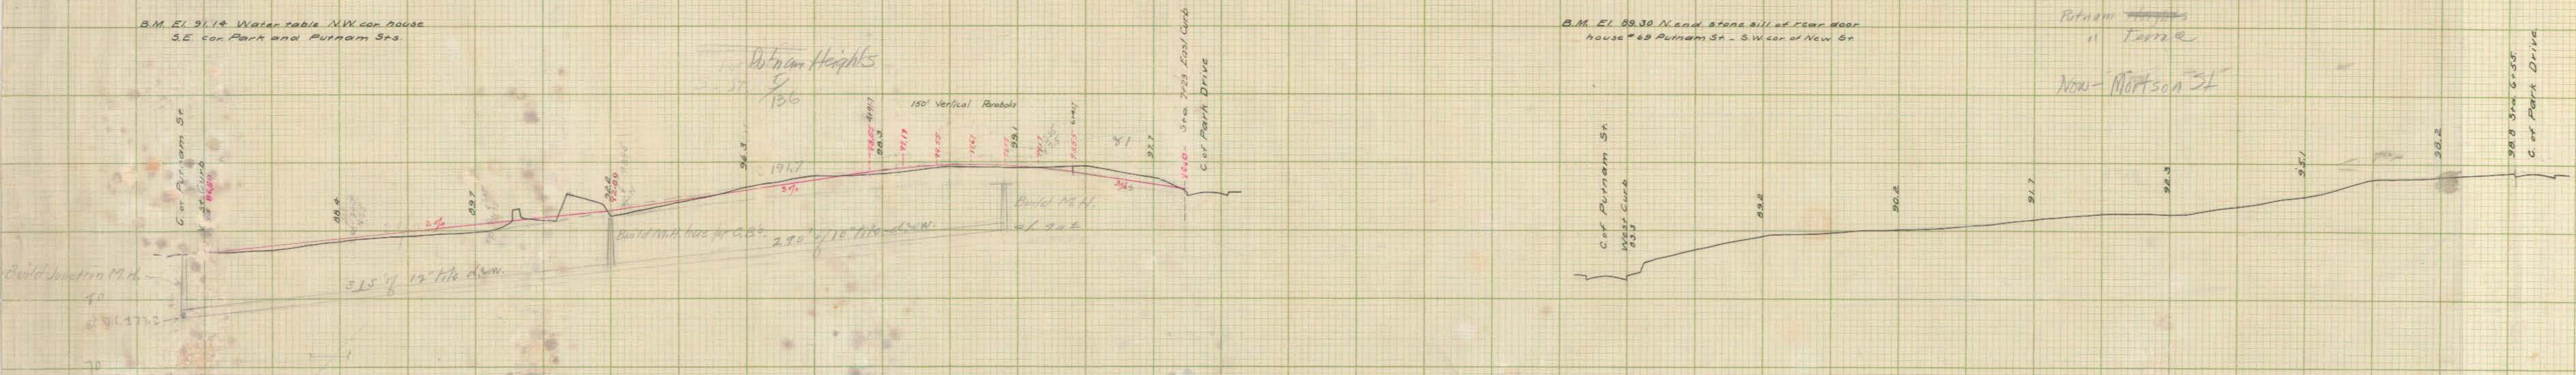

CITY ENGINEER'S OFFICE  
HARTFORD, CONN.  
STREET & MISCELLANEOUS DEPT.  
Date April 14-1900 Day Book No. 0852  
1900  
124-127  
City Engineer