


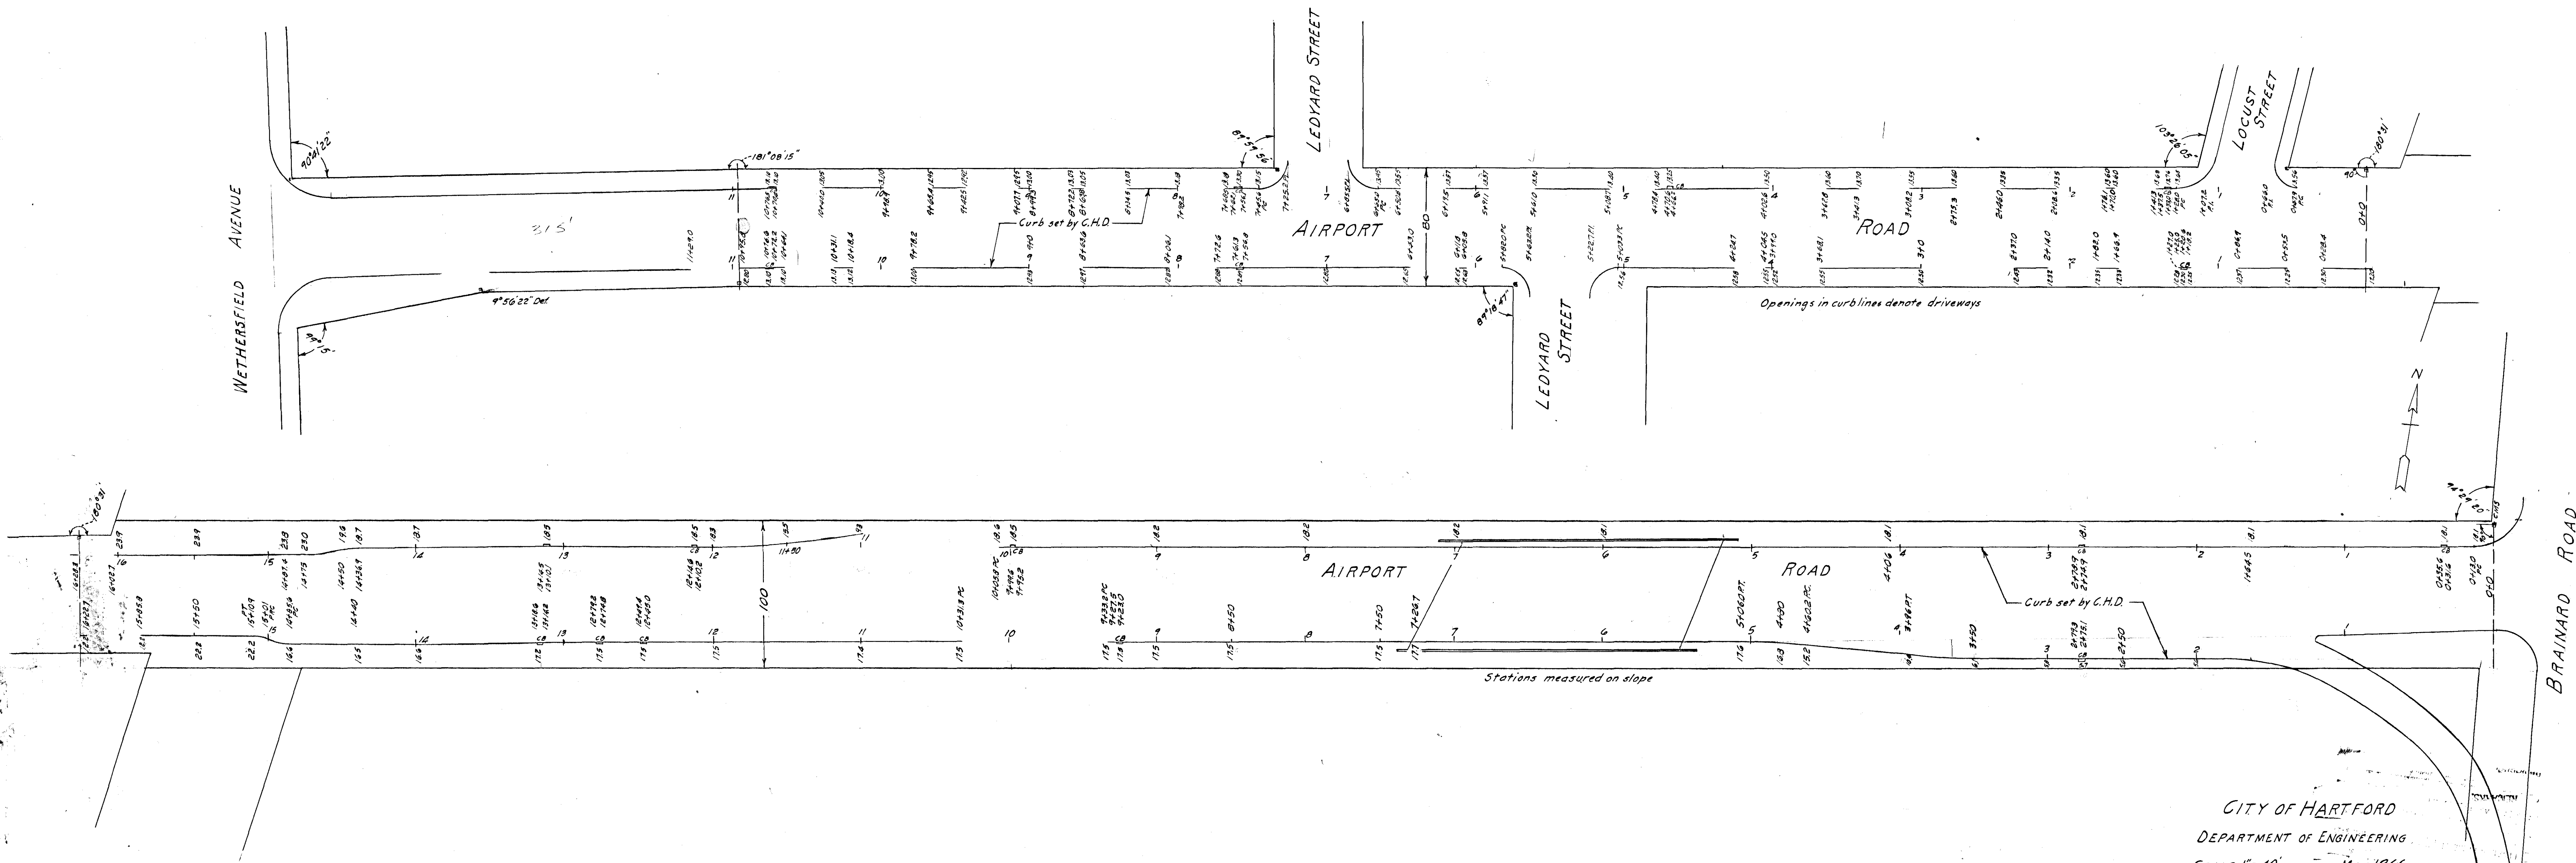

CITY OF HARTFORD
DEPARTMENT OF ENGINEERING
SCALE 1"=40' MAY 1966
DAYBOOK No. 09931

Notebook 826 1726