


10-B
103

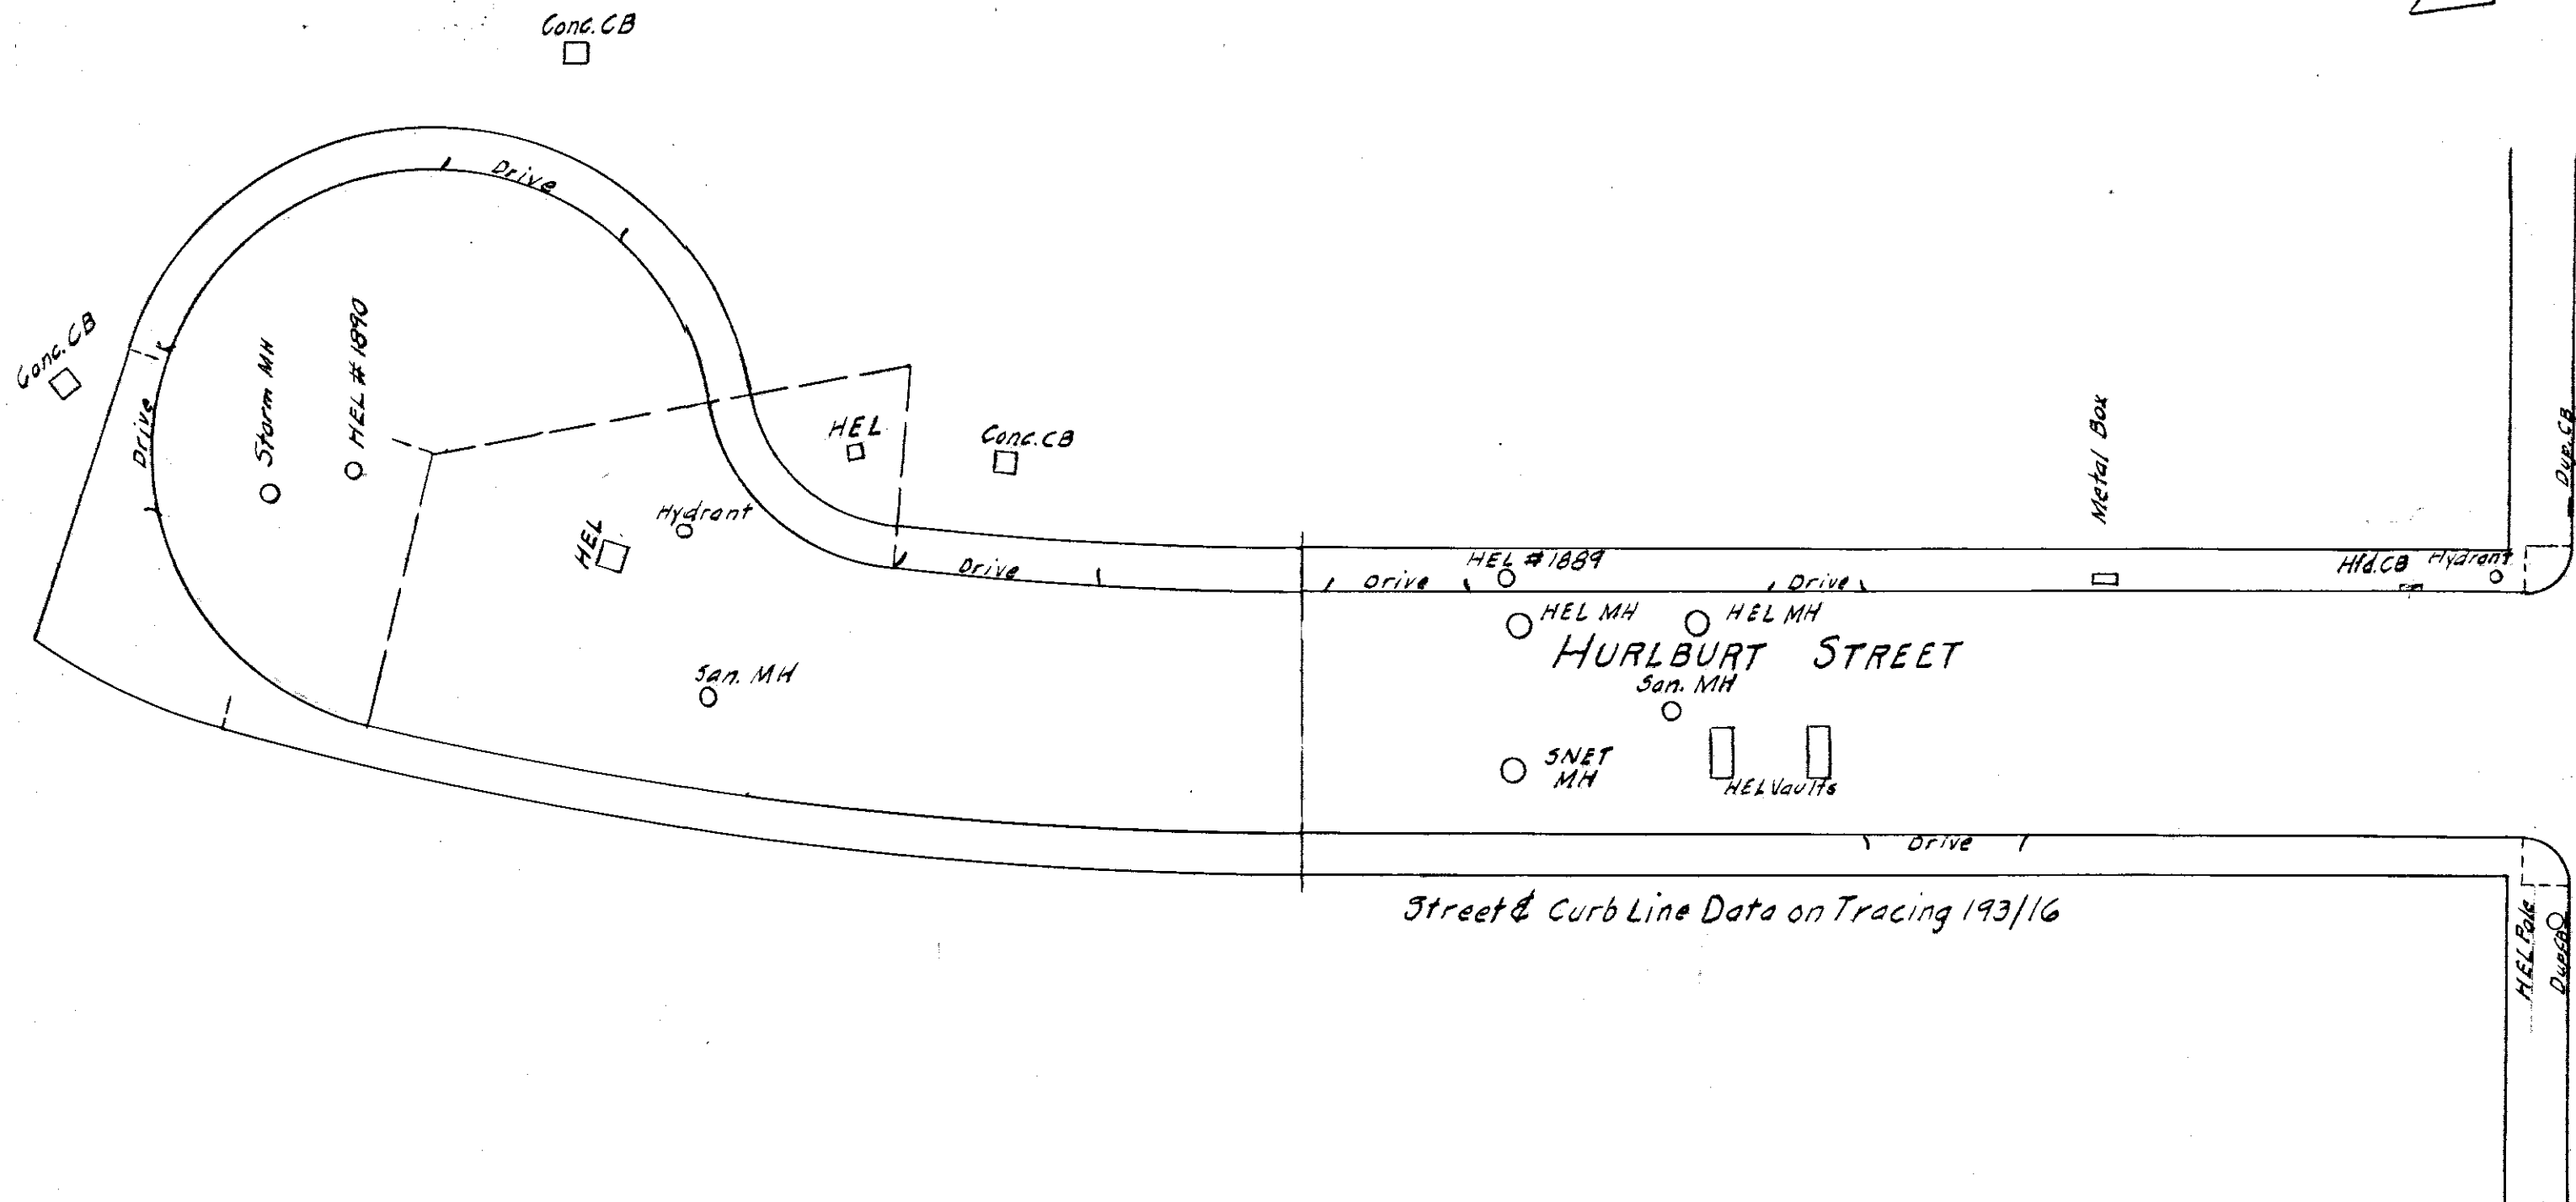

Street & Curb Line Data on Tracing 193/16

CITY OF HARTFORD
DEPARTMENT OF ENGINEERING
SCALE 1"=20' DECEMBER 1971
DAYBOOK No. 10038-B

Notebook 834, P.2

10-B
103