


MAP OF THE INTERSECTION OF
ALBANY AVENUE AND VINE STREET

SCALE 1"=10'

MAY 1911

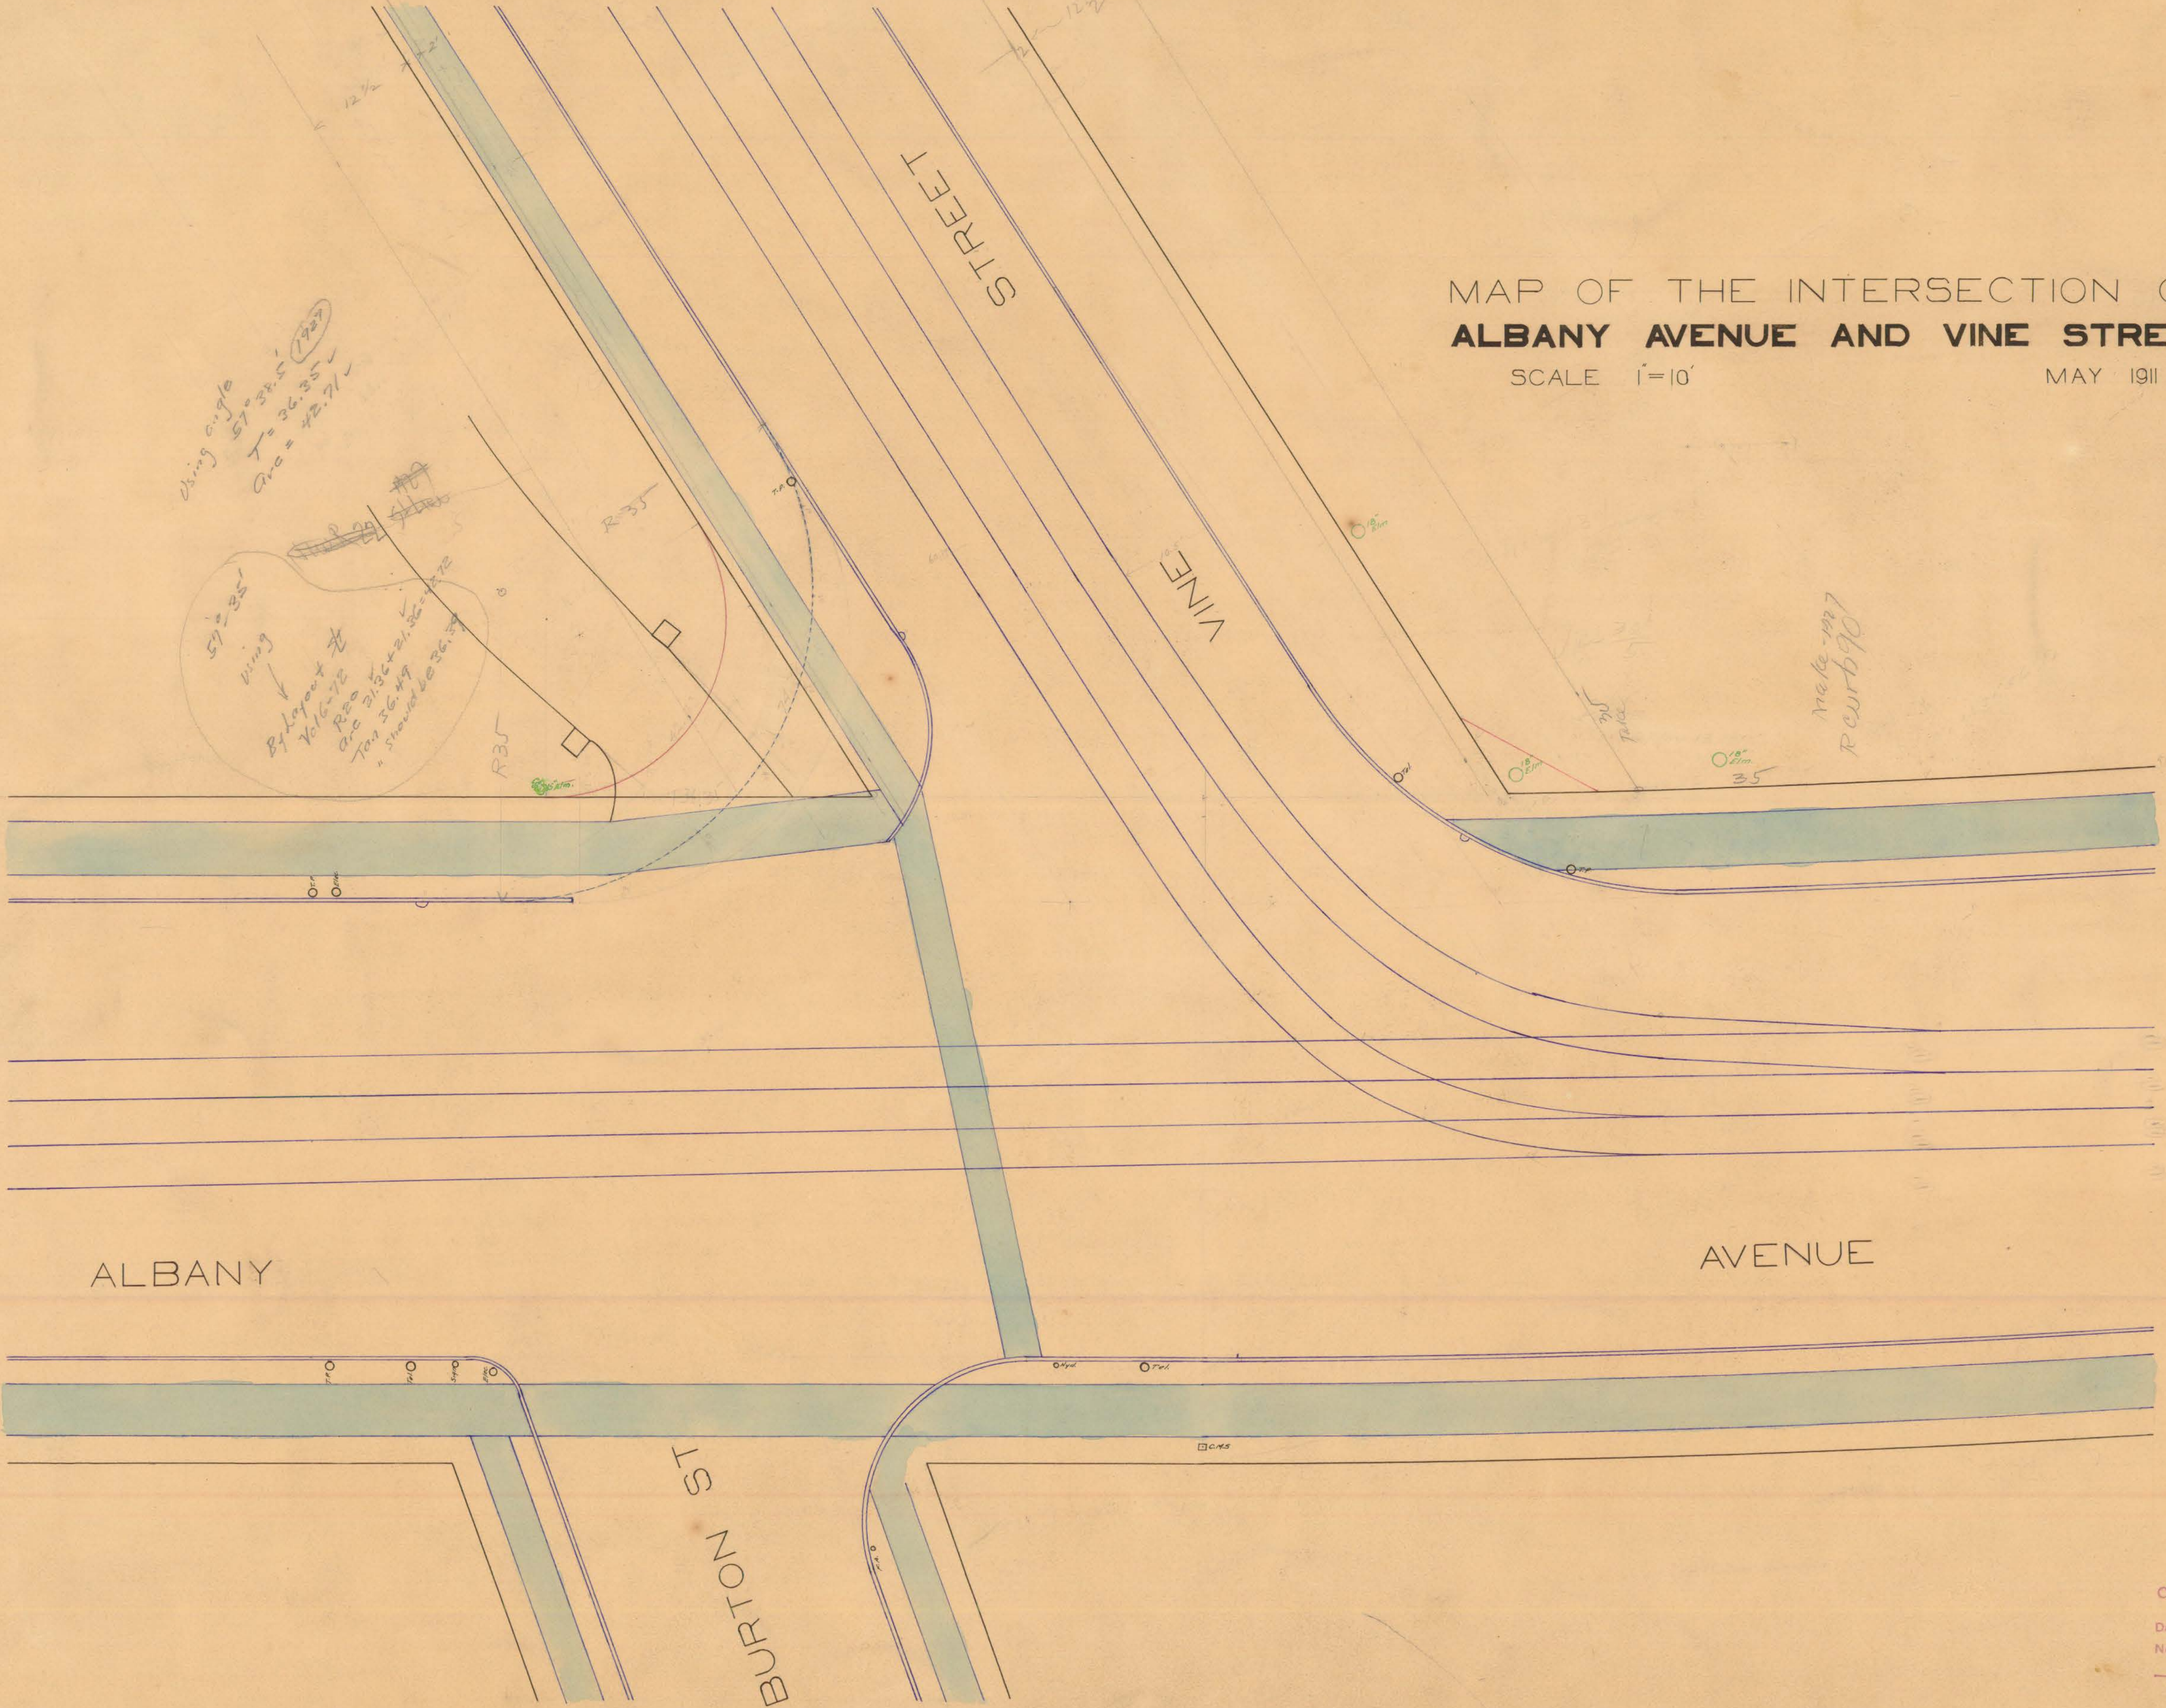

OFFICE OF CITY ENGINEER
HARTFORD, CONN.

Date May 1911 Day Book No. 02636

Notes 32 4-70

301
5