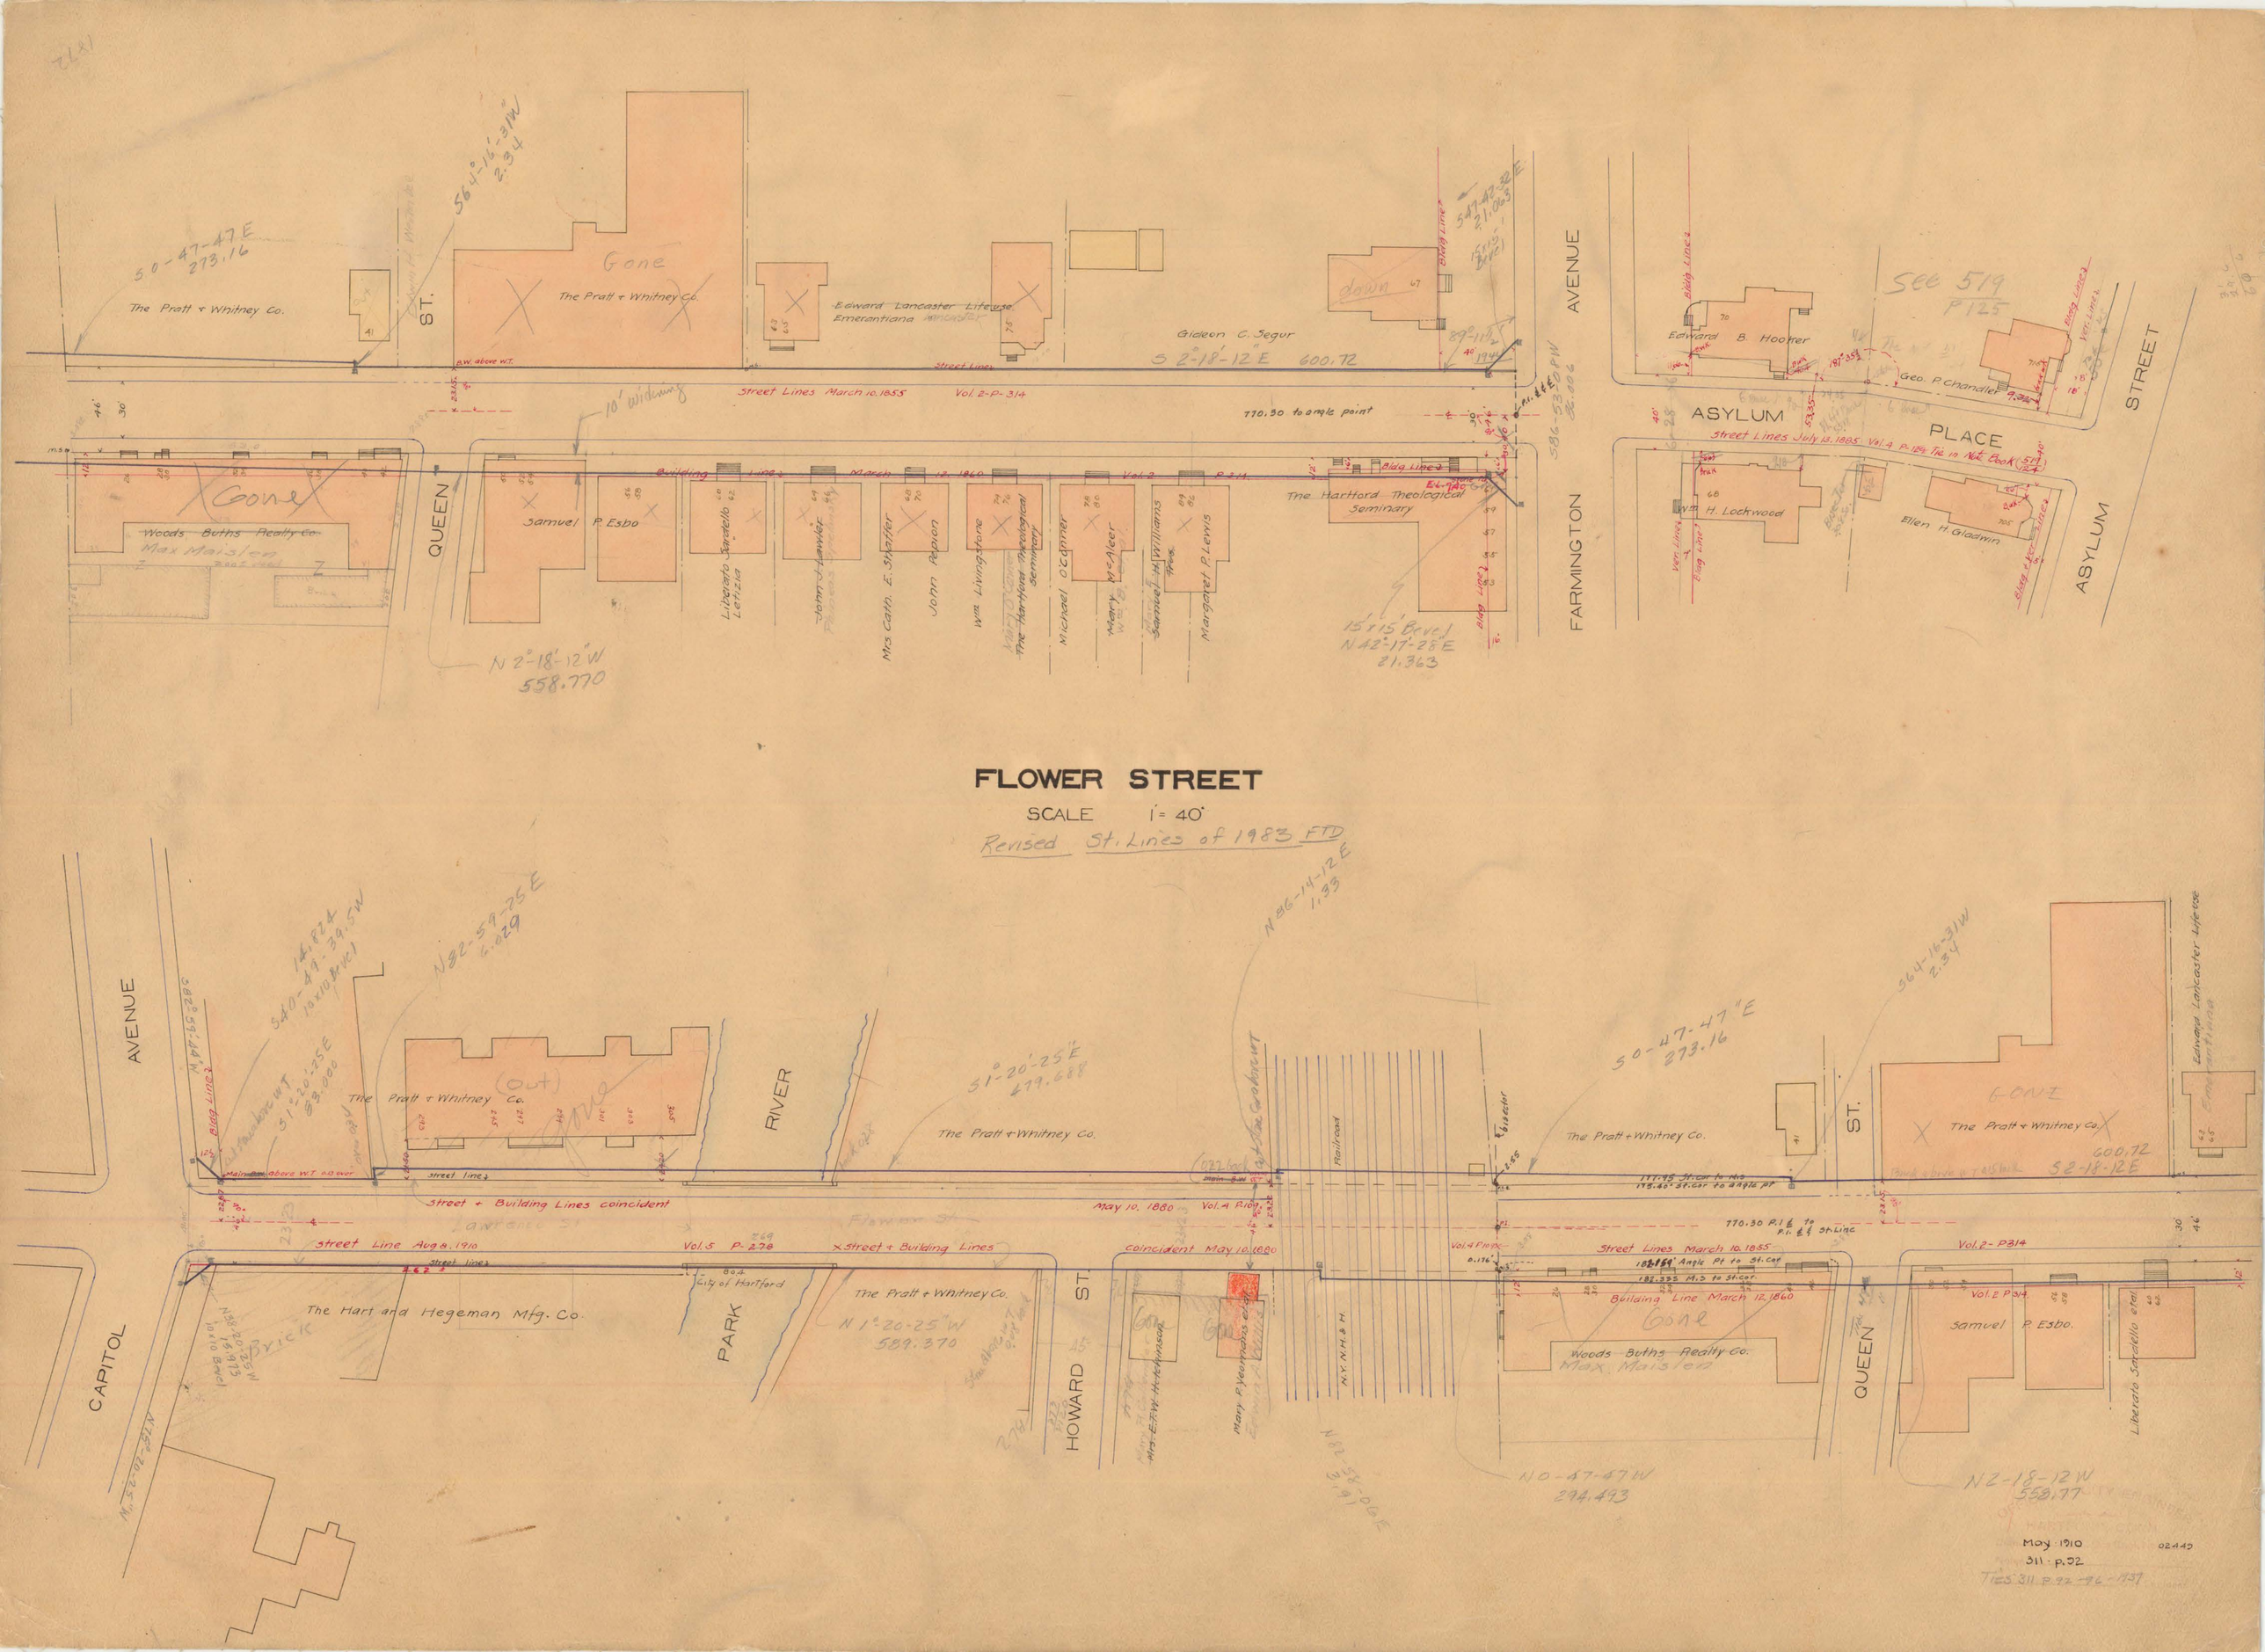
FLOWER STREET
SCALE 1" = 40'
Revised St. Lines of 1983 FTD
The Pratt + Whitney Co.
Gone
Edward Lancaster Life use
Emerantiana Wm Lancaster
Gideon C. Segur
S 2°-18'-12"E 600.72
Street Lines March 10. 1855 Vol. 2-P-314
770.30 to angle point
Building Lines March 12. 1860 Vol. 2 P. 314
The Hartford Theological Seminary
Woods Buths Realty Co.
Max Maisler
QUEEN
Samuel P. Esbo
Liberato Sardello
Letizia
John J. Lawler
Mrs Cath. E. Shaffer
John Pepion
Wm Livingstone
Michael O'Connor
Mary McAleer
Samuel H. Williams
Margaret P. Lewis
N 2°-18'-12"W 558.770
15'x15' Bevel N 42°-17'-28"E 21.363
FARMINGTON AVENUE
ASYLUM PLACE
ASYLUM STREET
Edward B. Hoover
Geo. P. Chandler
Wm H. Lockwood
Ellen H. Gladwin
See 519 P 125
Street Lines July 13. 1885 Vol. 4 P. 124 Tax Id. Note Book (519/127)
AVENUE
CAPITOL
The Hart and Hegeman Mfg. Co.
PARK
RIVER
The Pratt + Whitney Co.
Street + Building Lines coincident
May 10. 1880 Vol. 4 P. 109
Street Line Aug 9. 1910 Vol. 5 P. 278
Street + Building Lines coincident May 10. 1880
City of Hartford
N 1°-20'-25"W 589.370
HOWARD ST
Mrs E.F.W. Hutchinson
Mary Pyeroft
N.Y. N.H. & H.
Railroad
Street Lines March 10. 1855
Building Line March 12. 1860
770.30 P.I. to P.I. of St. Line
Vol. 2-P314
Samuel P. Esbo.
Liberato Sardello et al
N 0°-47'-47"W 294.493
N 2°-18'-12"W 558.77
May 1910
311 - P. 92
Tics 311 P. 92-96-137