


44
5
37
17.5
3.8
10.1
17.5
26.6

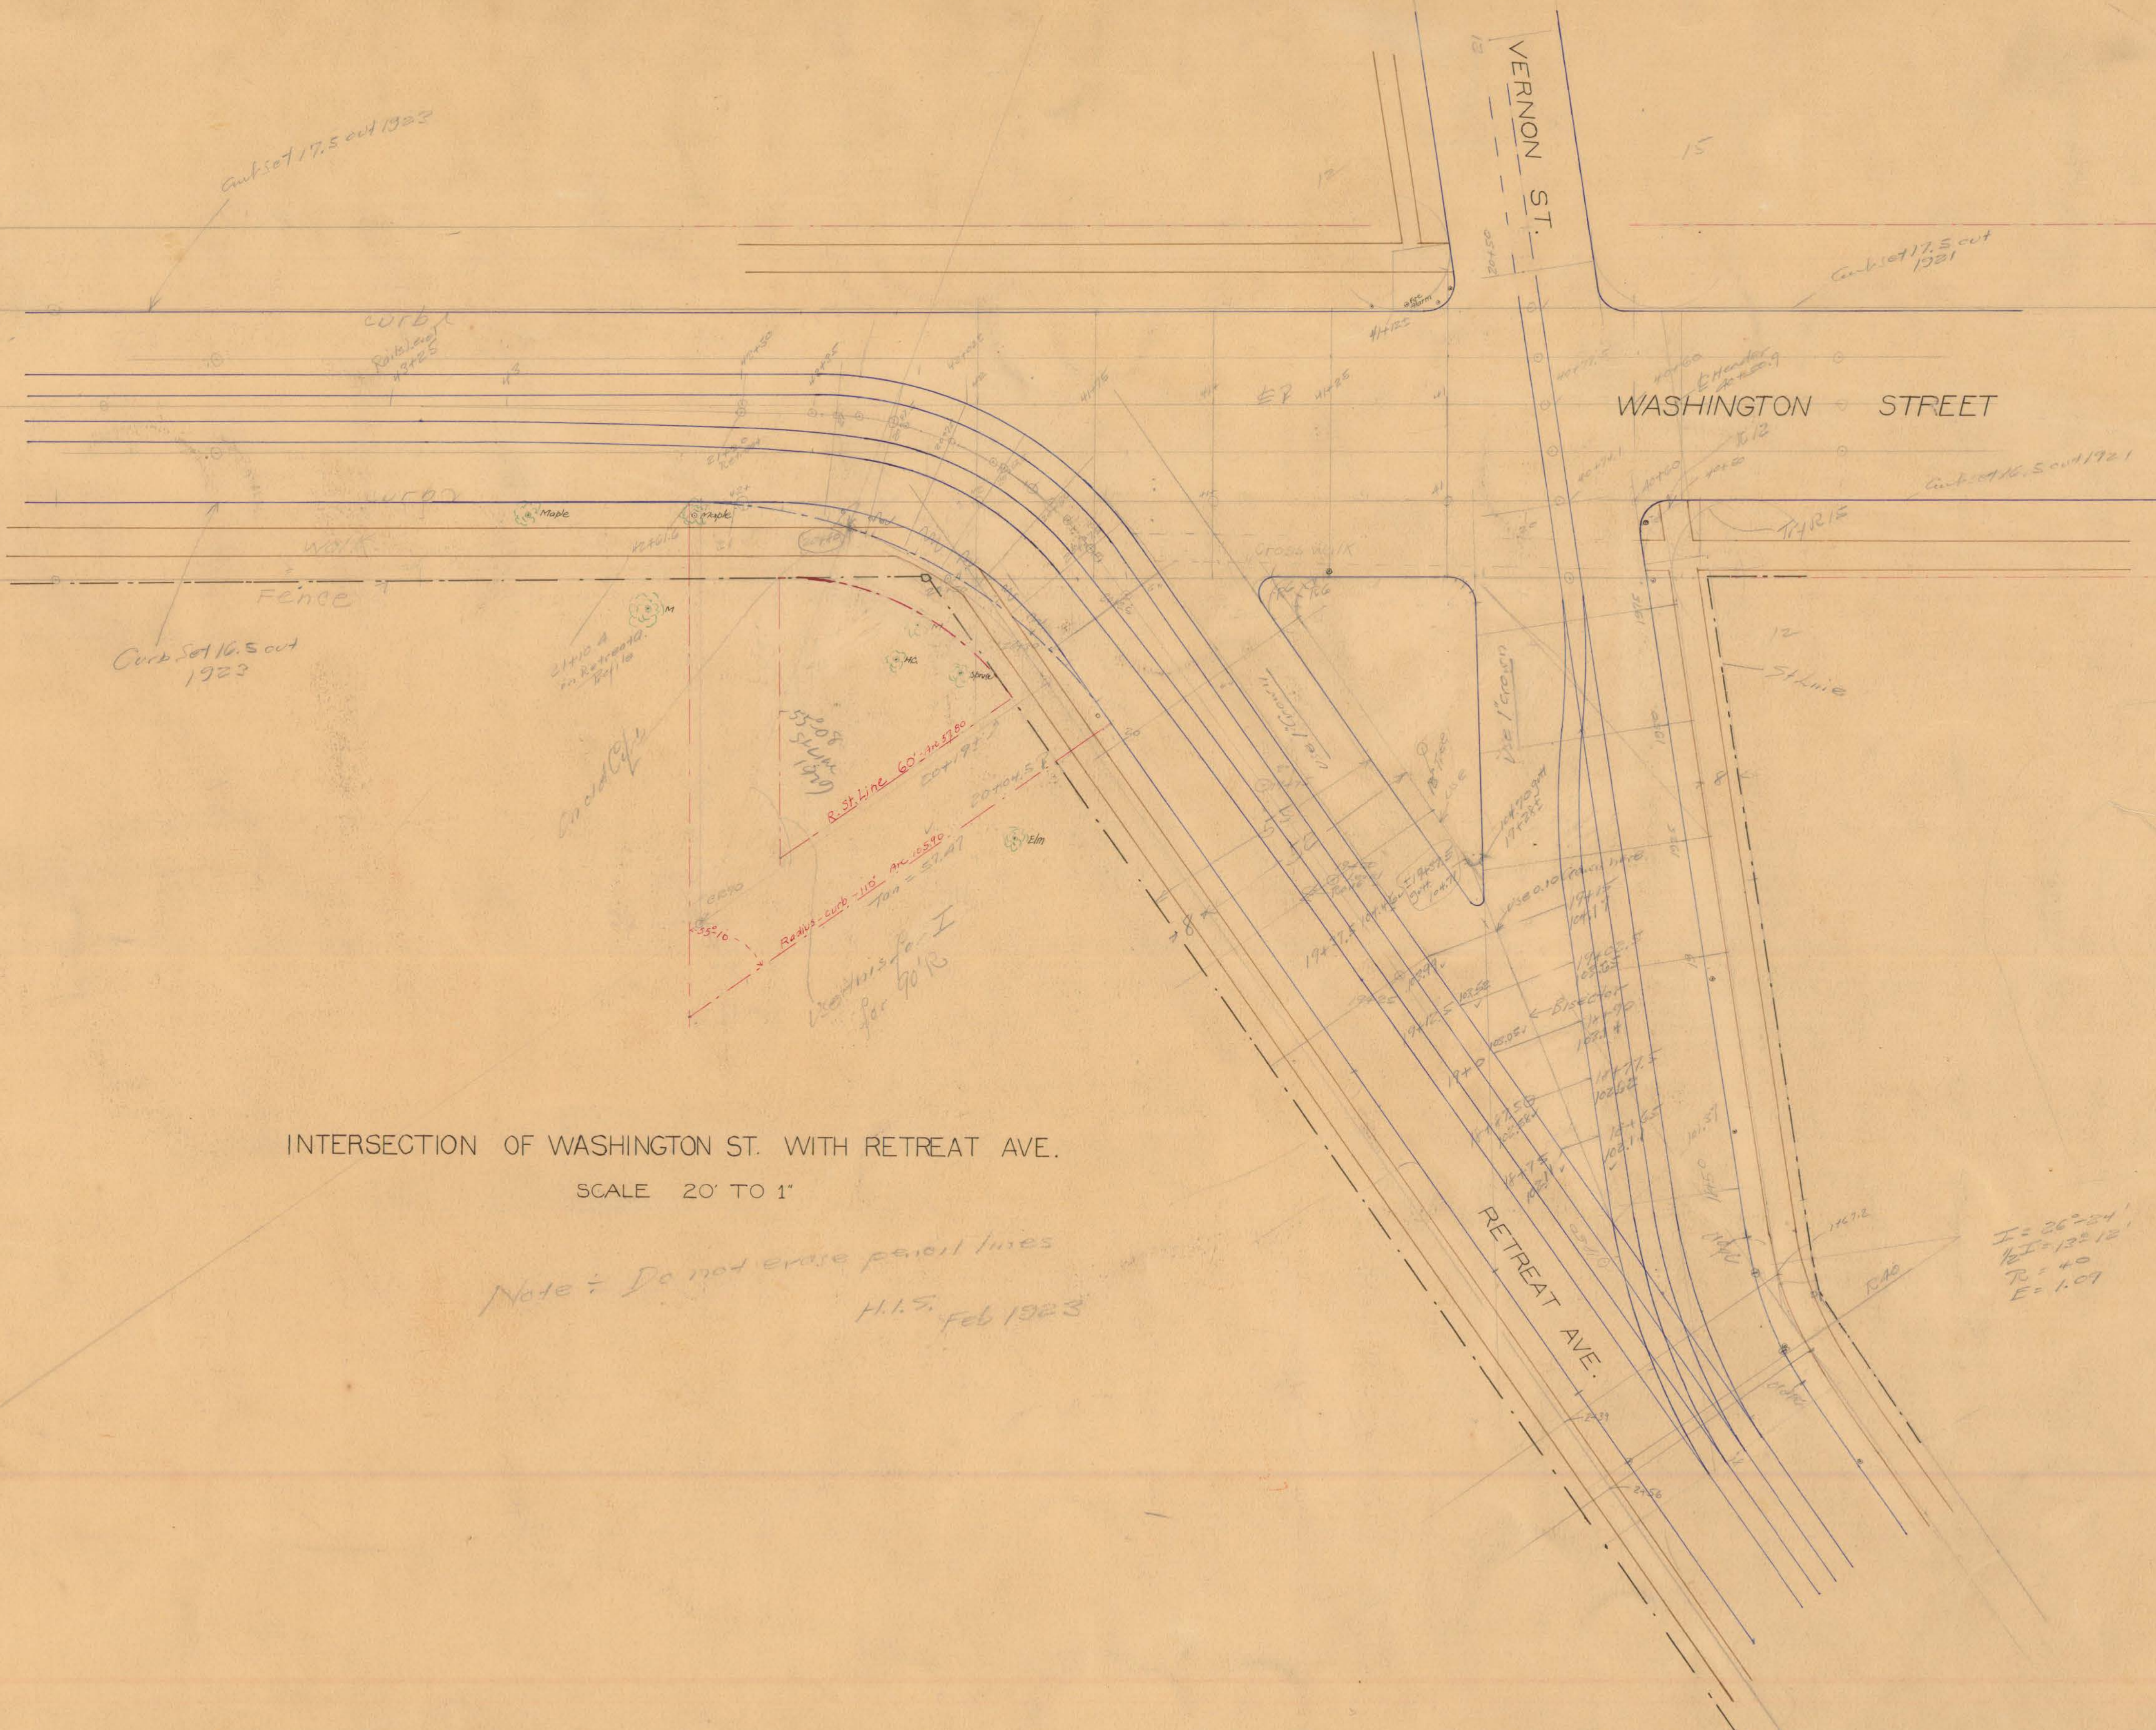

INTERSECTION OF WASHINGTON ST. WITH RETREAT AVE.

SCALE 20' TO 1"

Note: Do not erase pencil lines
H.I.S. Feb 1923

OFFICE OF CITY ENGINEER
HARTFORD, CONN.
Date July-1927 Day Book No. 01253
Notes 301 - 120-3
F.L. Ford City Engineer