

SHERMAN ST

FARMINGTON AVE


Ver Line 2

Building Line of 1912


But V. Line 2

Proposed East Street Line 1

SISSON AVE

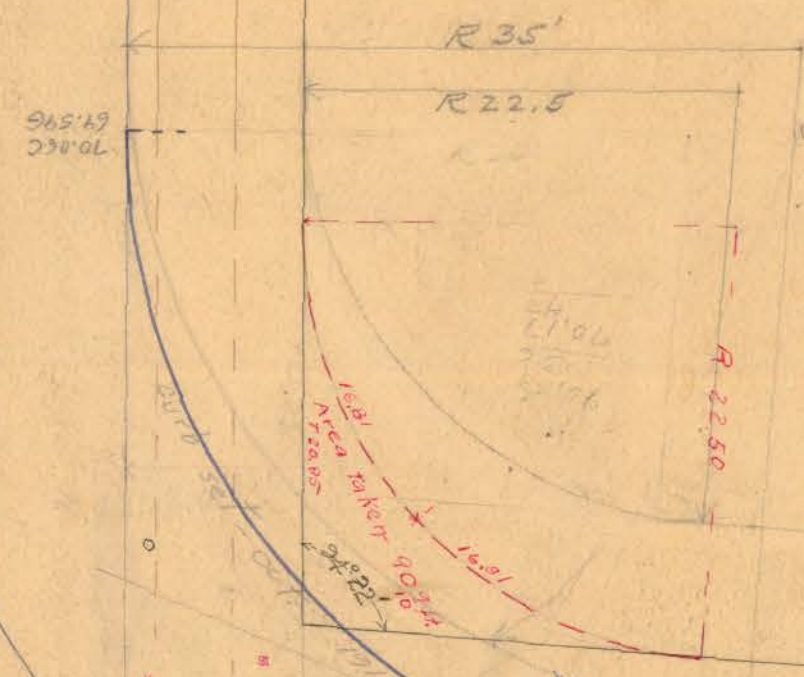

47-11-10113
21.586
City to pay for Radius
Proposed Mass 1922
10' 10'

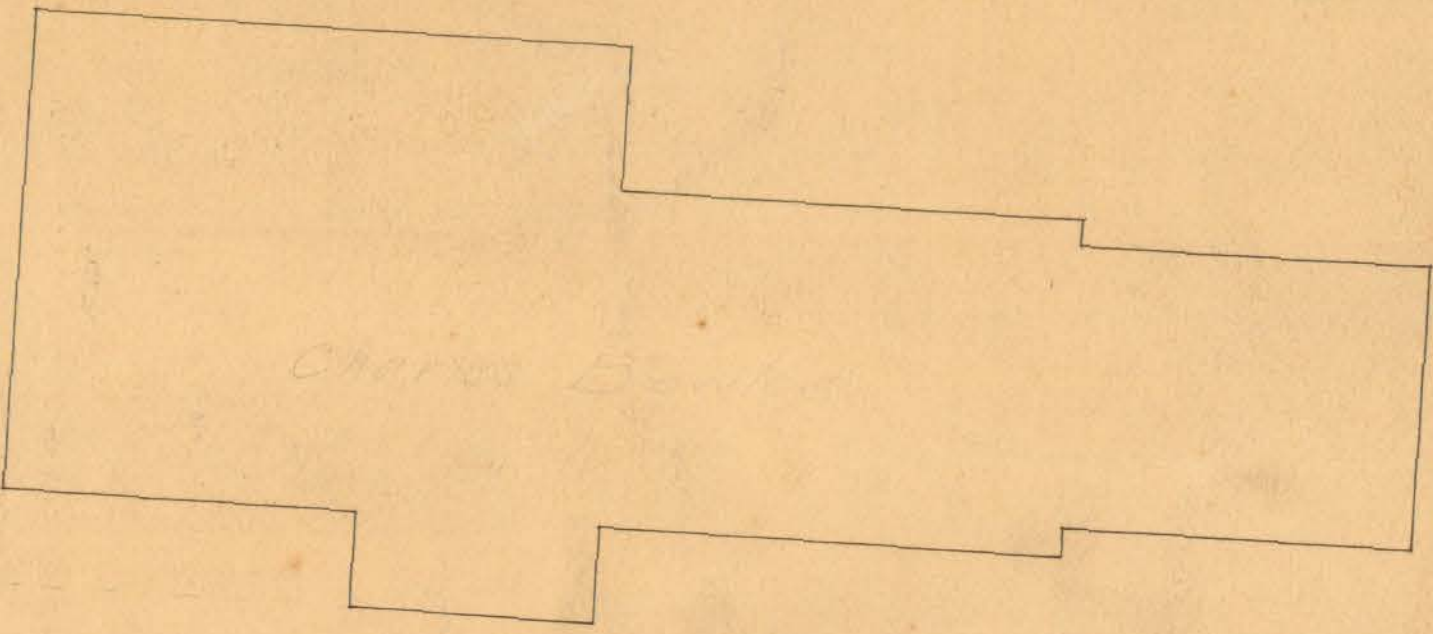

OFFICE OF CITY ENGINEER
HARTFORD, CONN.
Date Aug-1906, City Engineer, C. B. S.
Scale 1" = 10'