


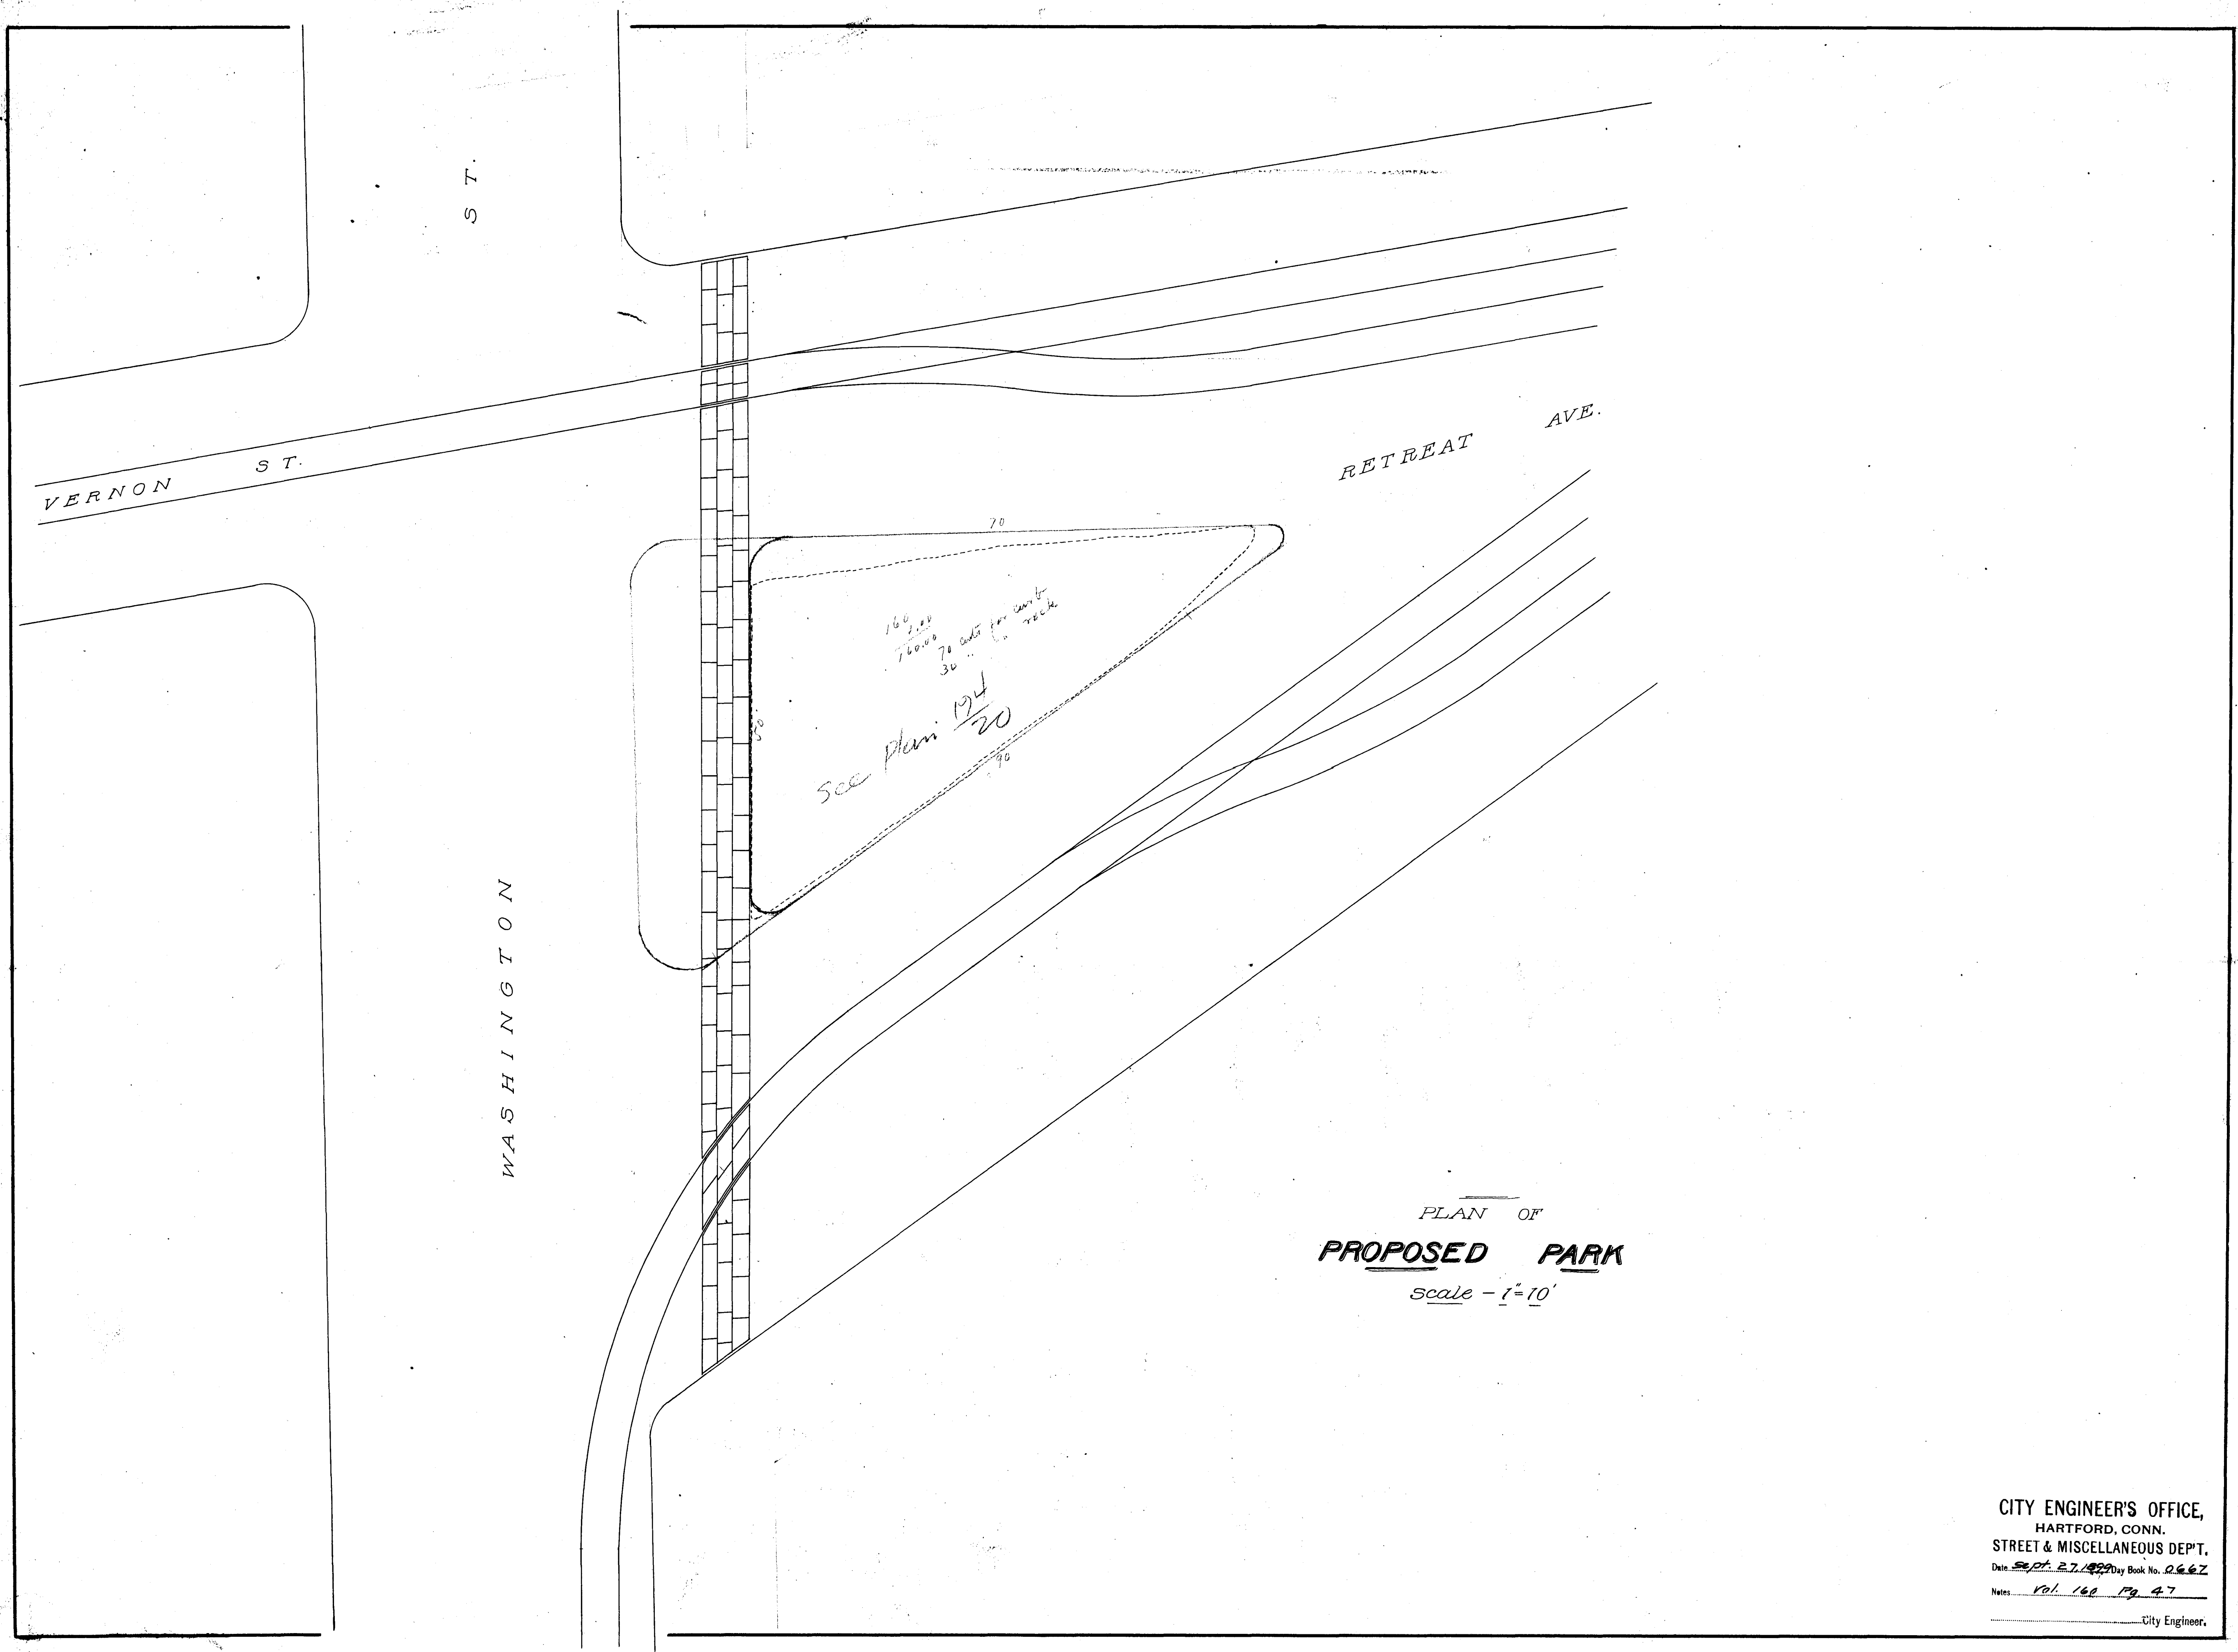

PLAN OF
PROPOSED PARK
Scale - 1" = 10'