

Layout Vol. 3, P. 130/14

Notes 737

AVENUE

STREET

WINTER STREET

STREET






GREEN

STREET

FAIRMOUNT

MATHER

ALBANY

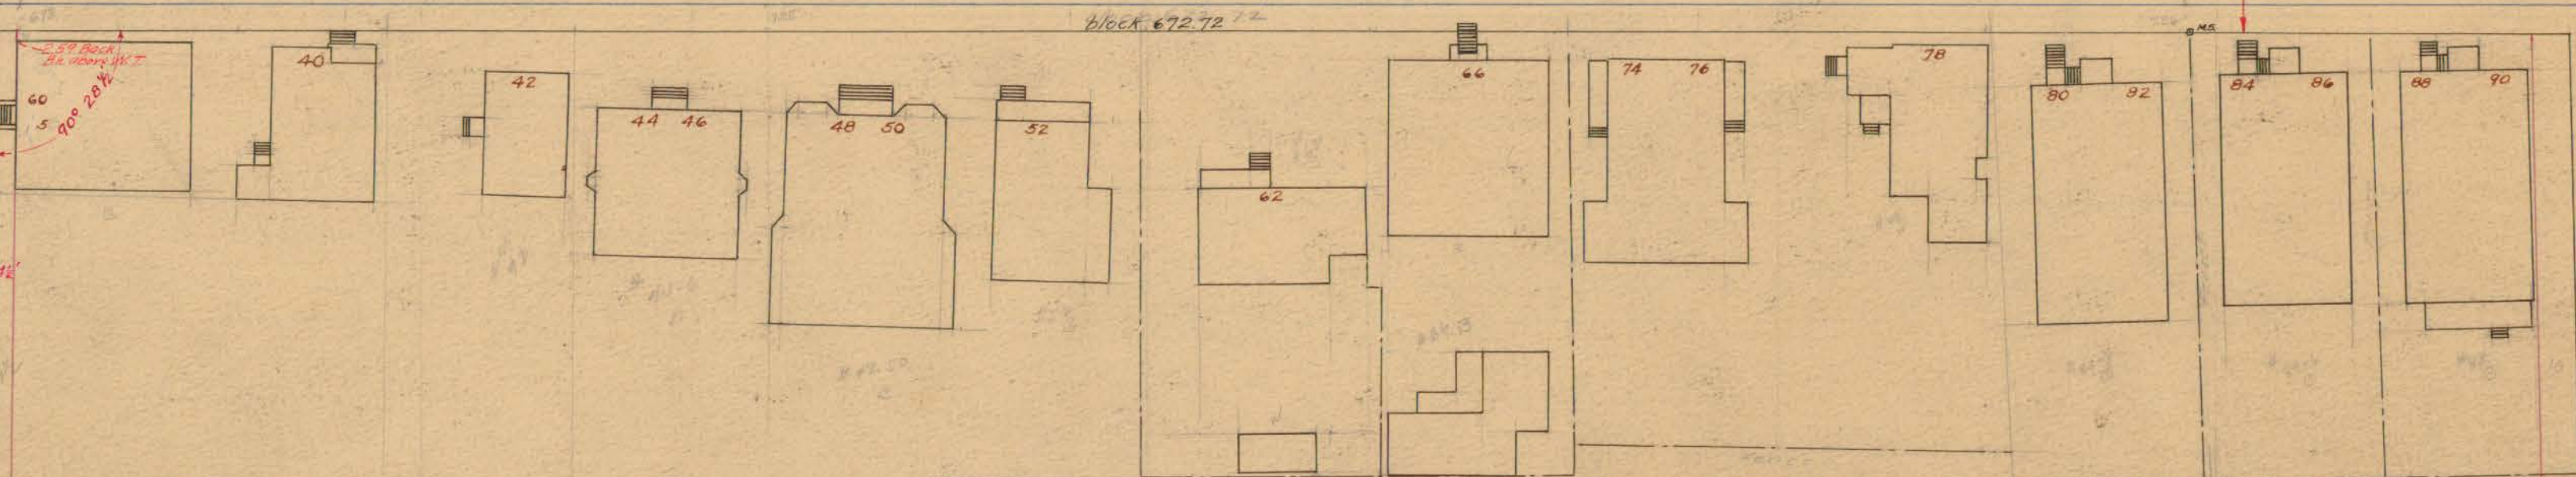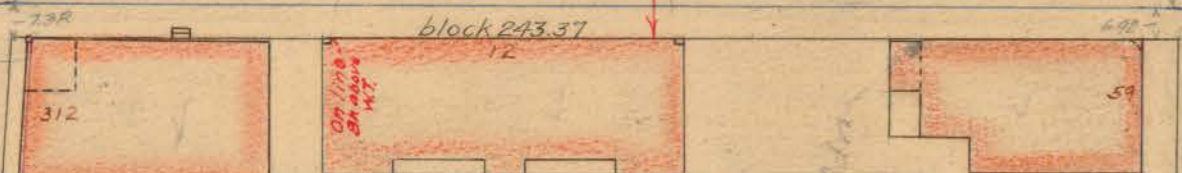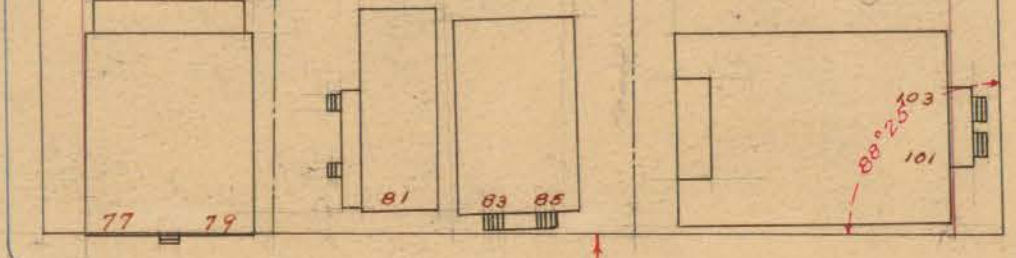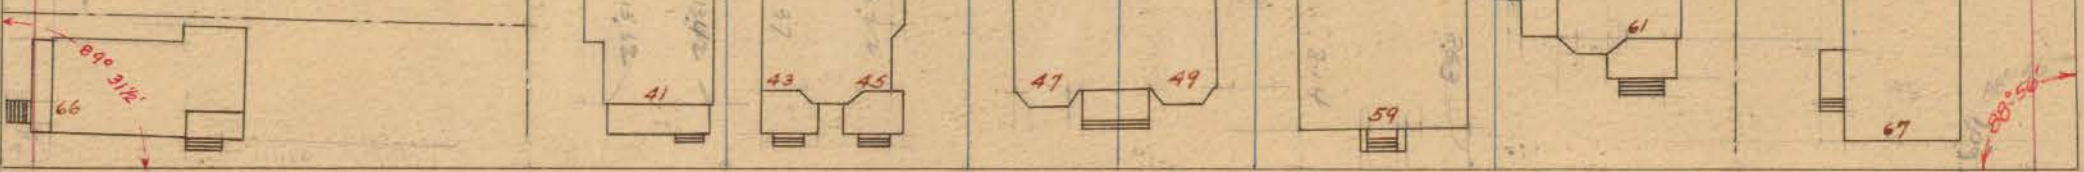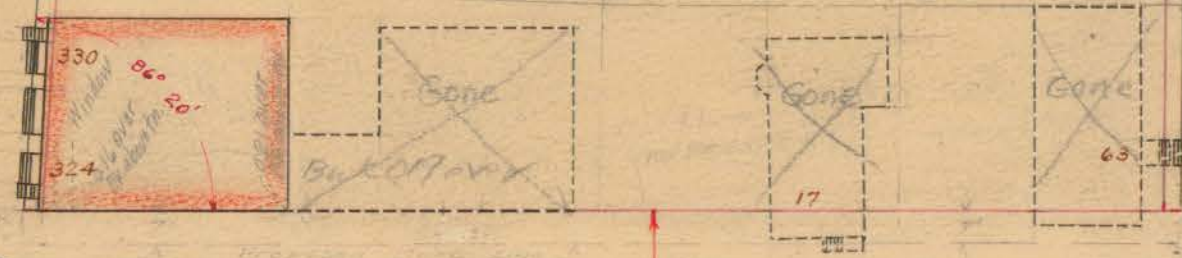

OFFICE OF CITY ENGINEER
HARTFORD, CONN.
Date Mar. 1923
City Work No. 05485
Notes 451-115 & 214-136 307/52

Scale: 1" = 40'