
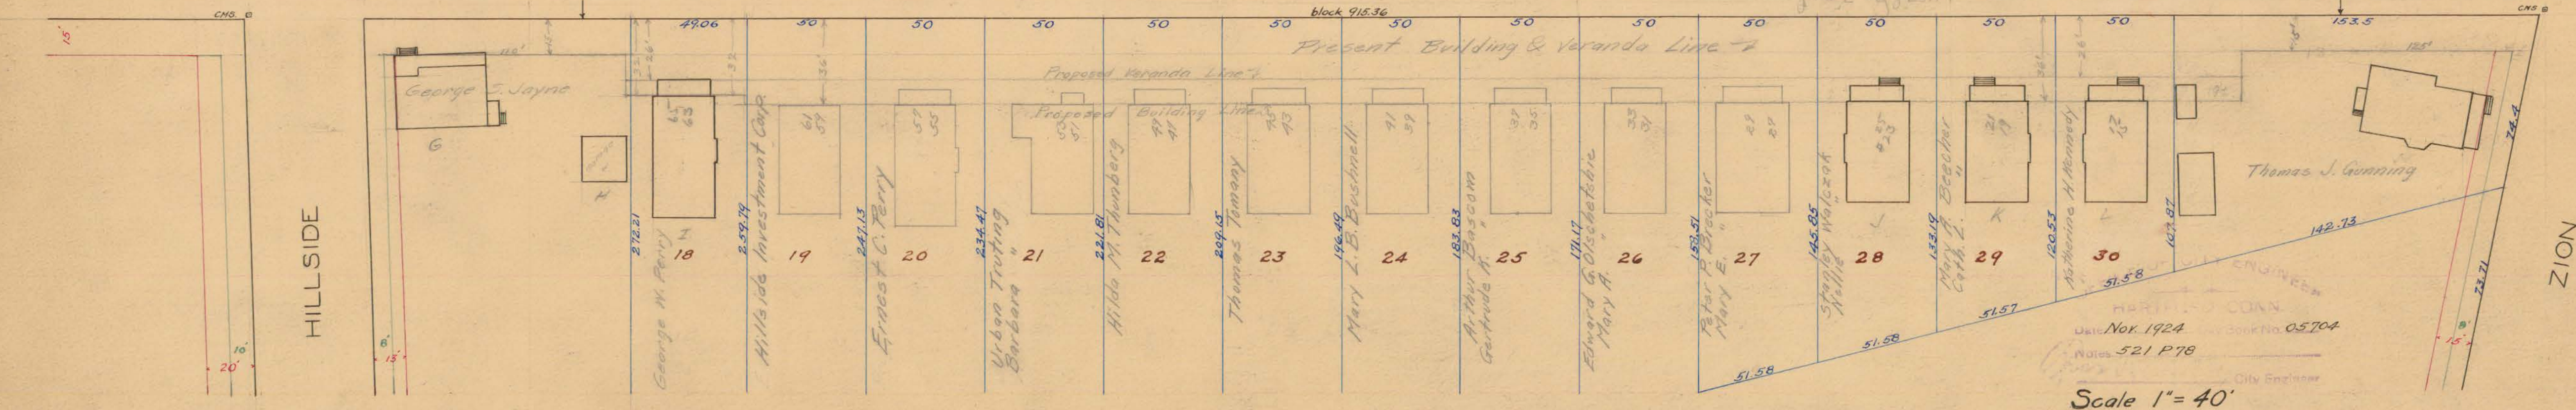


Sherbrooke Avenue
GRAND AVENUE

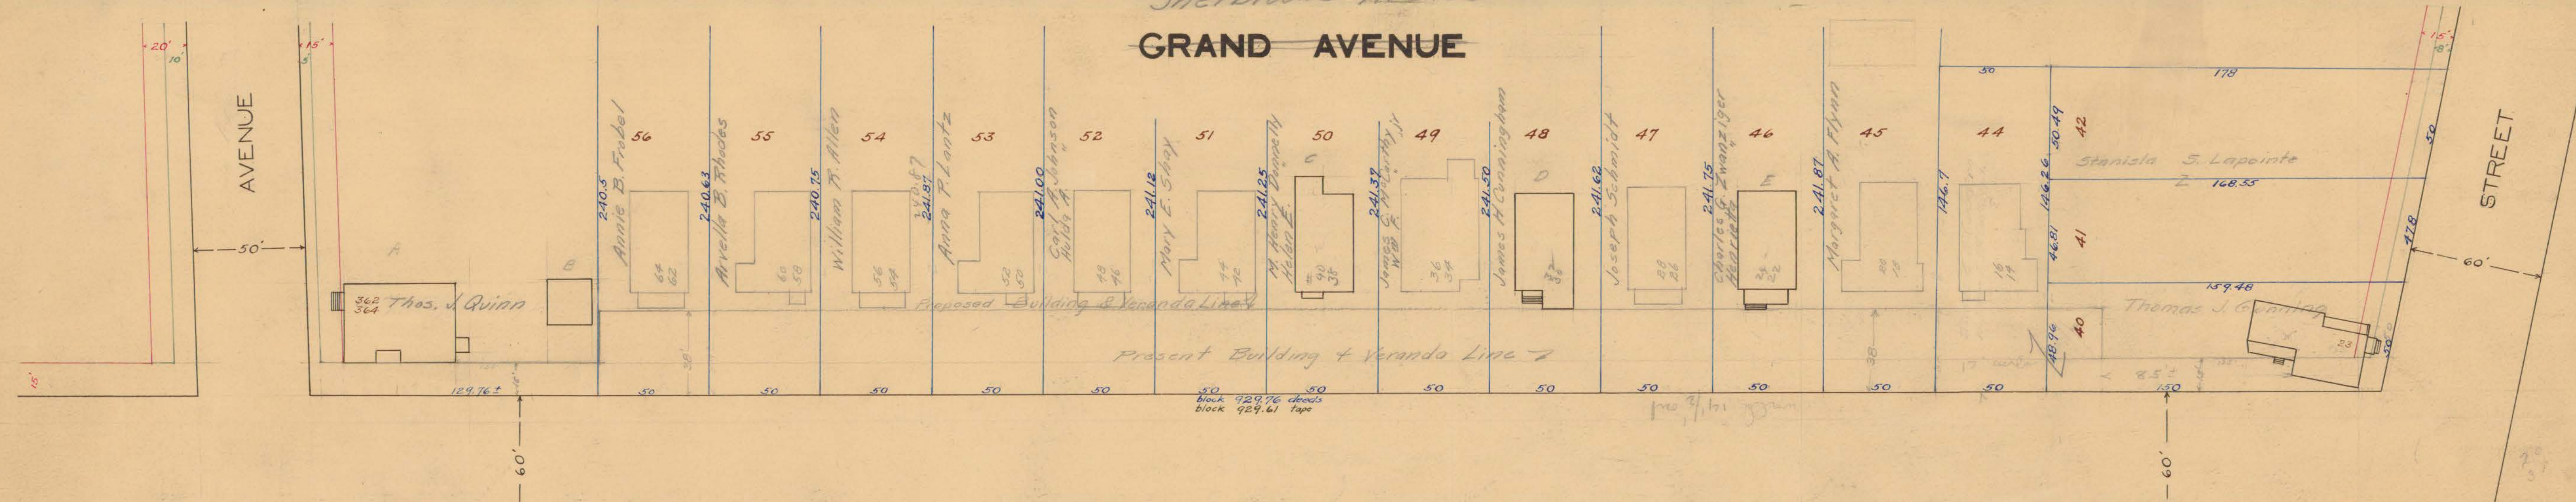

Scale 1" = 40'

DATE Nov. 1924
Notes 521 P 78
City Engineer