


1068  
2049  
30785  
5013  
1937  
2007  
0.20

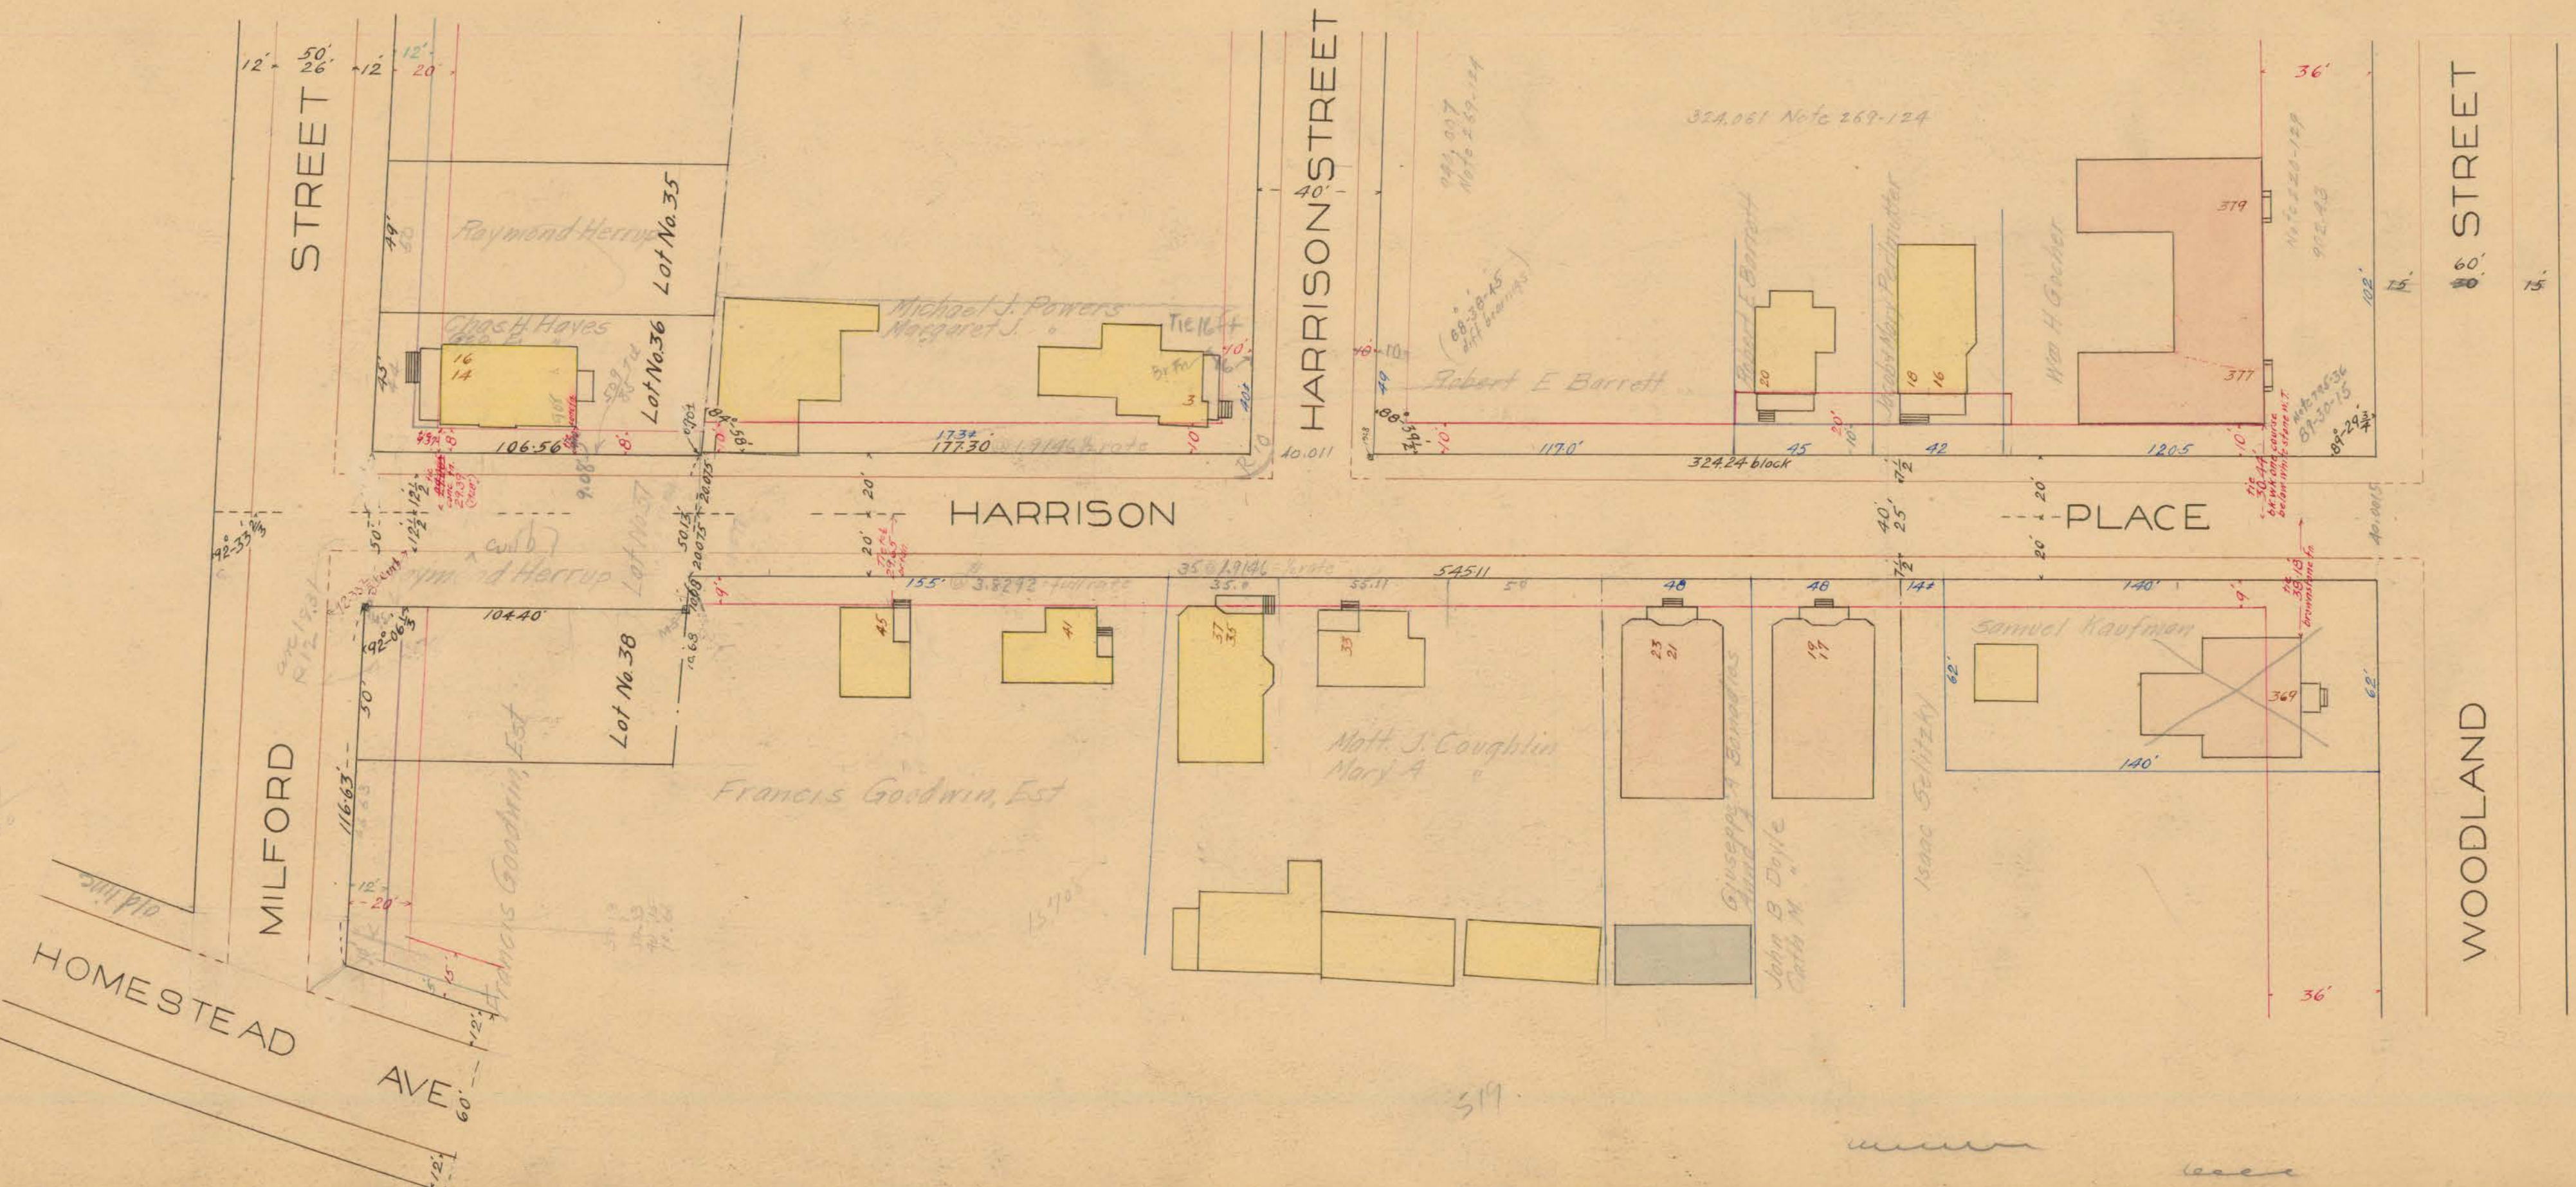

OFFICE OF CITY ENGINEER  
HARTFORD, CONN.  
Date Jan 1925 Day Book No. 05744  
Notes 509 269 Ties 509 22.85  
R. N. Clark City Engineer  
Scale 1" = 40'

480  
34