



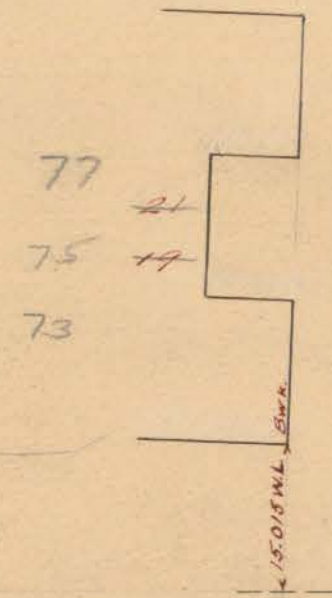


ST

BUCKINGHAM

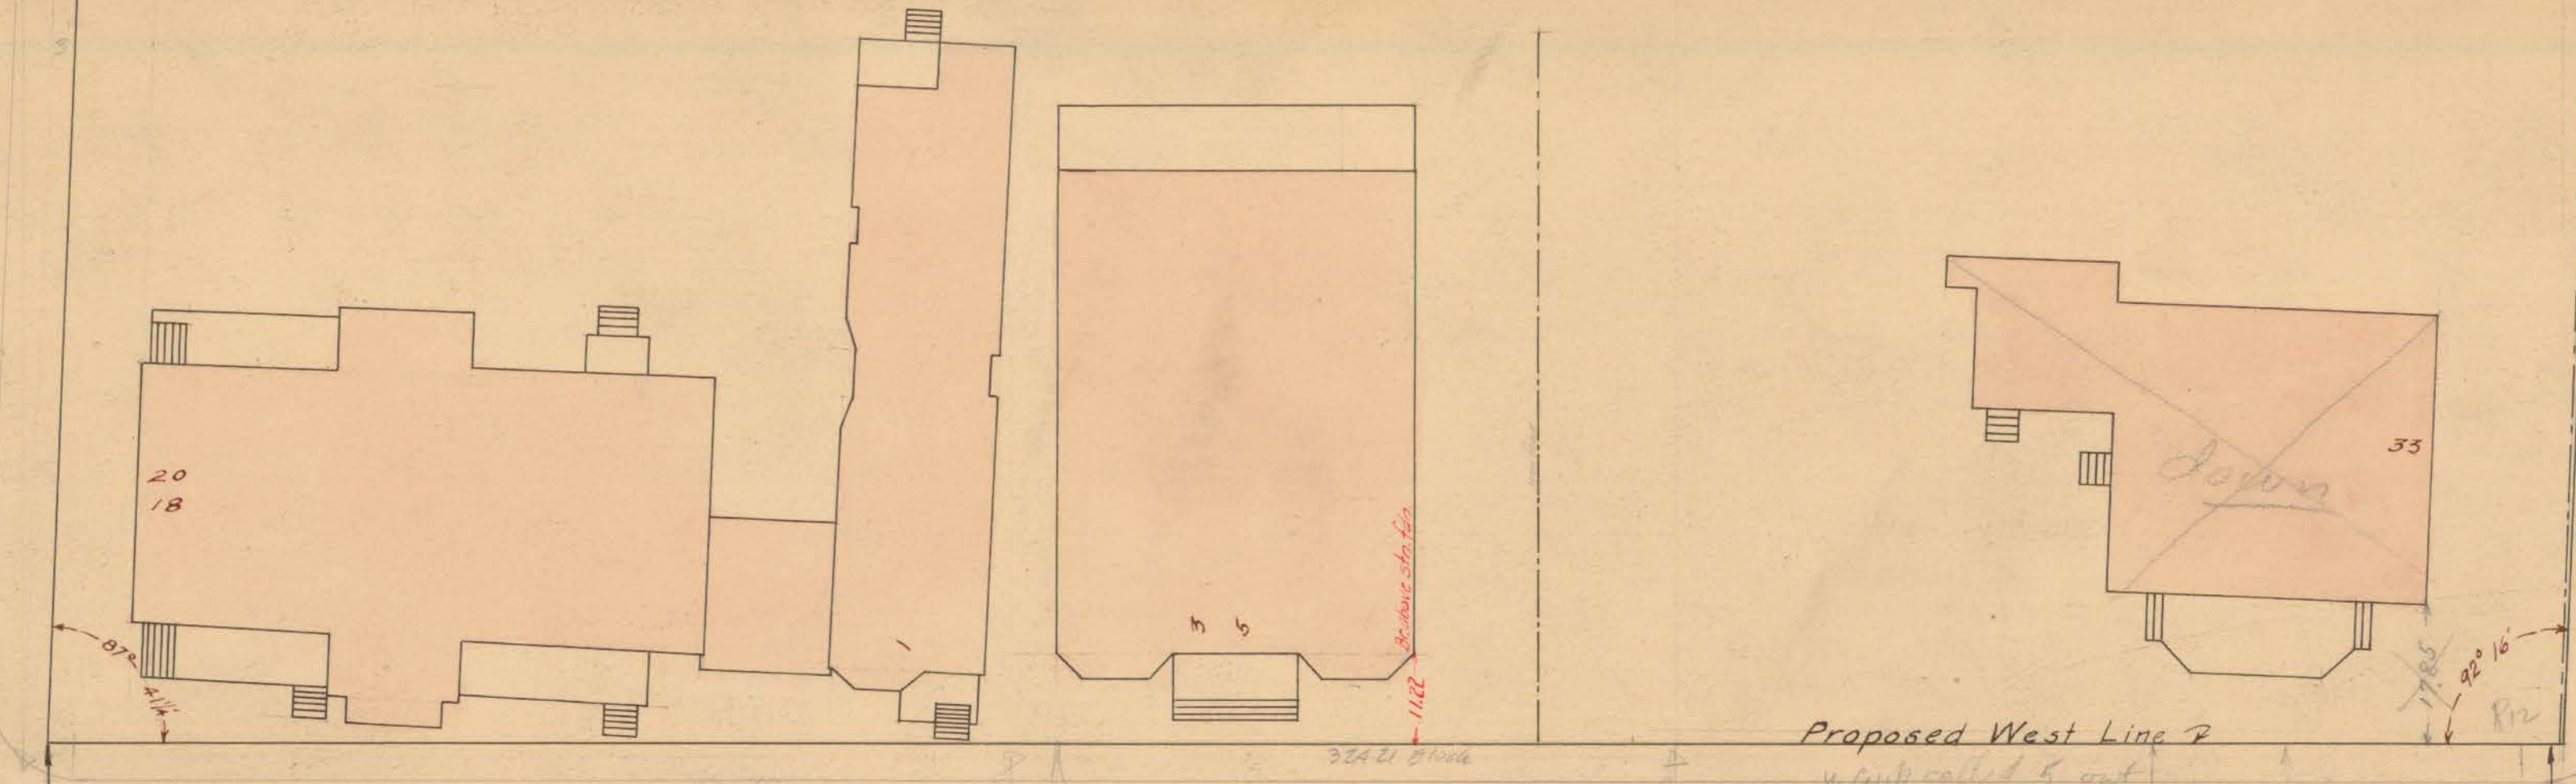

WHITMAN

COURT

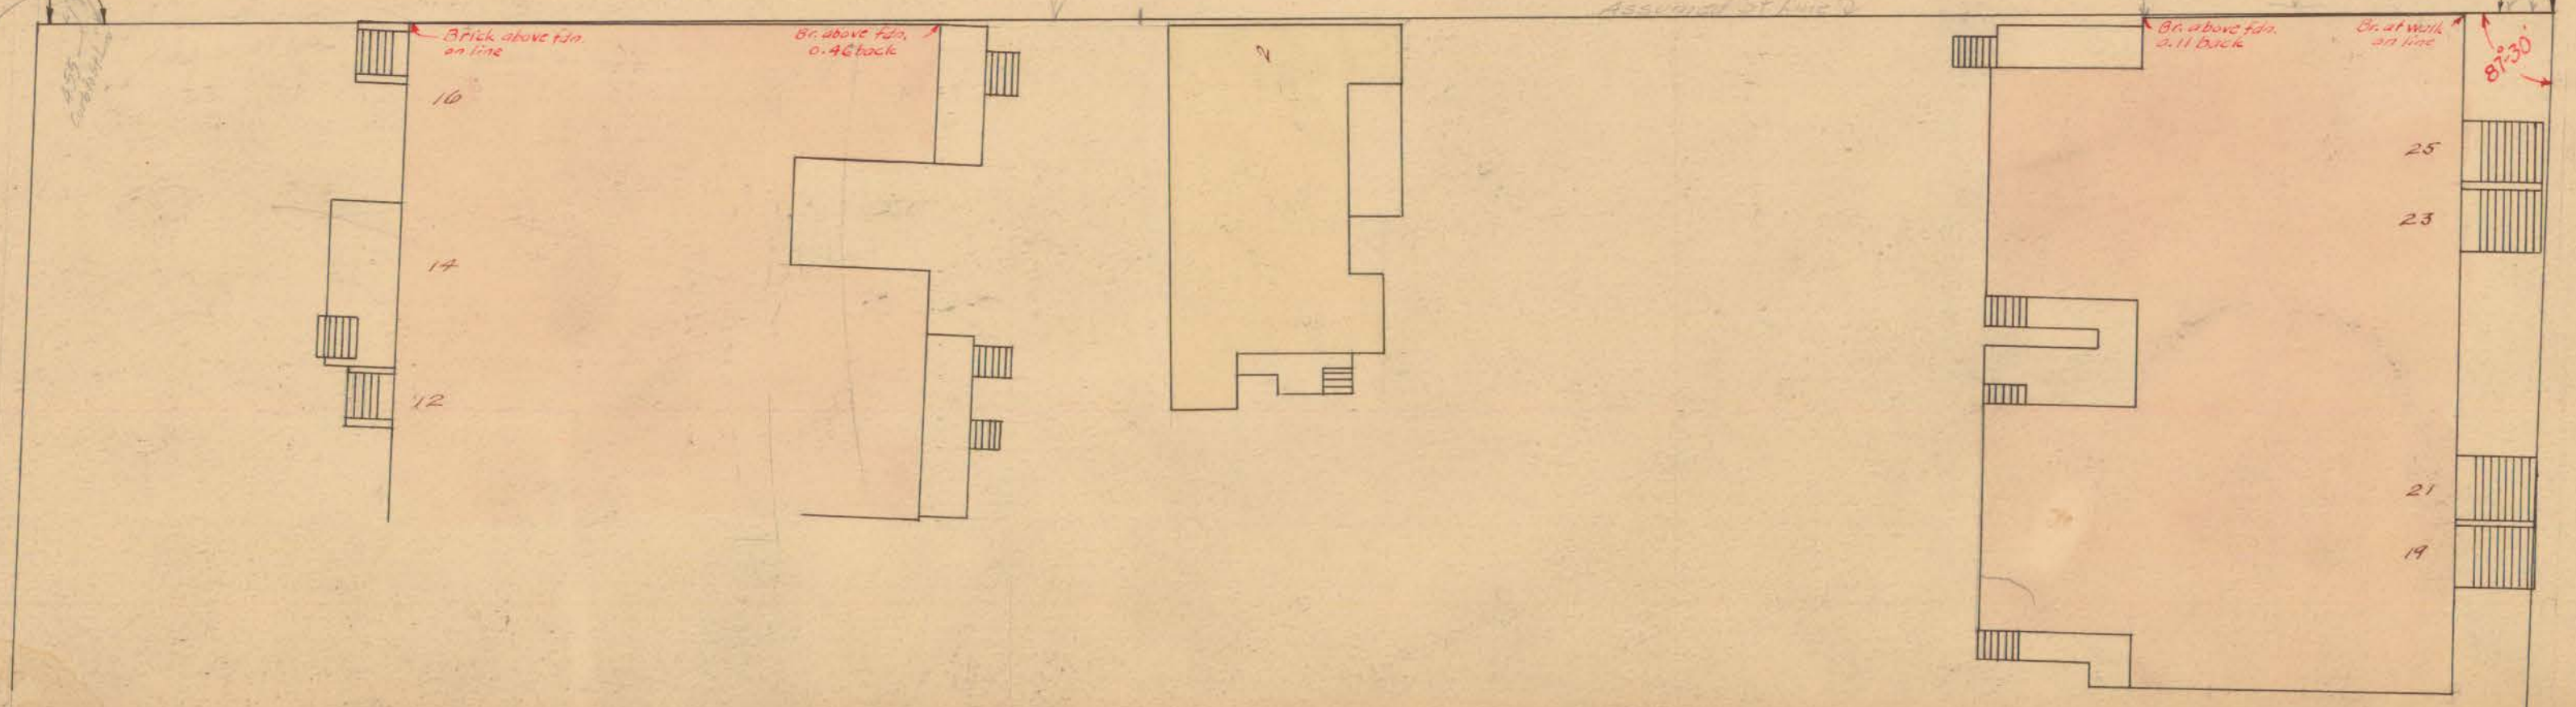

Ties - Notebook 489 Pg 3.


St. Lines not Parallel
Curbs not parallel

Assumed St Line P

East Curb

AVE

CAPITOL

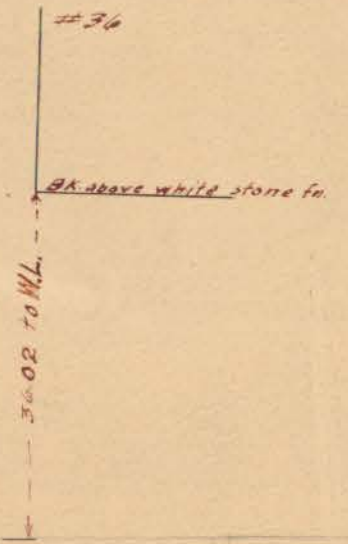

OFFICE OF CITY ENGINEER
HARTFORD, CONN.
Date 1-1928 Day Book No. 06307
Note 489-130 Survey
3 Ties
P. N. Clark City Engineer
Scale 1"=20'