
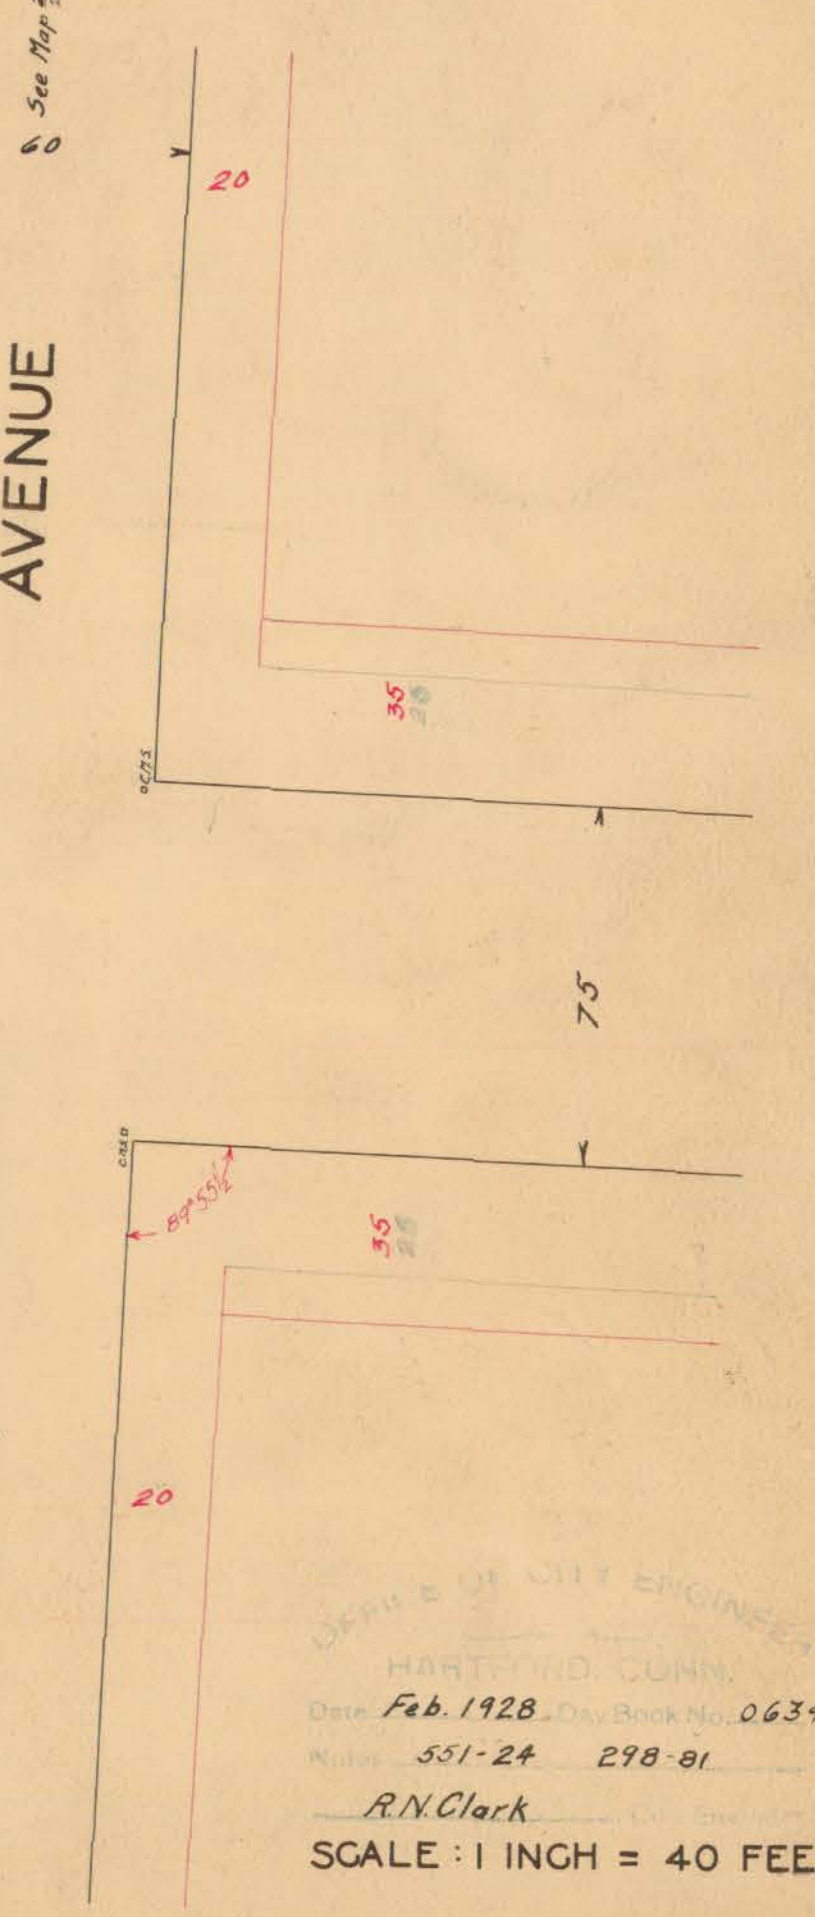
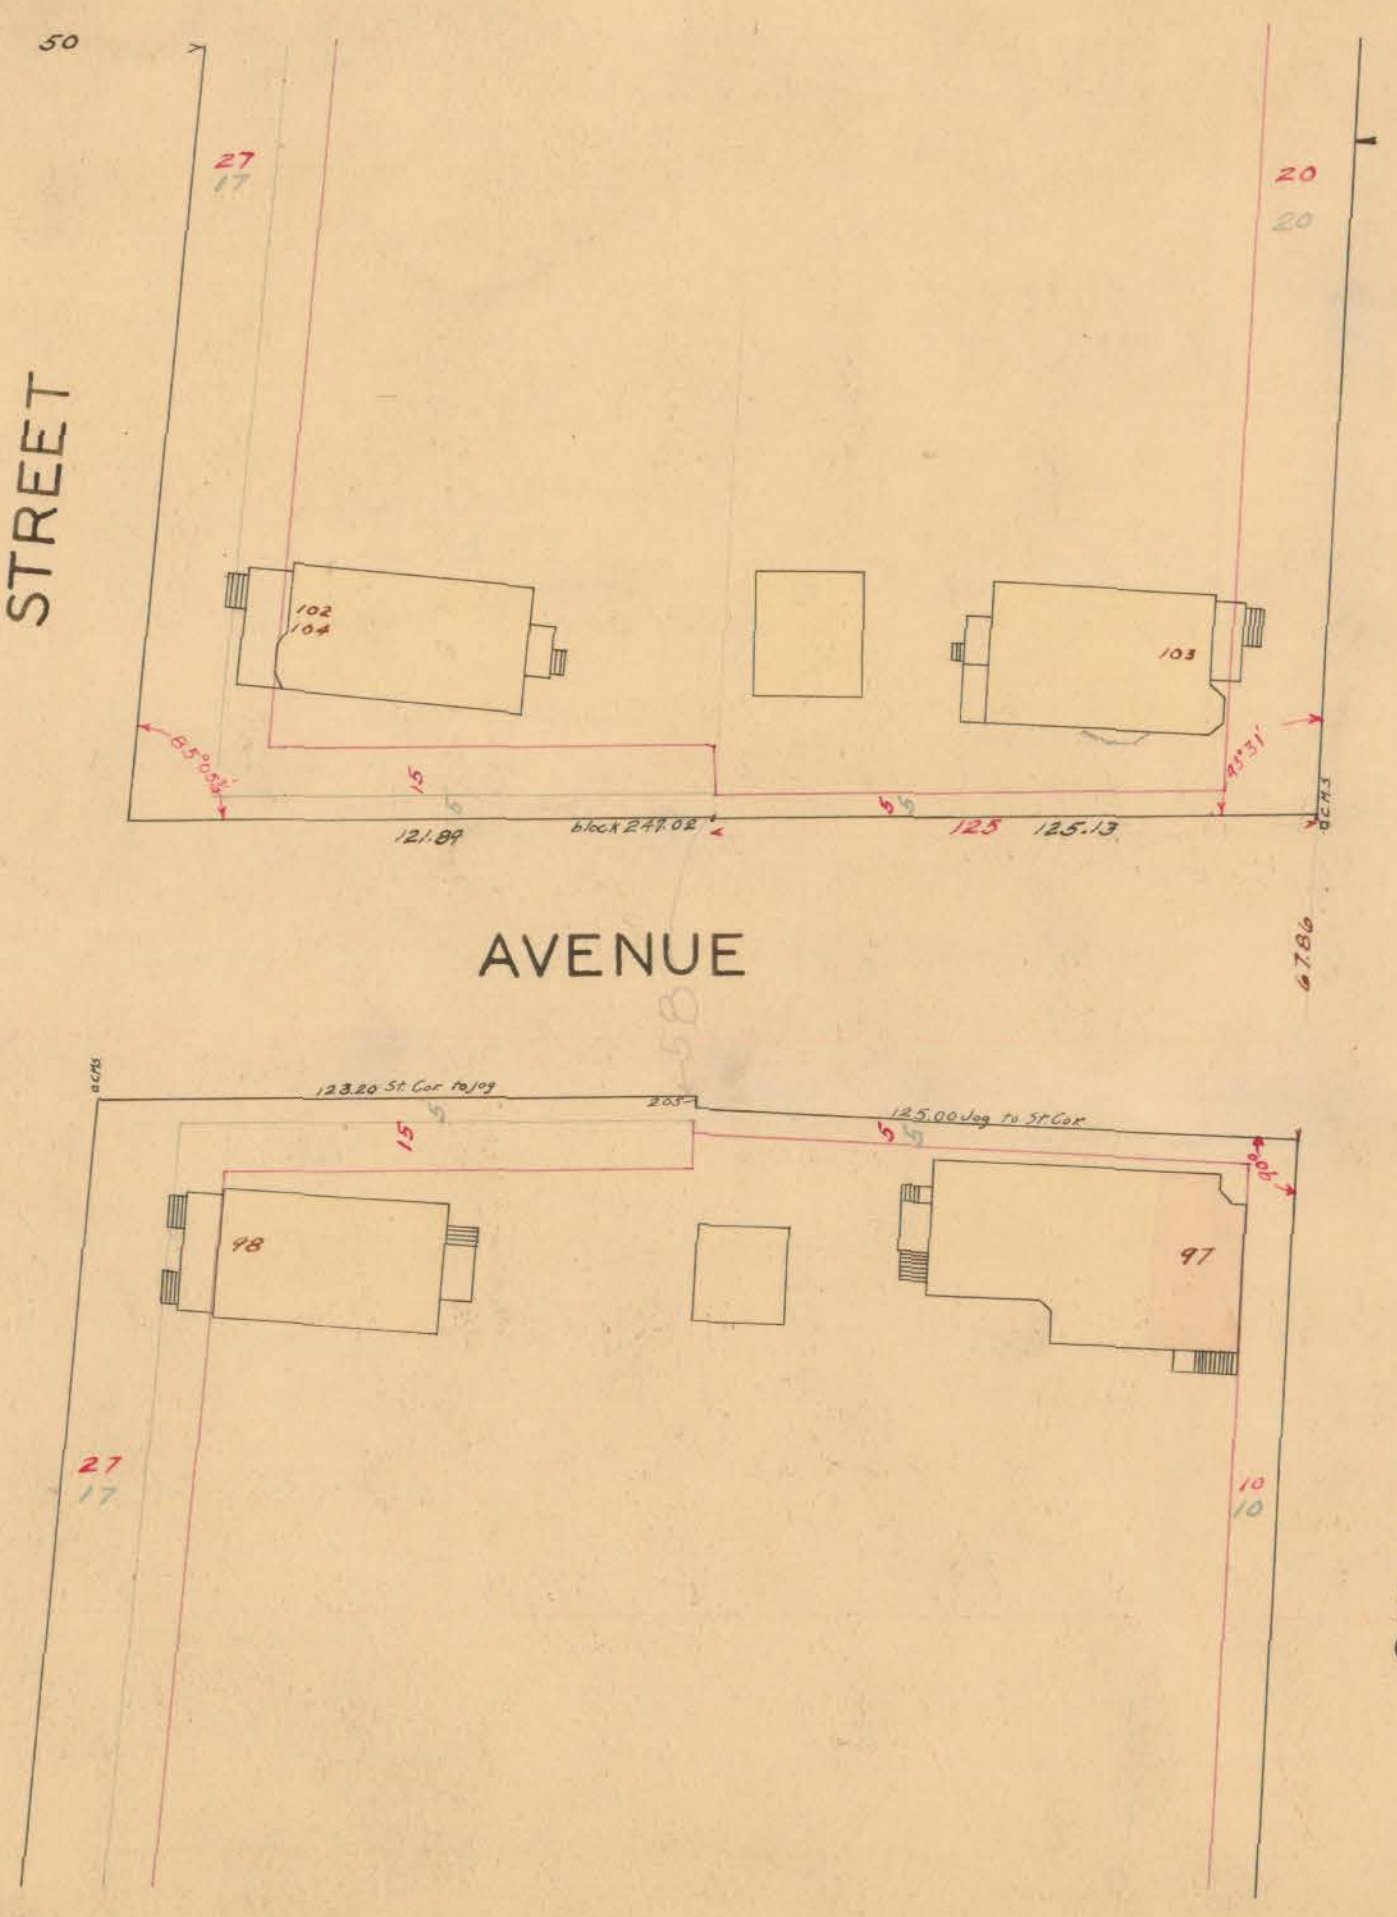
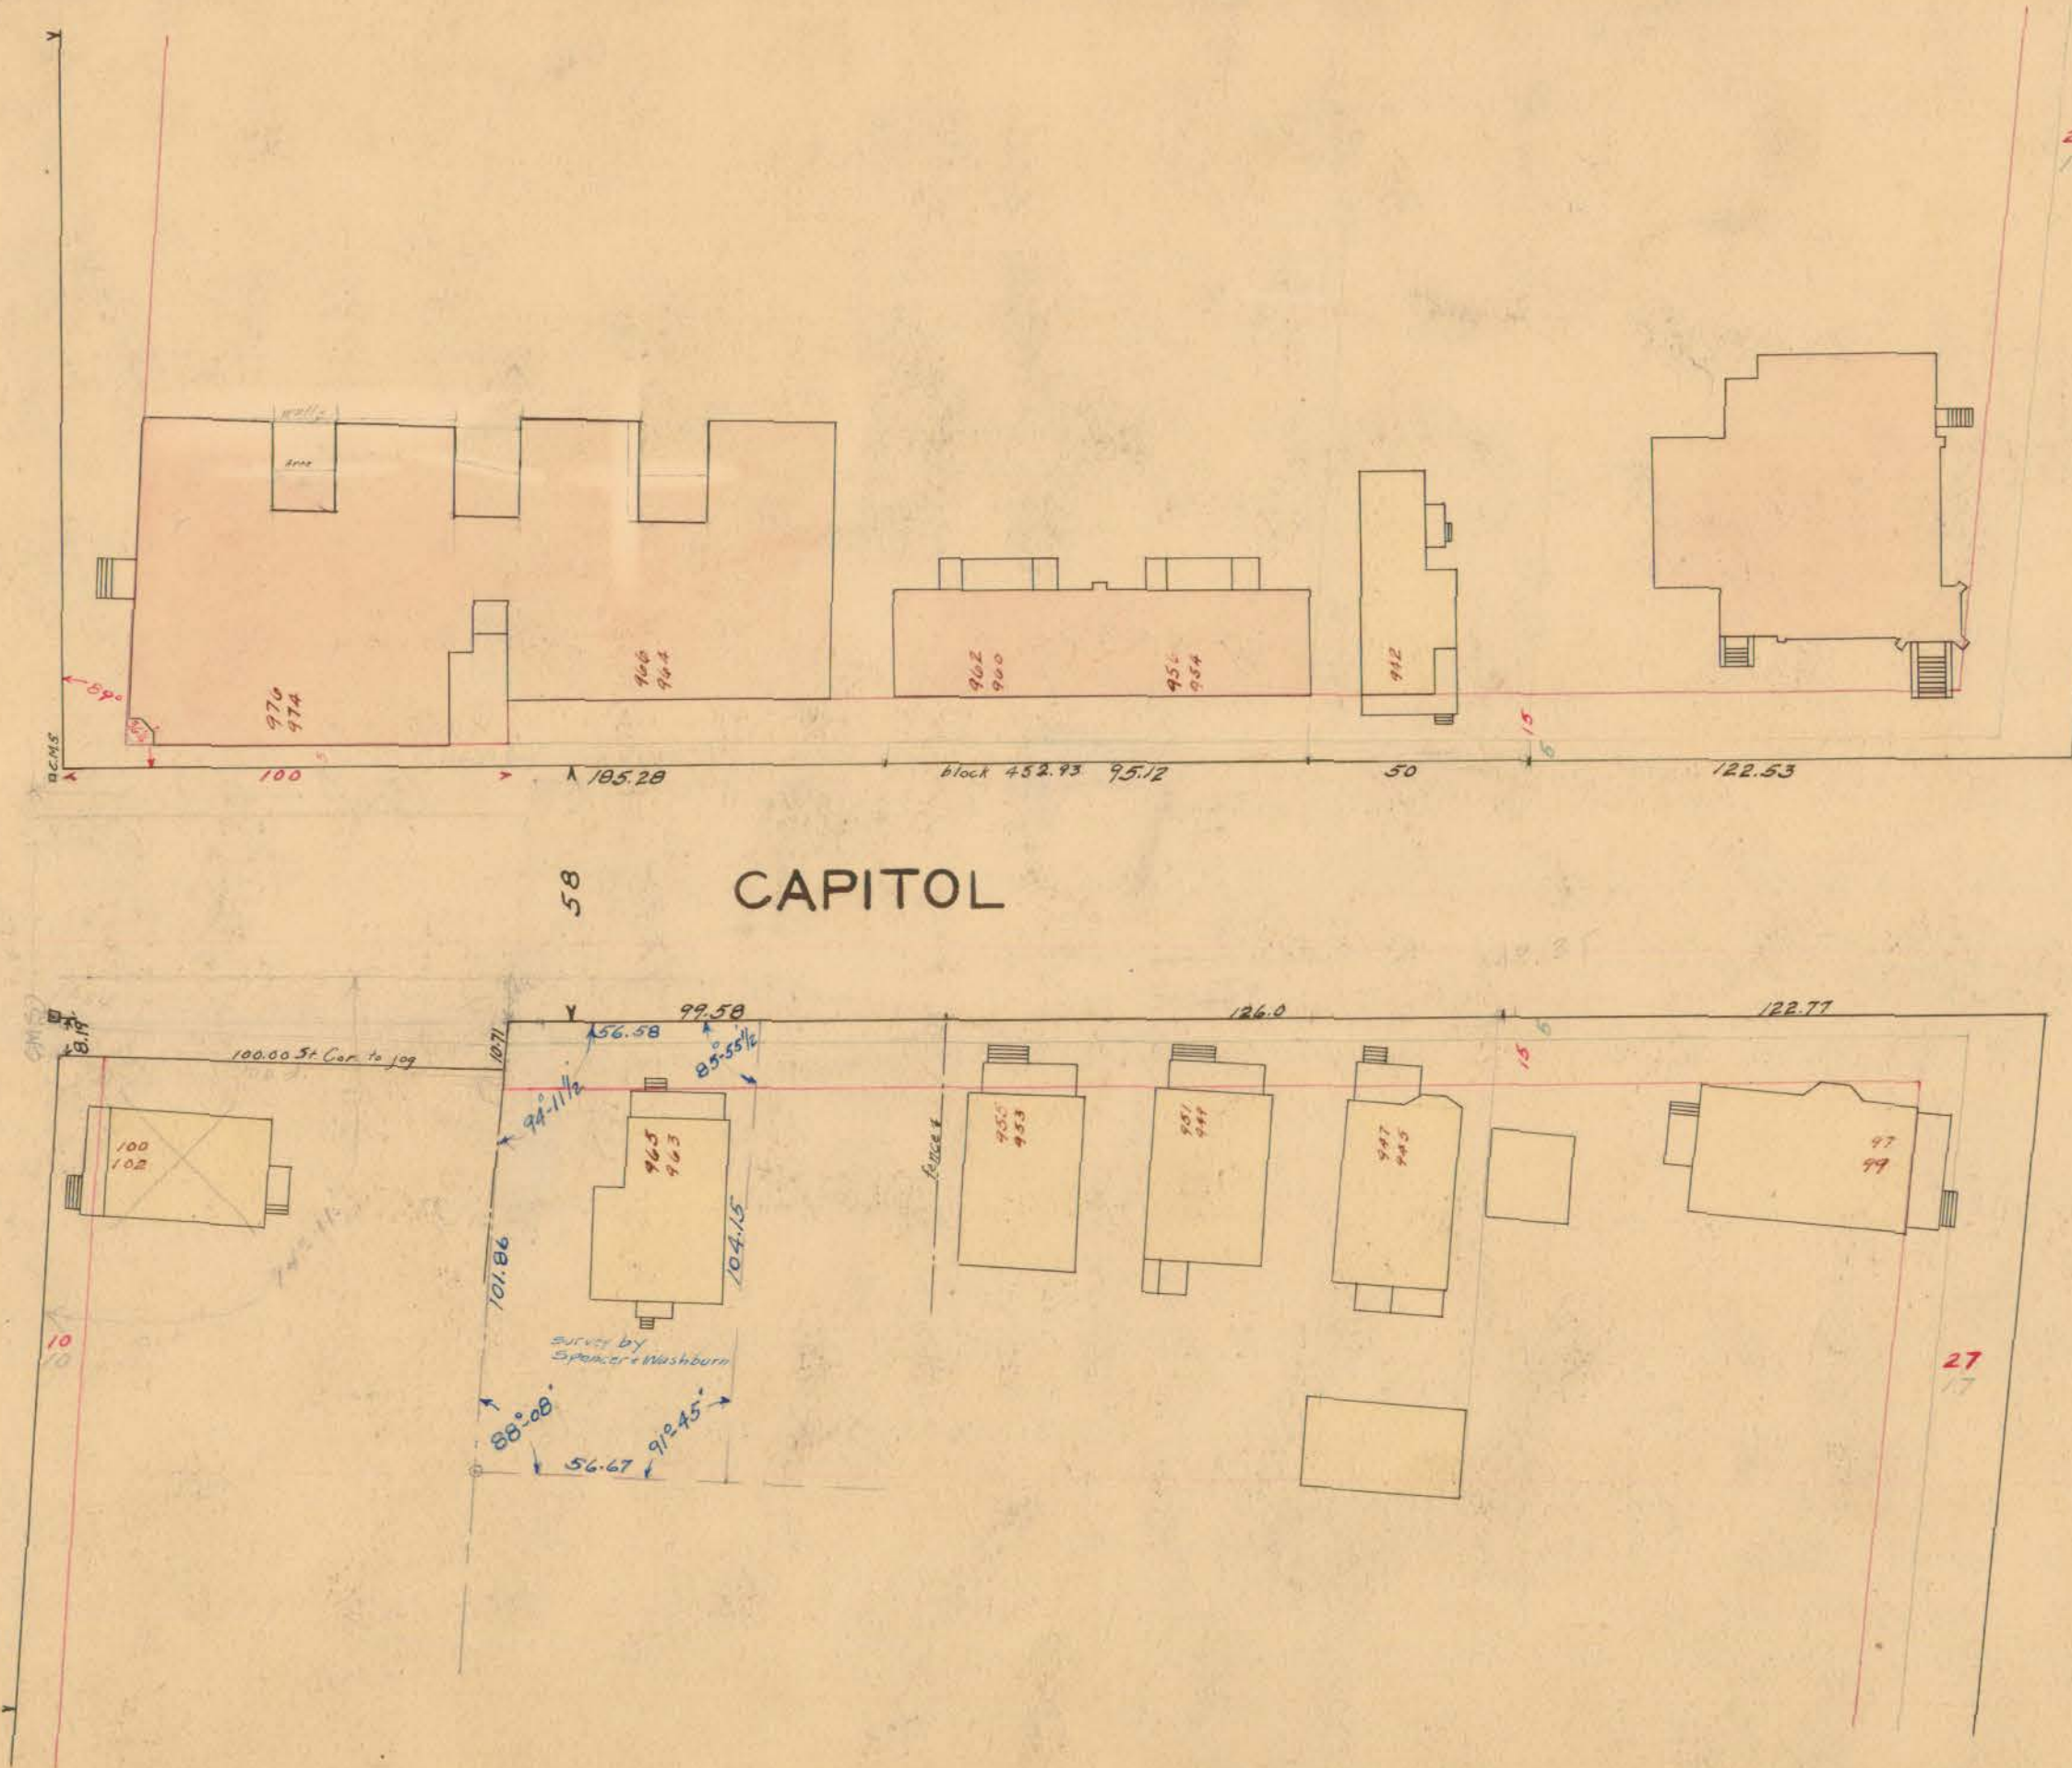


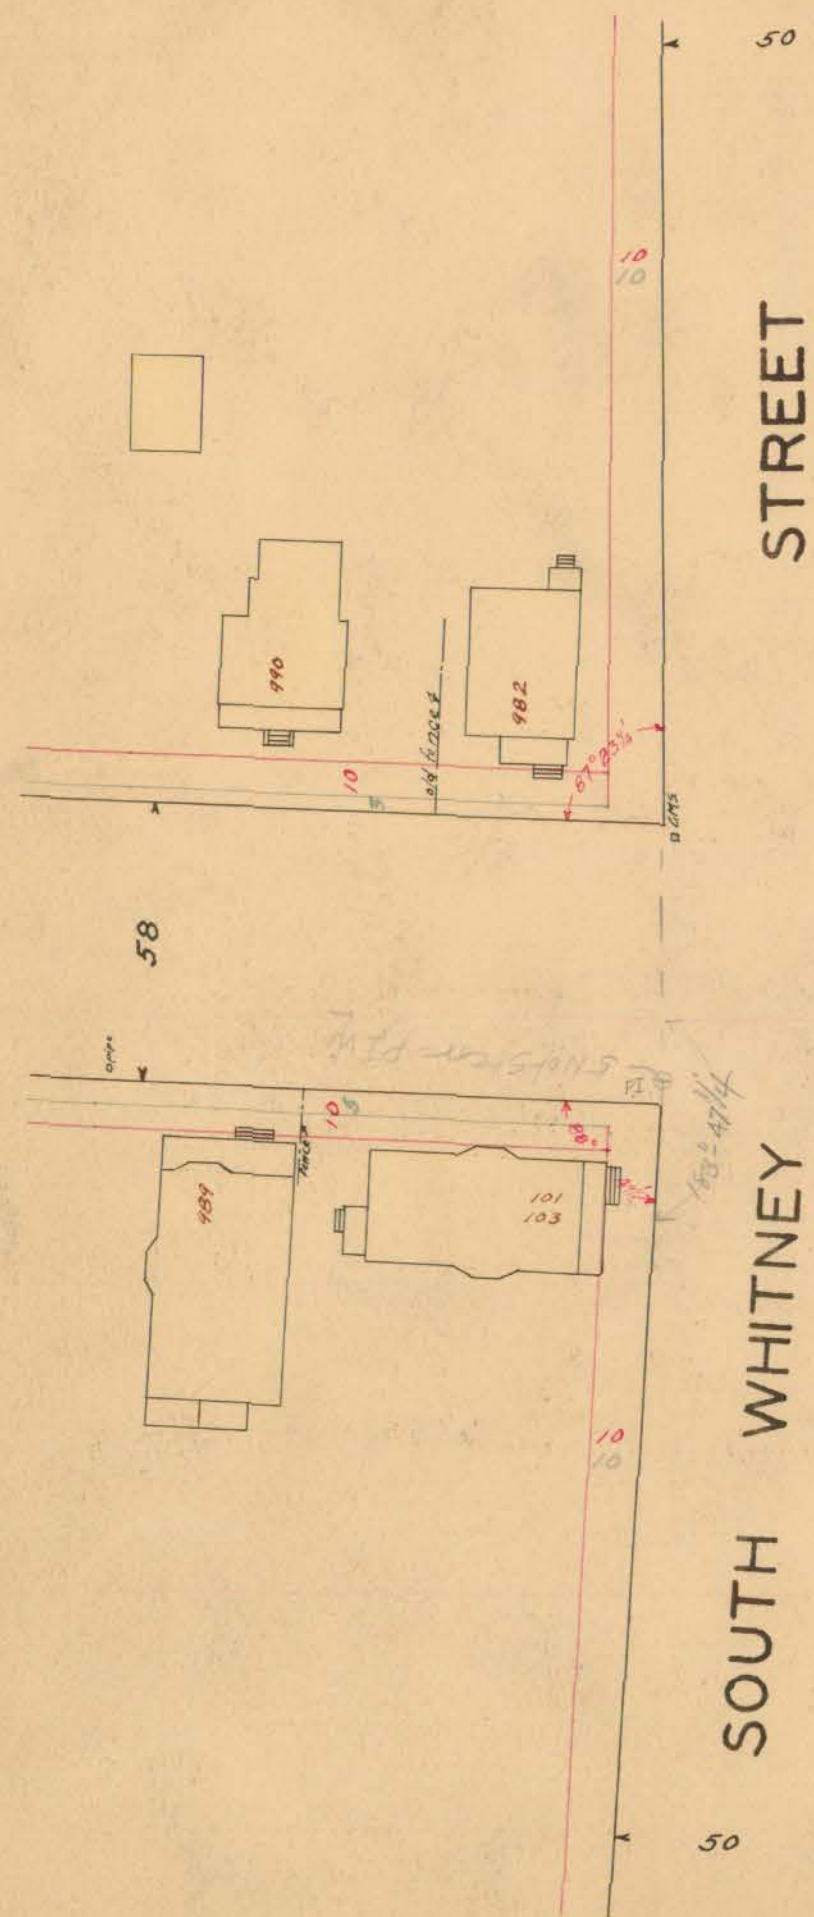

DEPT. OF CITY ENGINEERS
HARTFORD, CONN.
Date Feb. 1928 Day Book No. 06349
Notes 551-24 298-81
R.N. Clark
SCALE: 1 INCH = 40 FEET