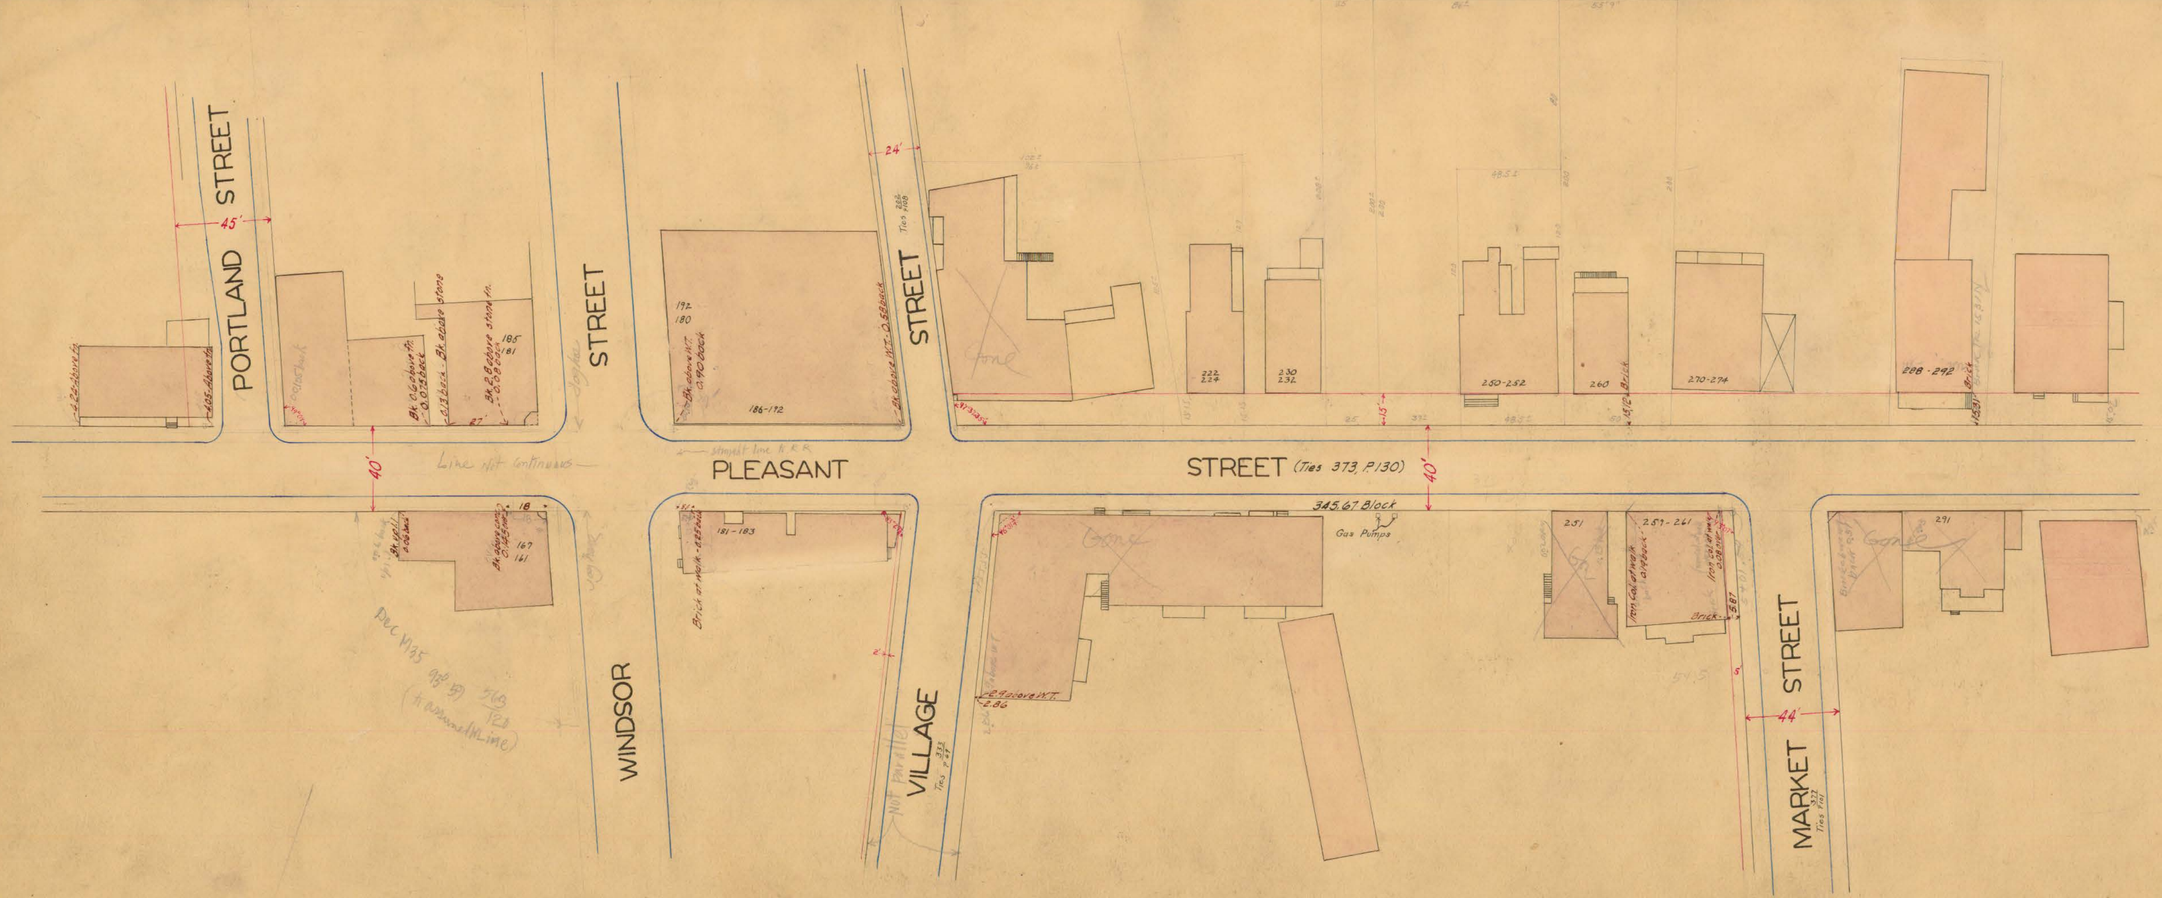

CITY OF HARTFORD
DEPARTMENT OF ENGINEERING
SCALE 1" = 40' DATE SEPT. 1933
NUMBER 07215

NOTE BOOK 575-P138 -373 Tie P130