


ALLEN PLACE

BROAD TO SUMMIT

SCALE VERT. 1"=10'
HORI. 1"=50'

Gr. N+5 126.46 w/c = 30' on Broad St
30' Gr. = 174.51 w/c = 174.51 on Broad St

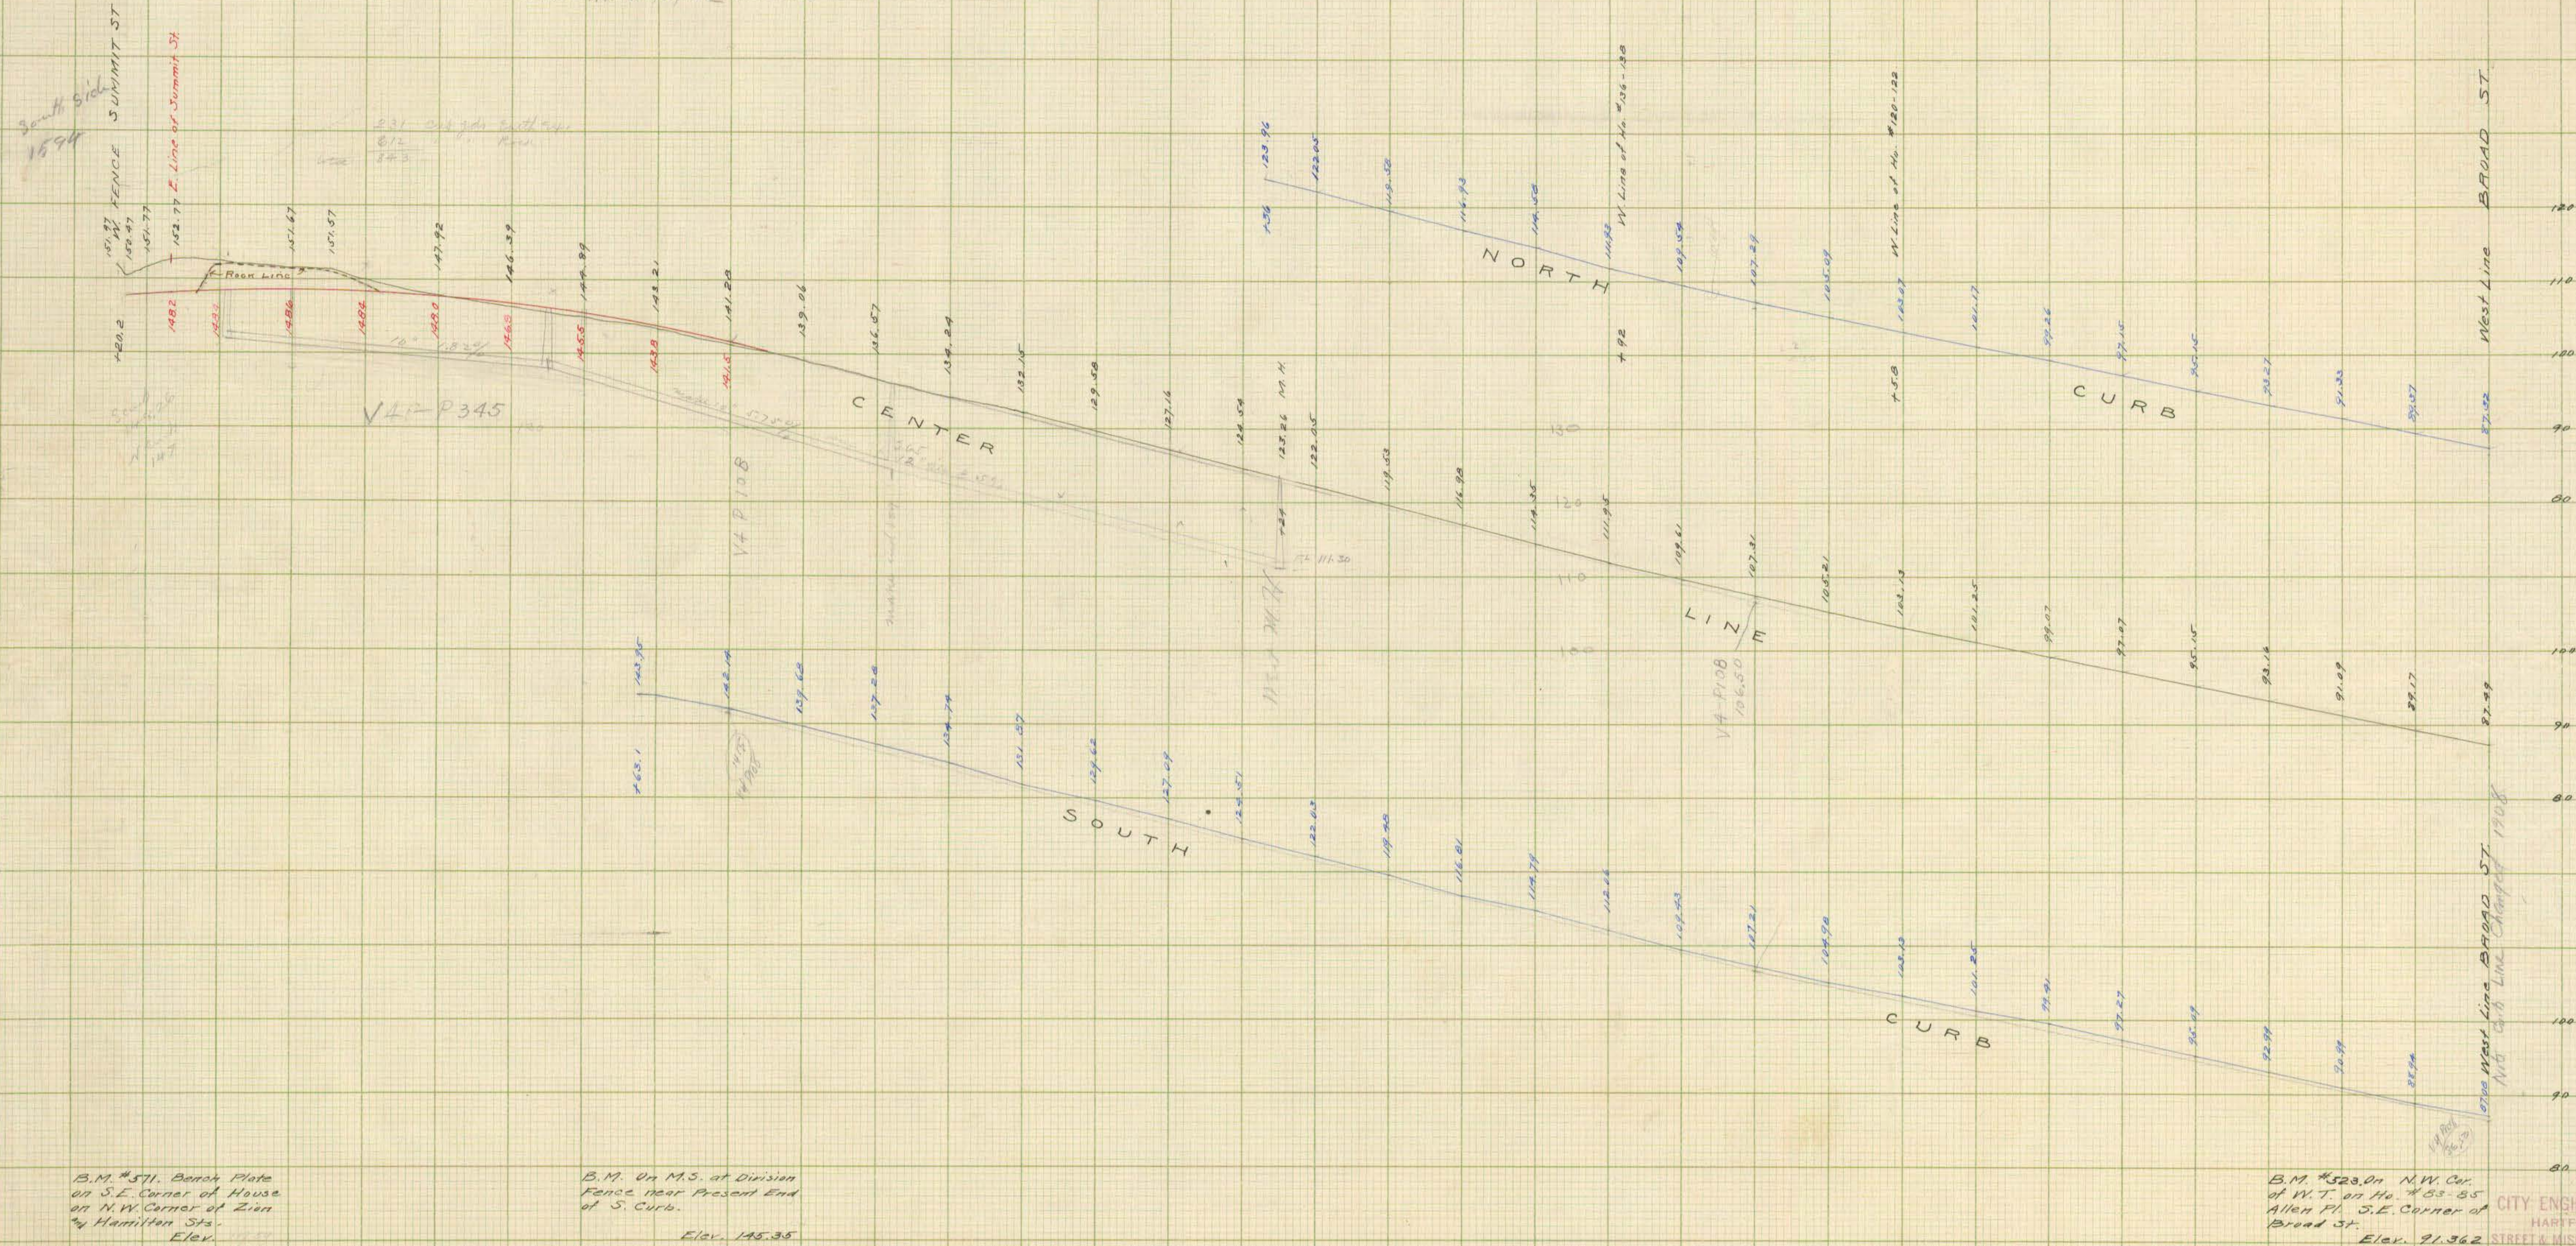

B.M. #571. Bench Plate
on S.E. Corner of House
on N.W. Corner of Zion
by Hamilton Sts.
Elev. 117.57

B.M. On M.S. at Division
Fence near Present End
of S. Curb.
Elev. 145.35

B.M. #528. On N.W. Cor.
of W.T. on Ho. #53-55
Allen Pl. S.E. Corner of
Broad St.
Elev. 91.362

CITY ENGINEER'S OFFICE
HARTFORD, CONN.
STREET & MISCELLANEOUS DEPT.
May 3 1900 Day Book No. 0859
159
118-122