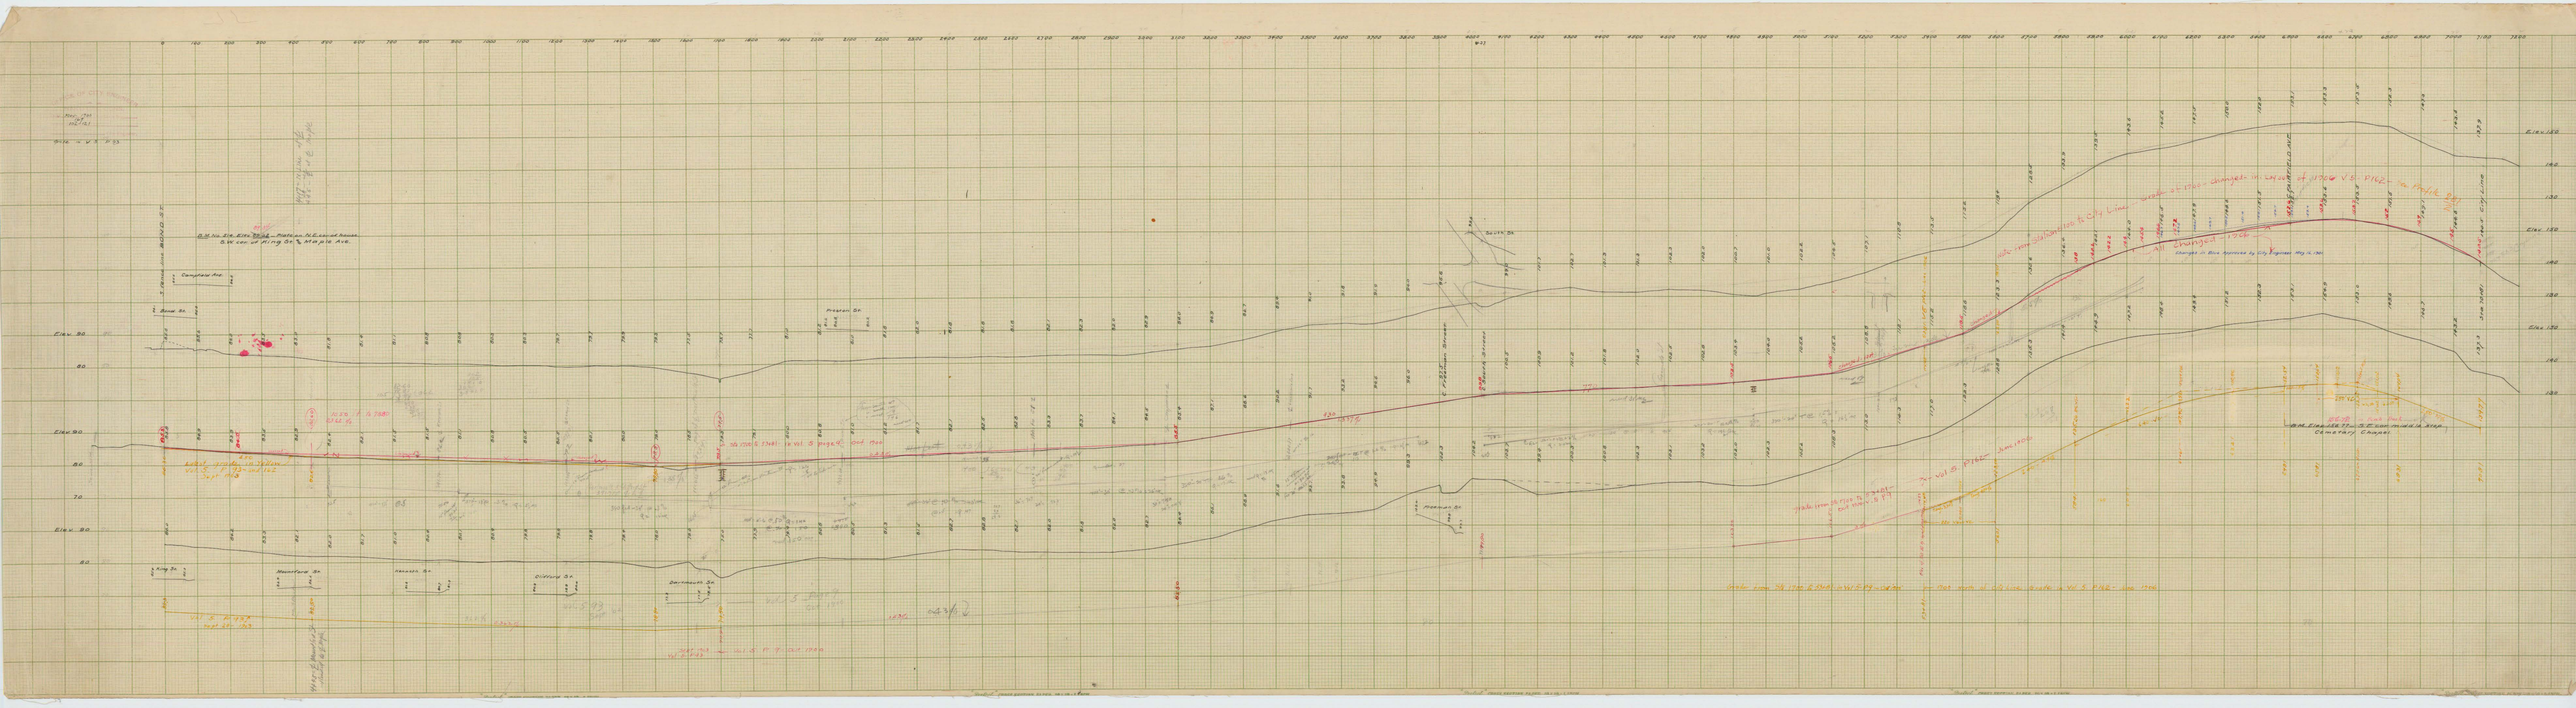
Elev. 90
80
70
Elev. 60
Elev. 150
140
130
120
Campbell Ave.
Dartmouth St.
Preston St.
Vol. 5 Page 187
Vol. 10 Page 183
