

Scale 1" = 8'

COMMENCE ST.

fence


fence line

fence line

fence line

fence line

corner point 10.75' east of curb
1.12' N of pump house
VA P20 33.95' from N.W. corner
of bridge crossing.

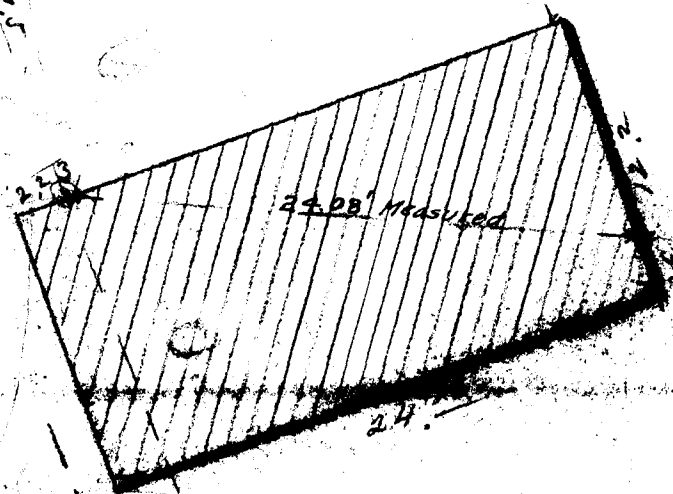

61

VRUENDALE

AVENUE

SHELDON ST.

curb

curb

Time

fence line

fence

fence

Time

Scale 1" = 8'