


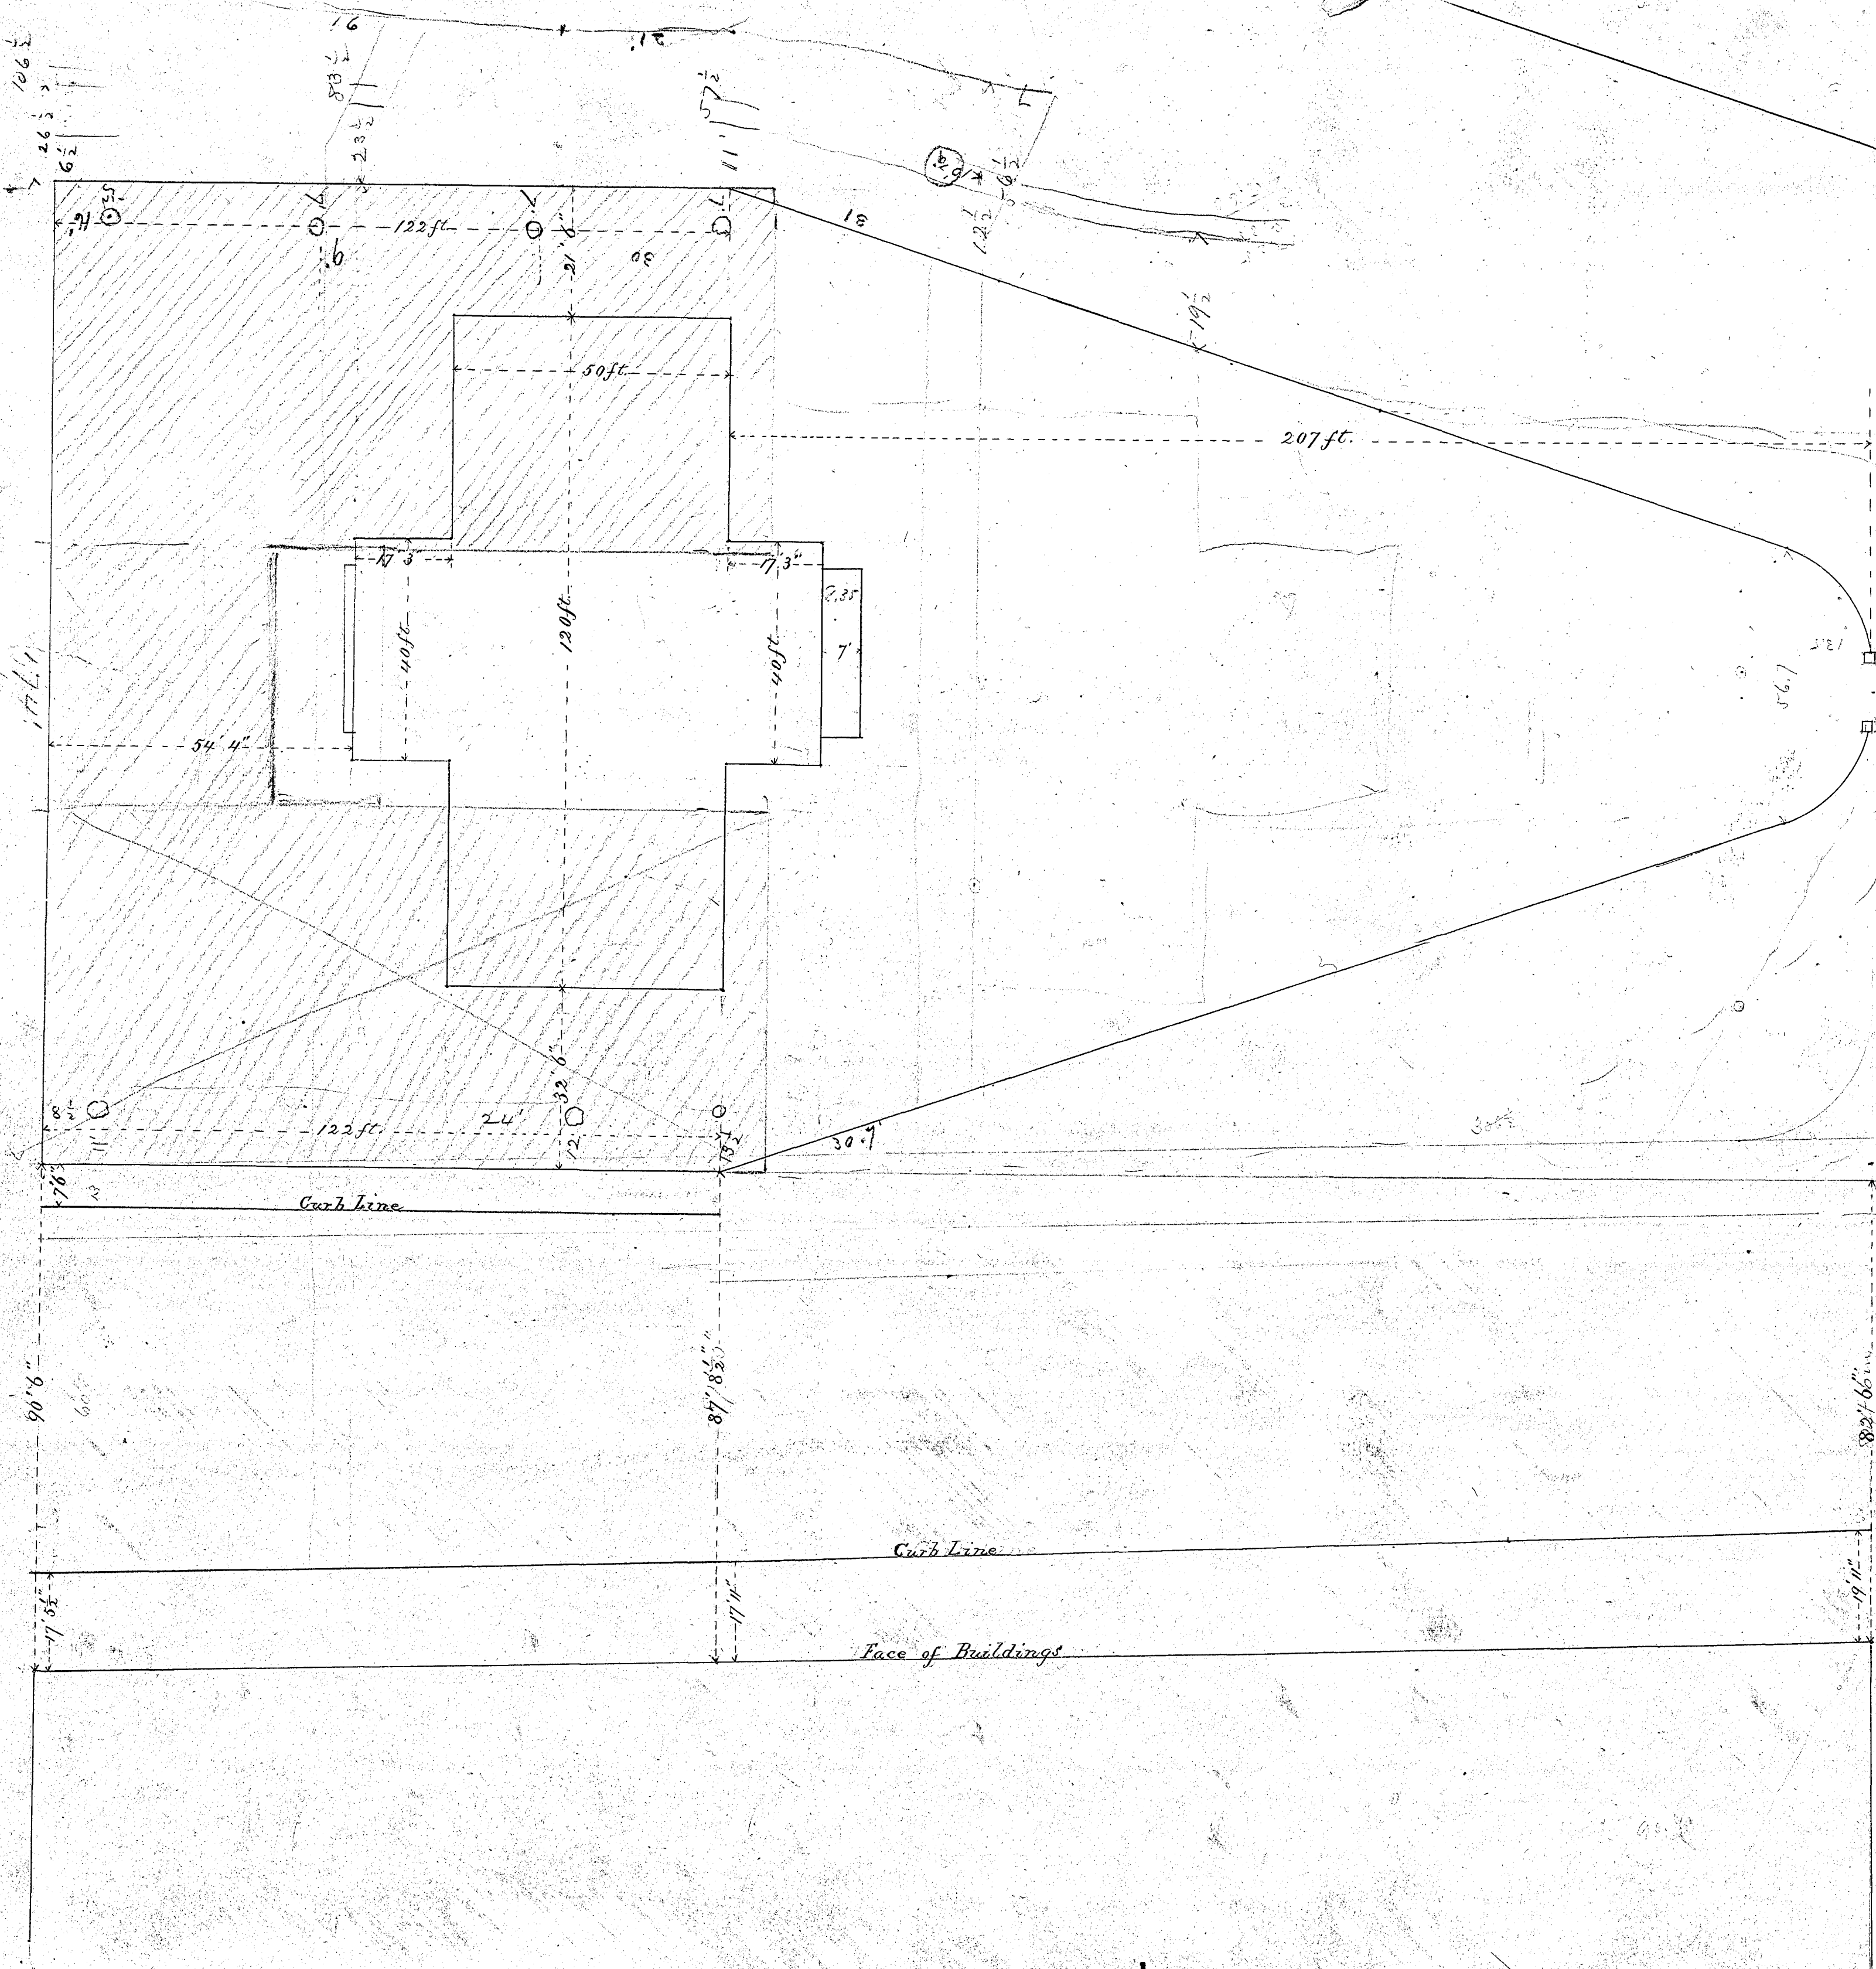

36	183.3
37.4	172.5
38	8.8
39	208.9
40	
41	
180
- 80
90
240
330

See 52
7