


*Fidelia H. Loomis*

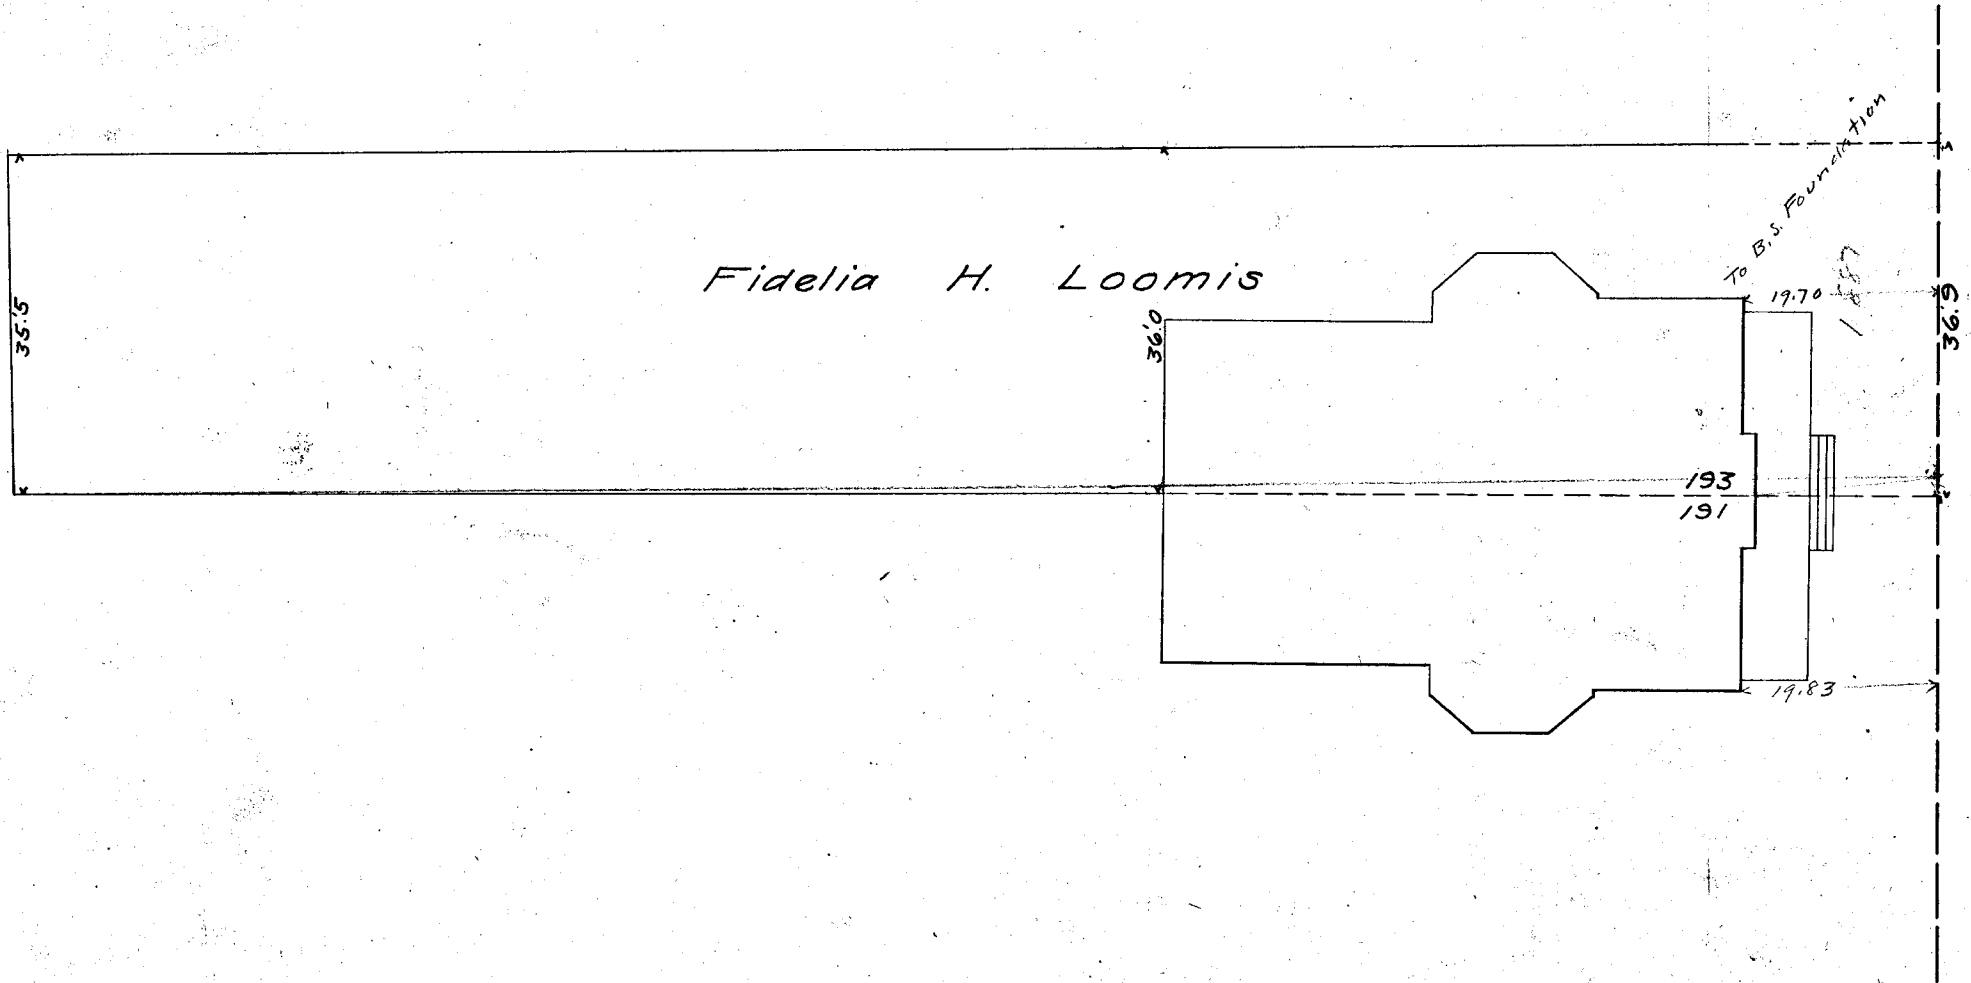

Scale 1" = 20'