

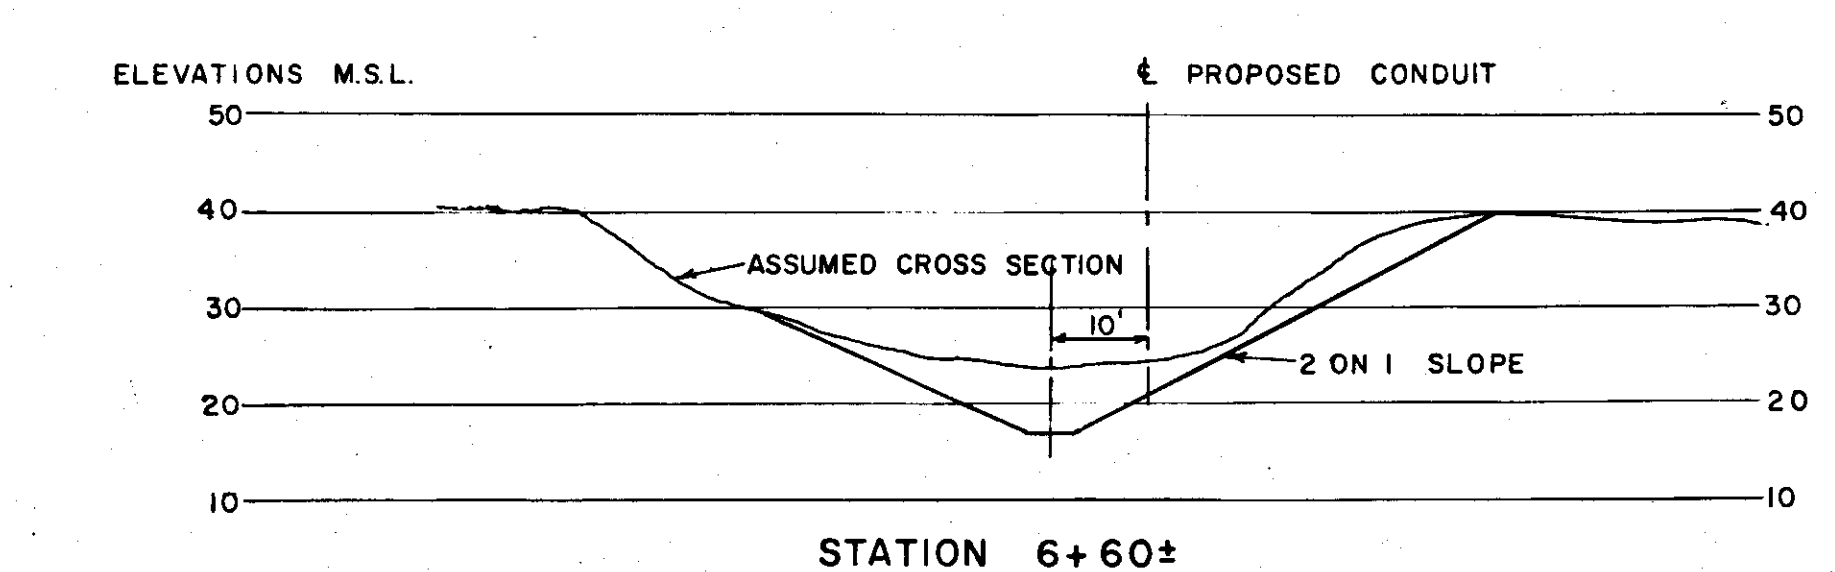
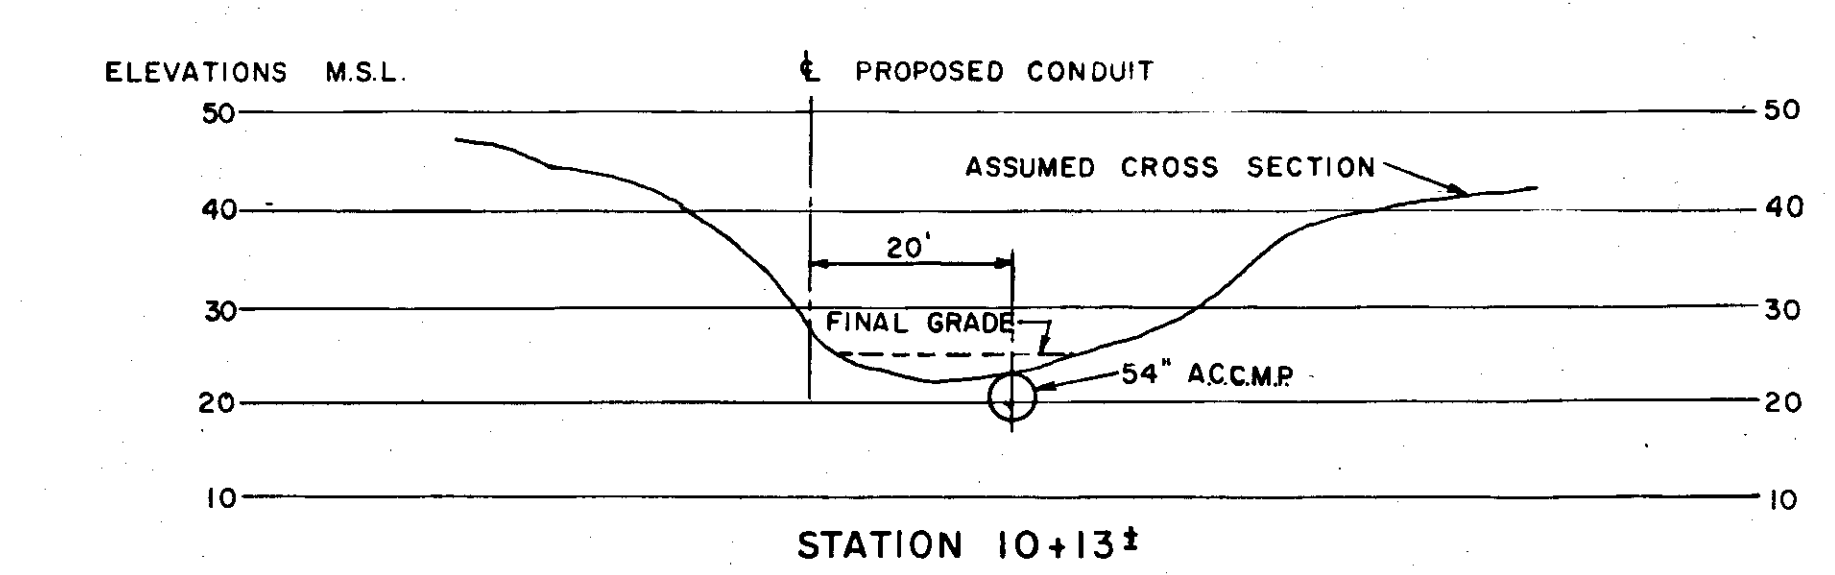


THE INFORMATION, INCLUDING ESTIMATED QUANTITIES OF WORK, SHOWN ON THESE SHEETS IS BASED ON LIMITED INVESTIGATIONS BY THE FLOOD COMMISSION AND IS IN NO WAY WARRANTED TO INDICATE THE TRUE CONDITIONS OR ACTUAL QUANTITIES OR DISTRIBUTION OF QUANTITIES OF WORK WHICH WILL BE REQUIRED.

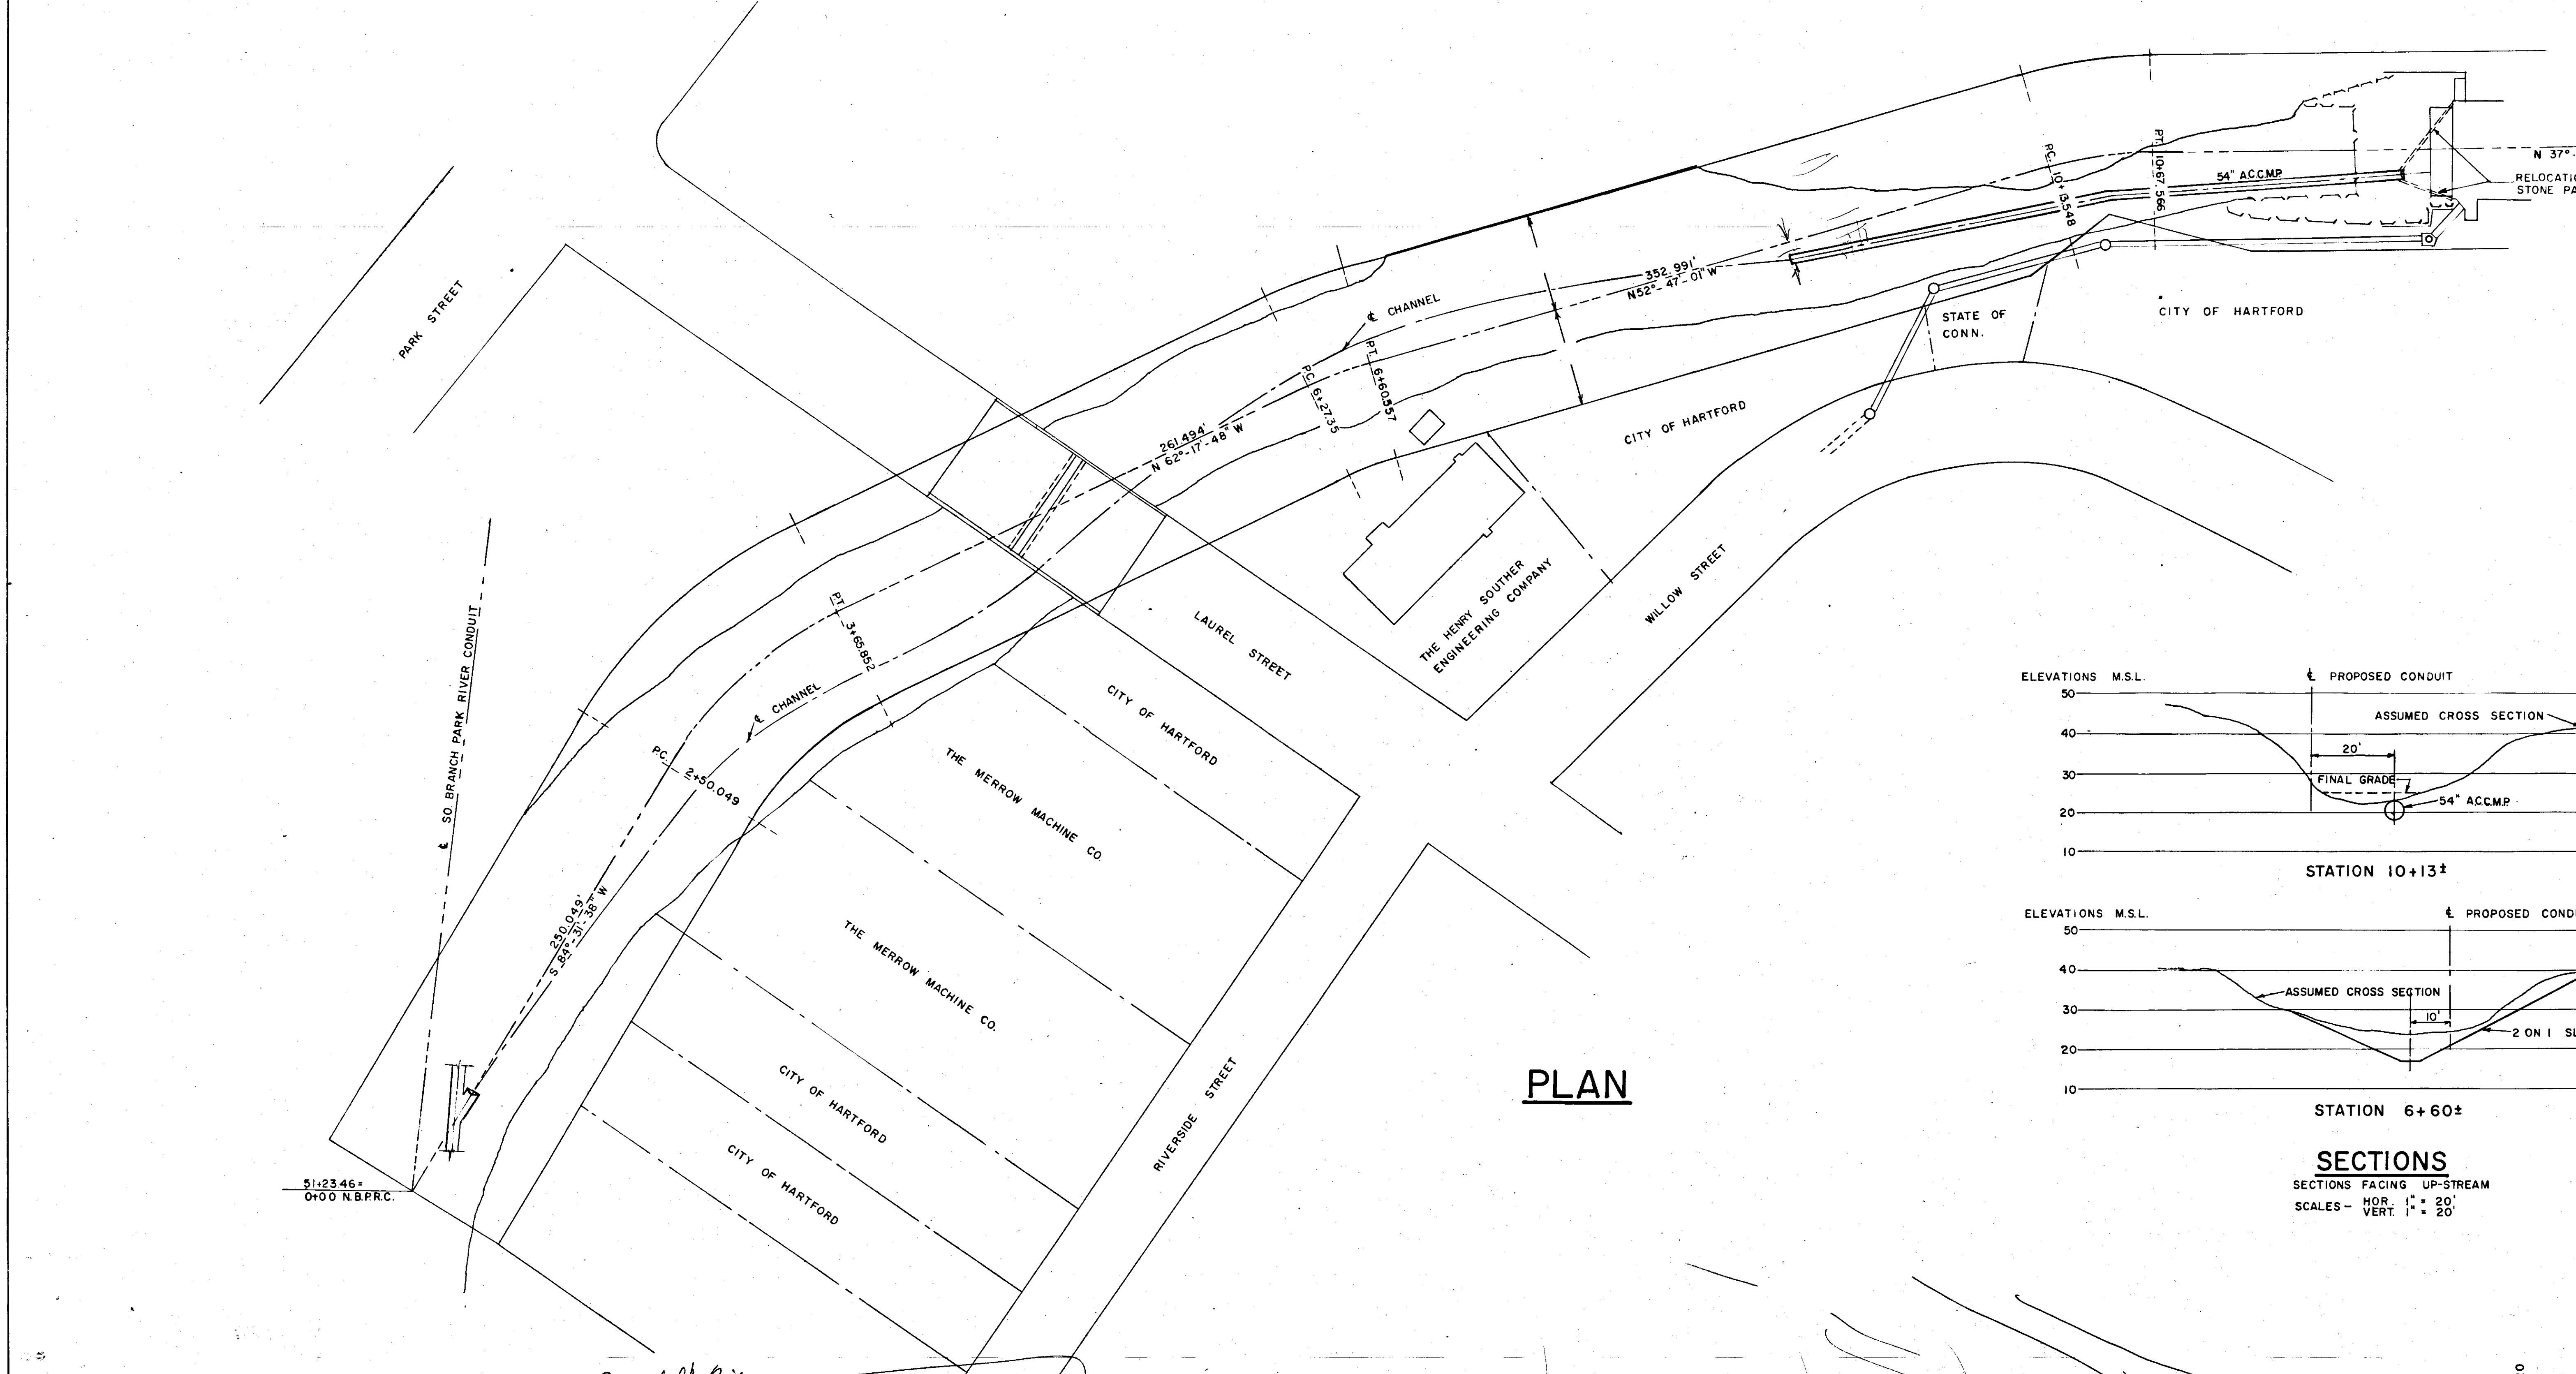

SECTIONS  
SECTIONS FACING UP-STREAM  
SCALES - HOR. 1" = 20'  
VERT. 1" = 20'

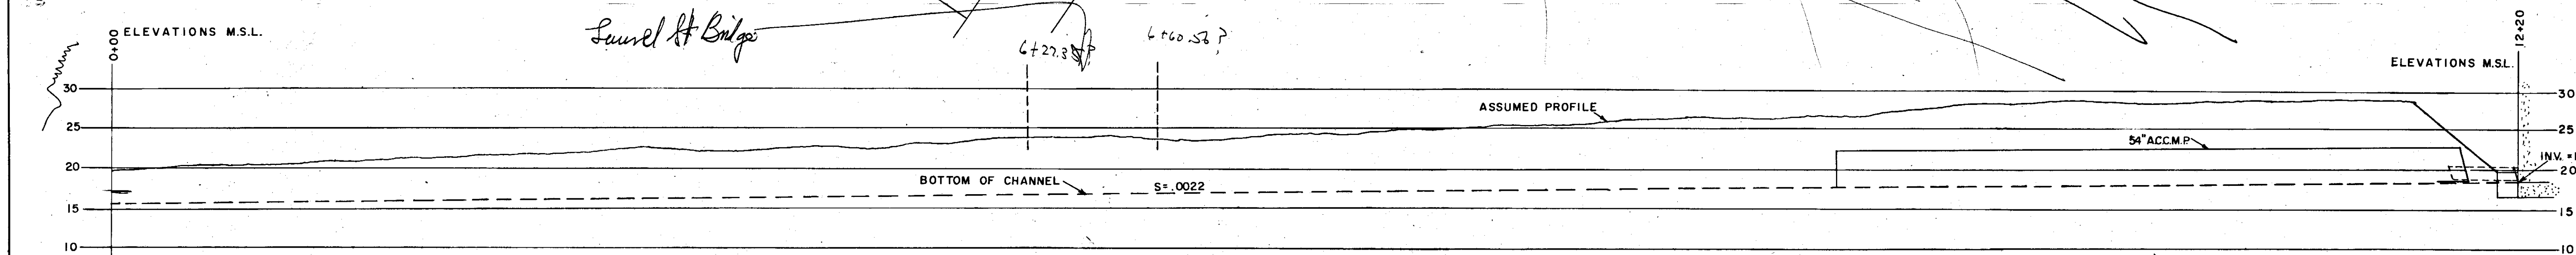

PRELIMINARY

GREATER HARTFORD FLOOD COMMISSION HARTFORD, CONNECTICUT		
DESIGNED BY R.E.M.	PILOT CHANNEL NORTH BRANCH PARK RIVER HARTFORD, CONNECTICUT STATION 0+00 TO STATION 12+20	
TRACED BY P.W.H.		
CHECKED BY		
SCALE 1" = 40' OR AS INDICATED		
DATE AUG. 1, 1969		
APPROVED BY PE. CONN. NO. 3725	DRAWING NUMBER CONTRACT 1969-1 SHEET 2 OF 2	
DIRECTOR		