



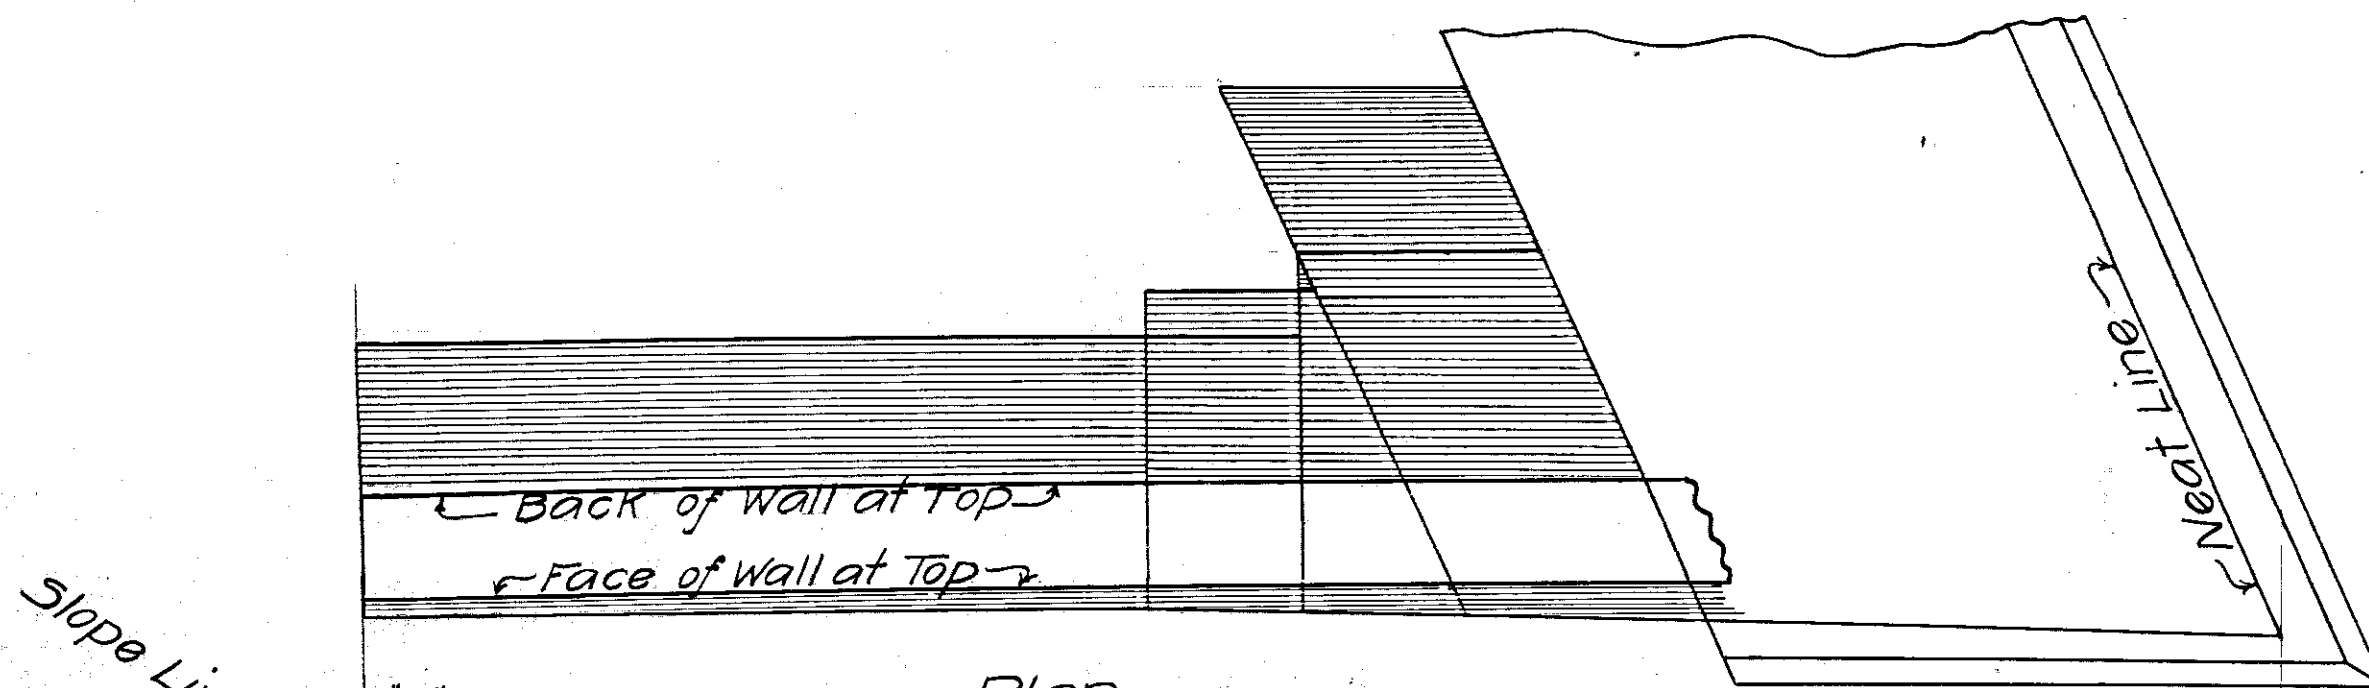

Slope Line 1 1/2 to 1

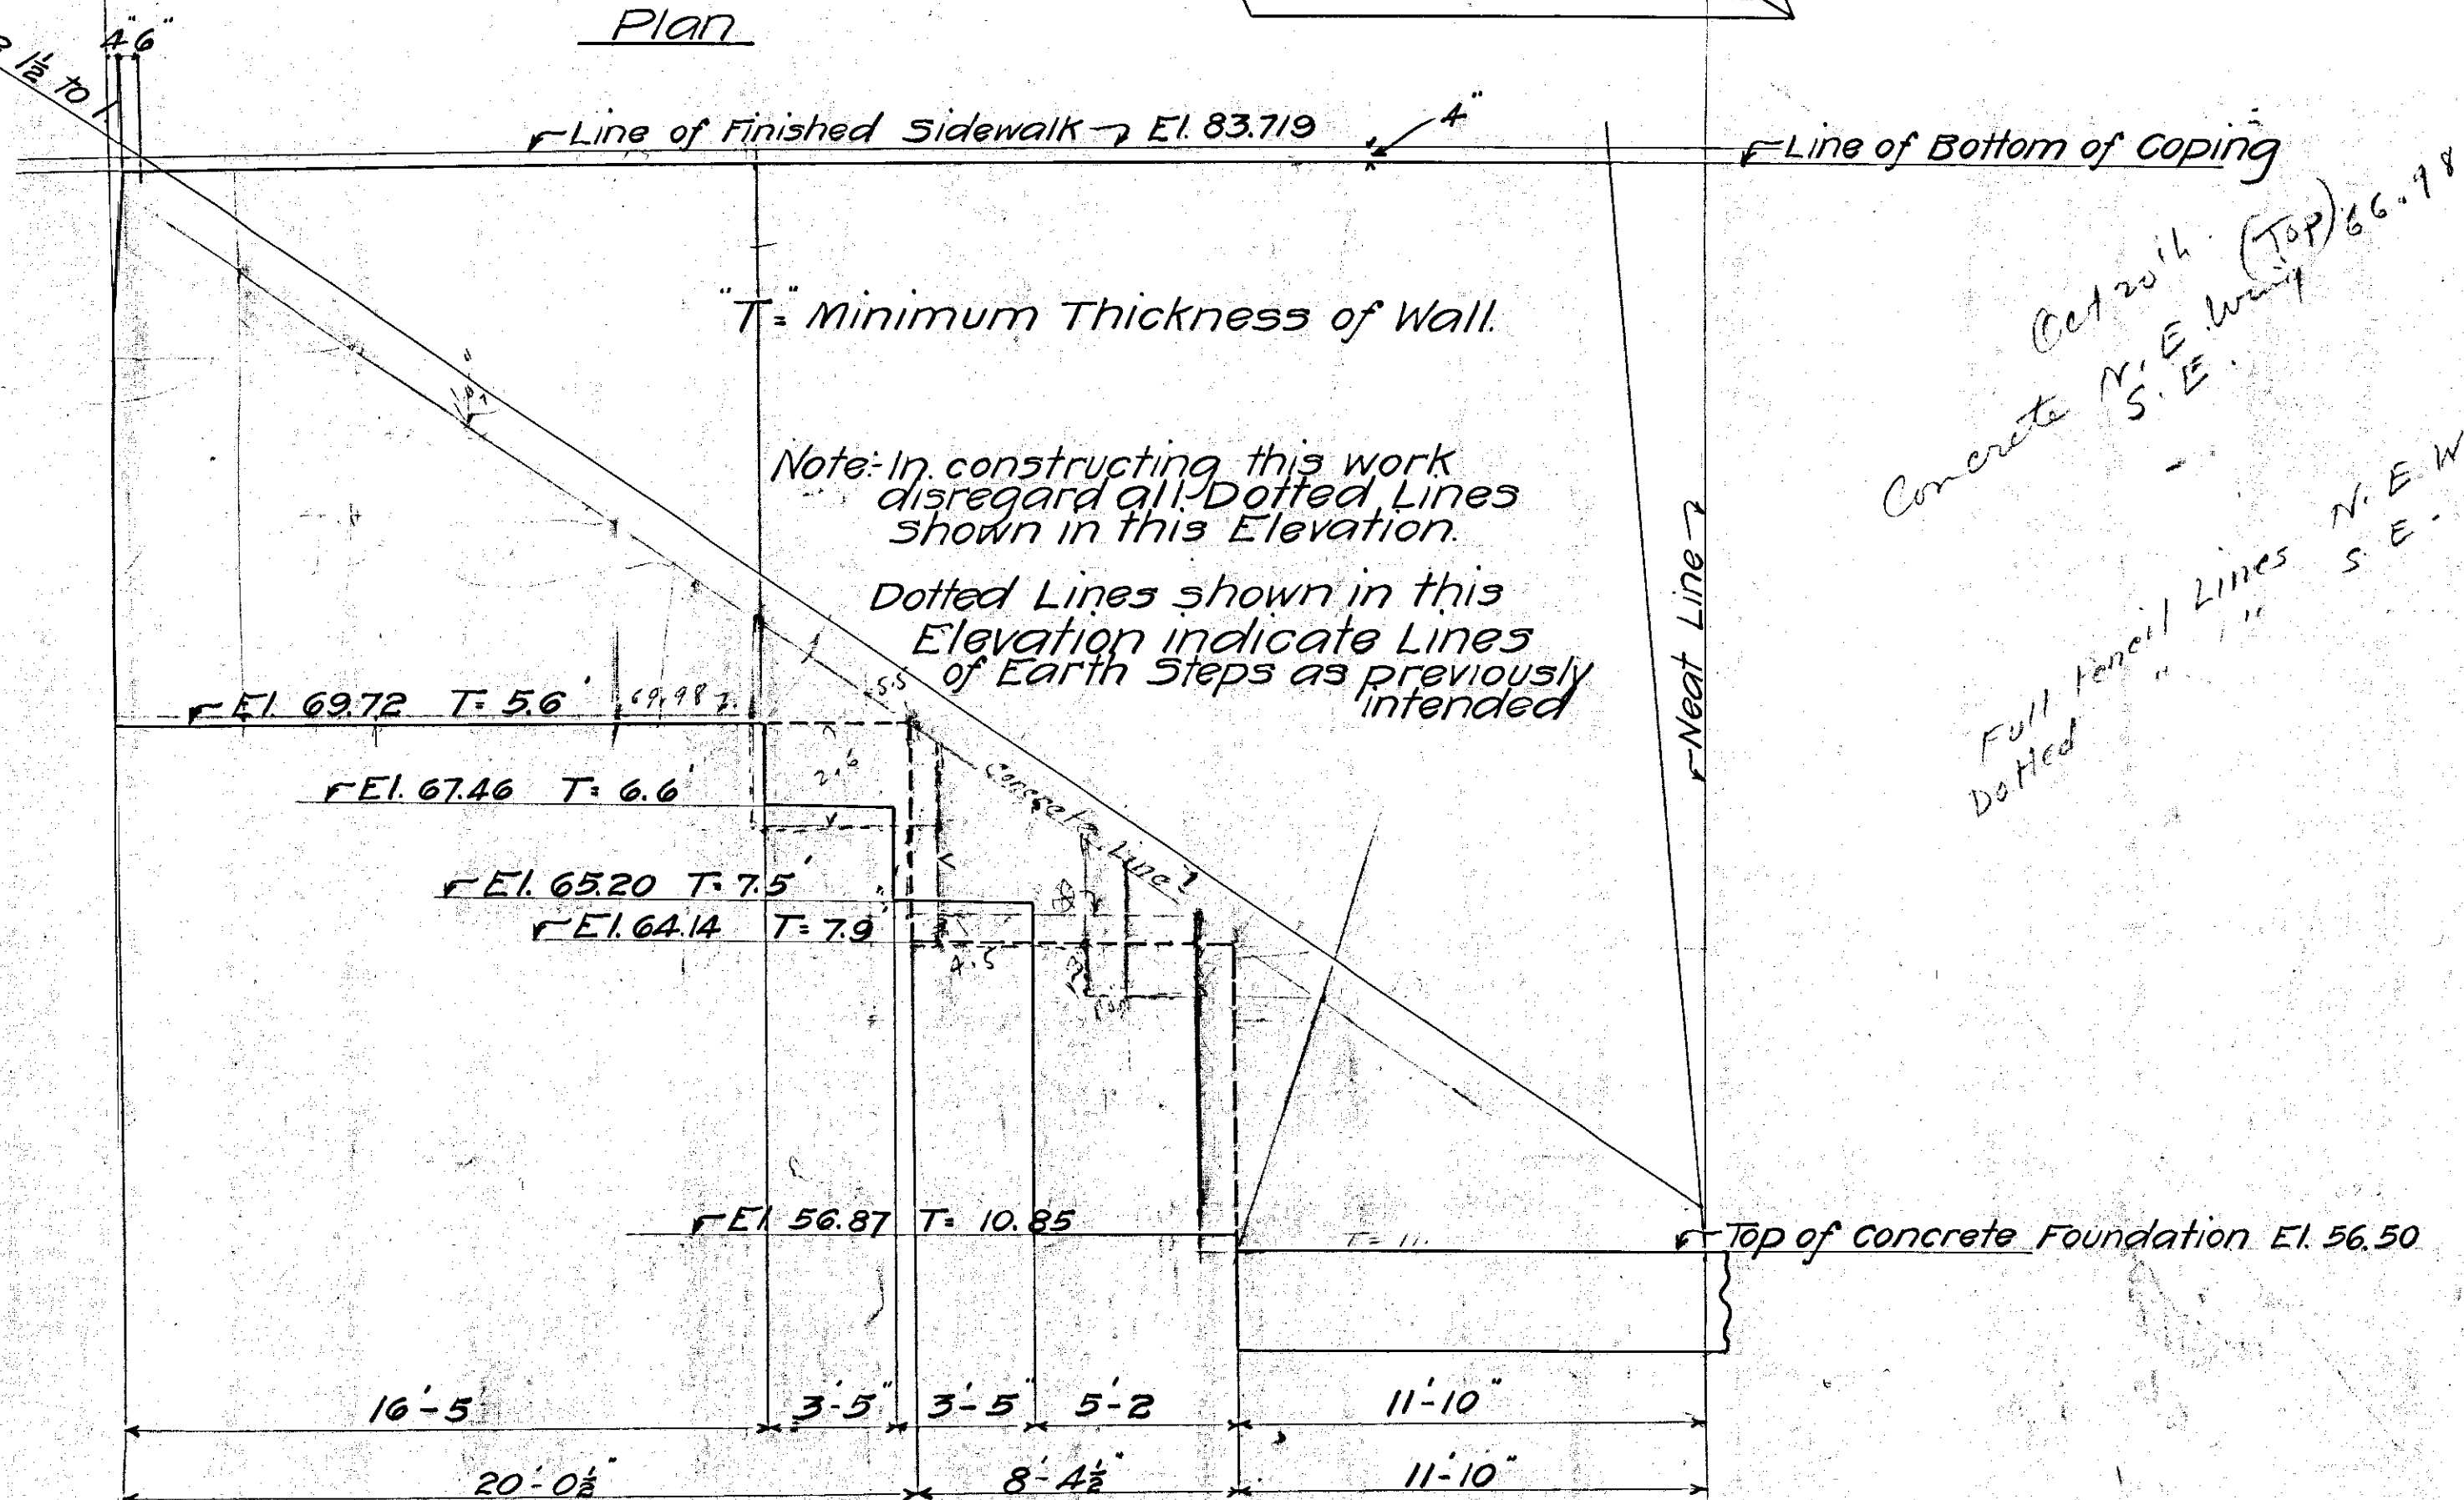

Oct 20th (Top) 66.98

Concrete N.E. Wing S.E.

Full Fencil Lines N.E. Wing S.E.

Elevation of South Wing Wall

West Abutment

Highway Bridge at Albany Ave.

04117

Scale 1/4" = one foot October 6 1905