




25 GREENFIELD 22
188

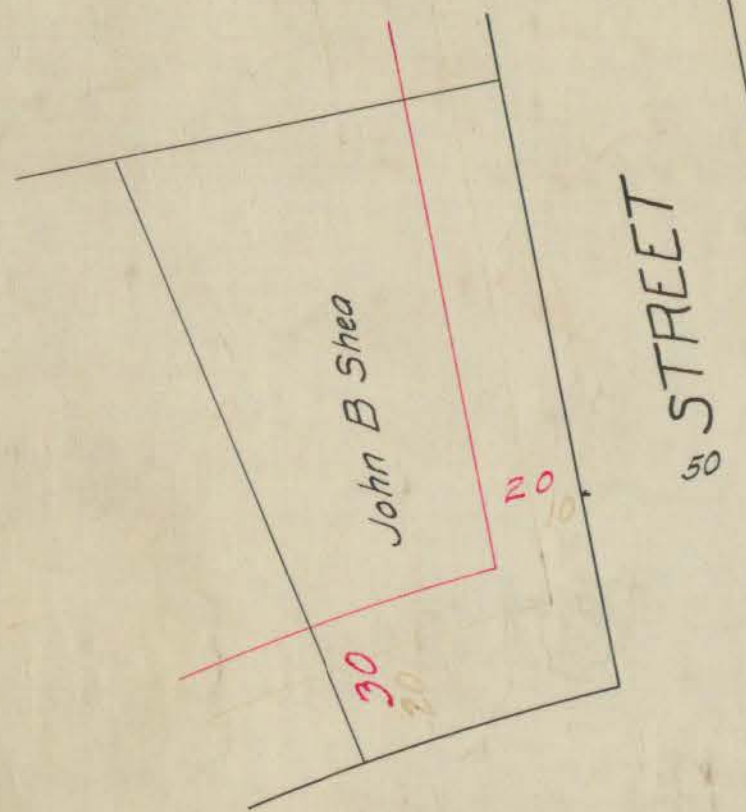



STREET
50

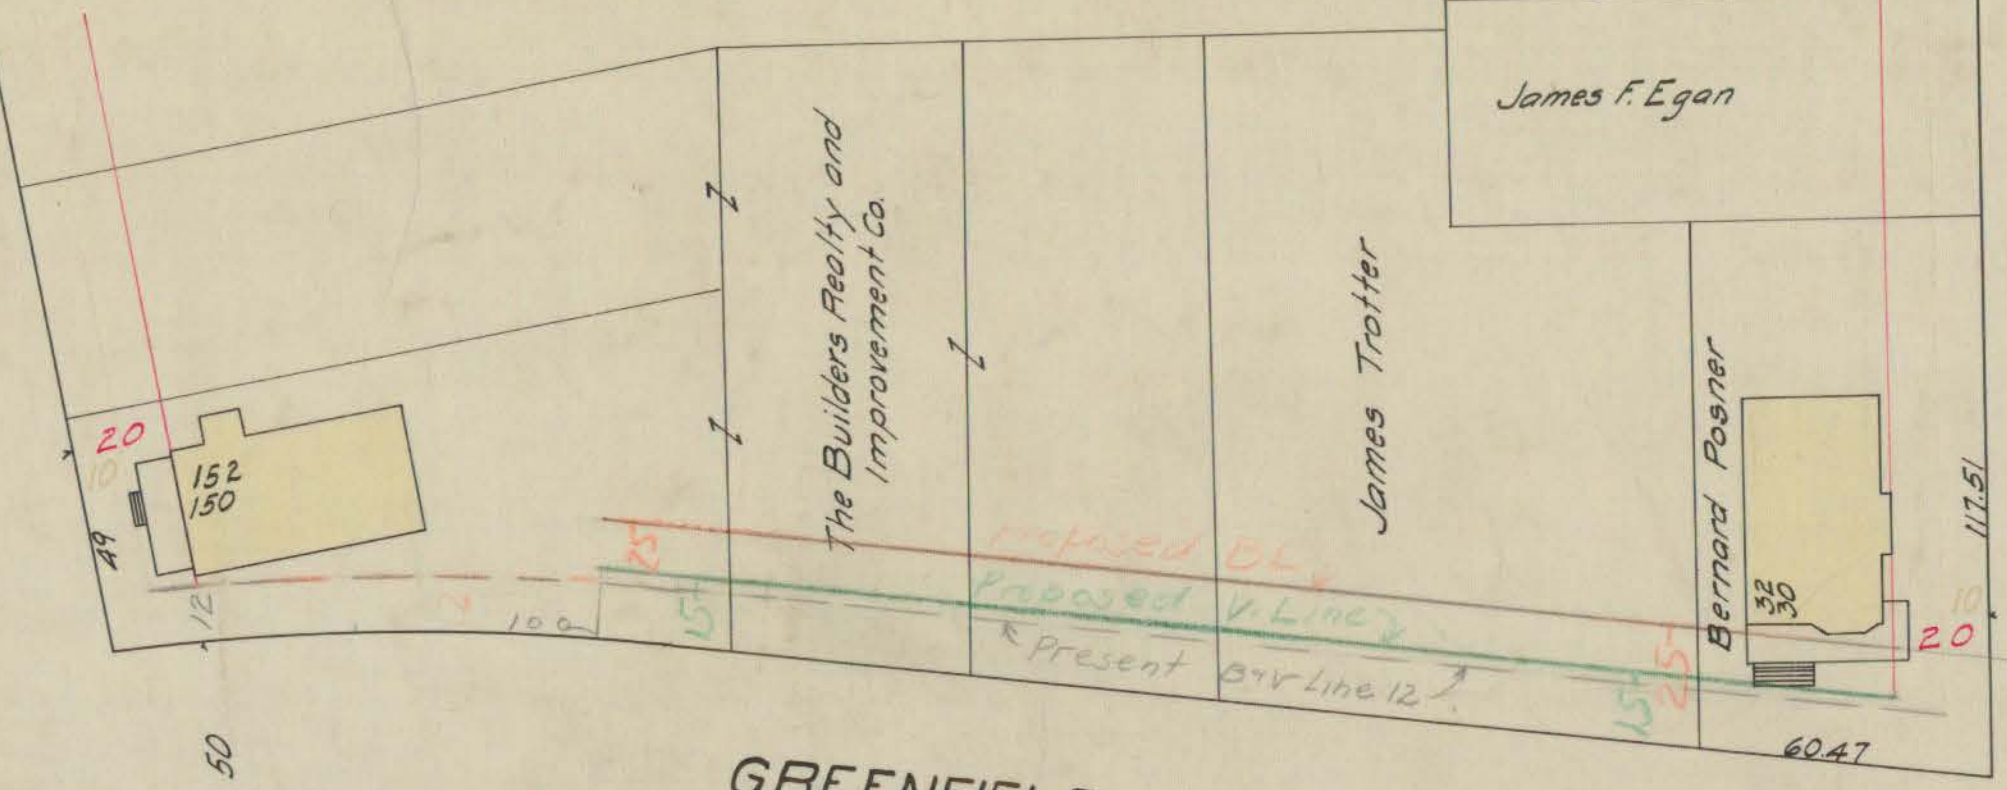


STREET
50

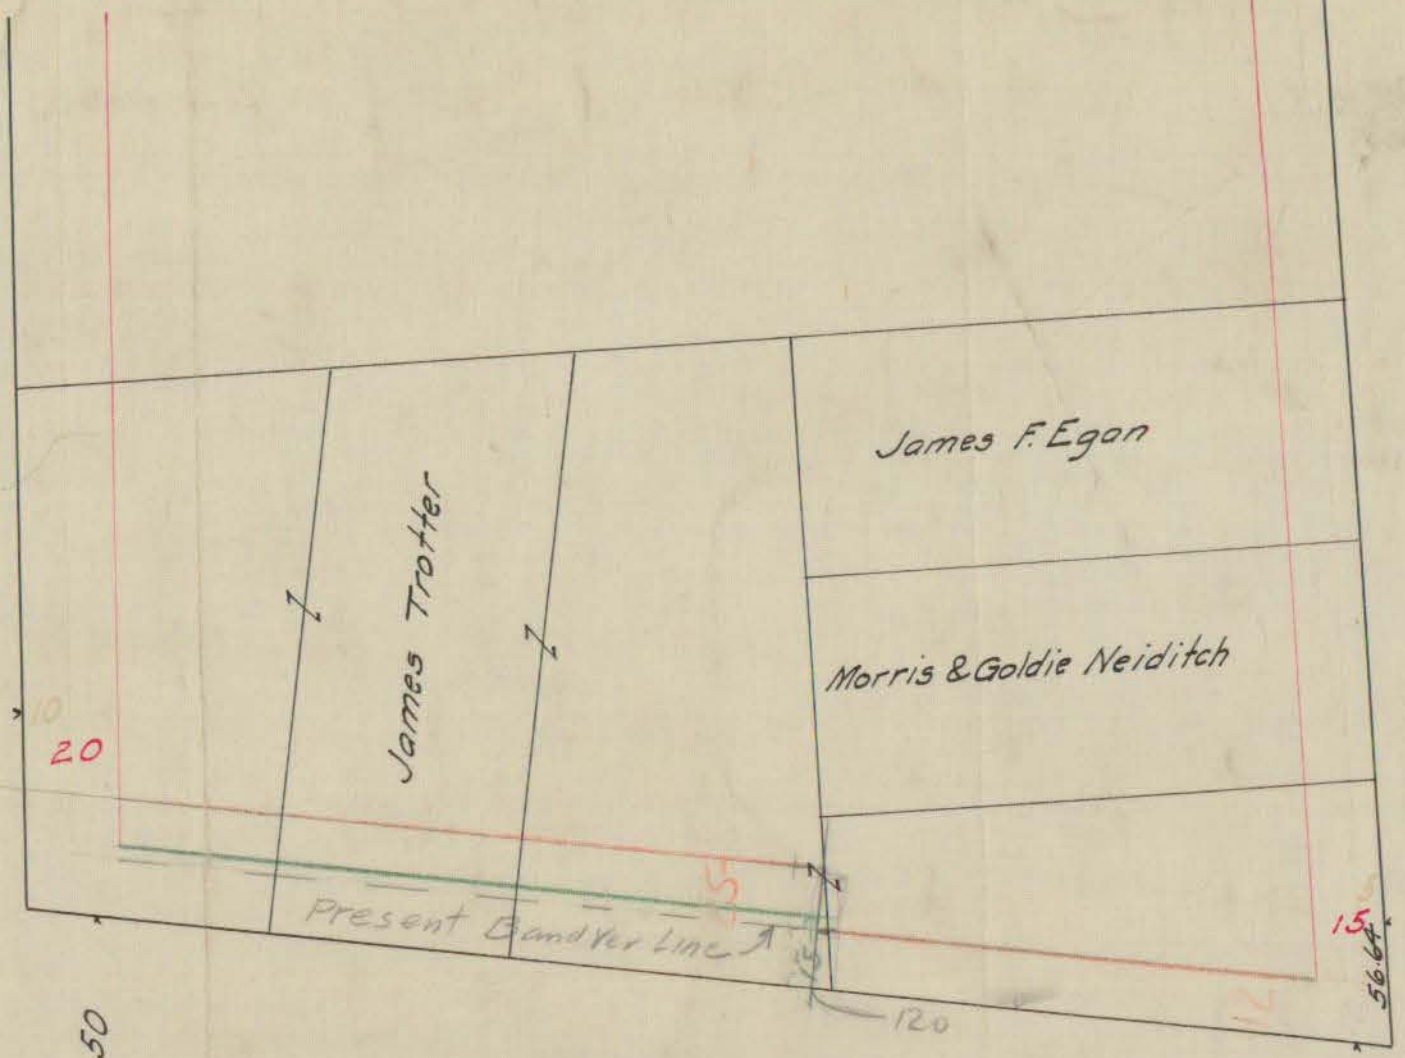


STREET
50

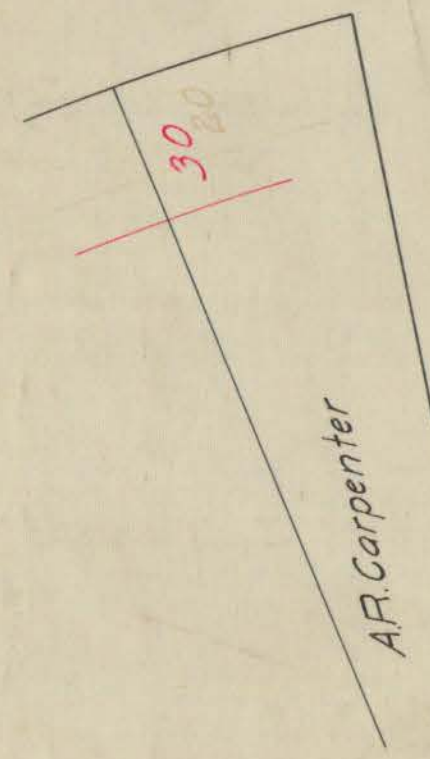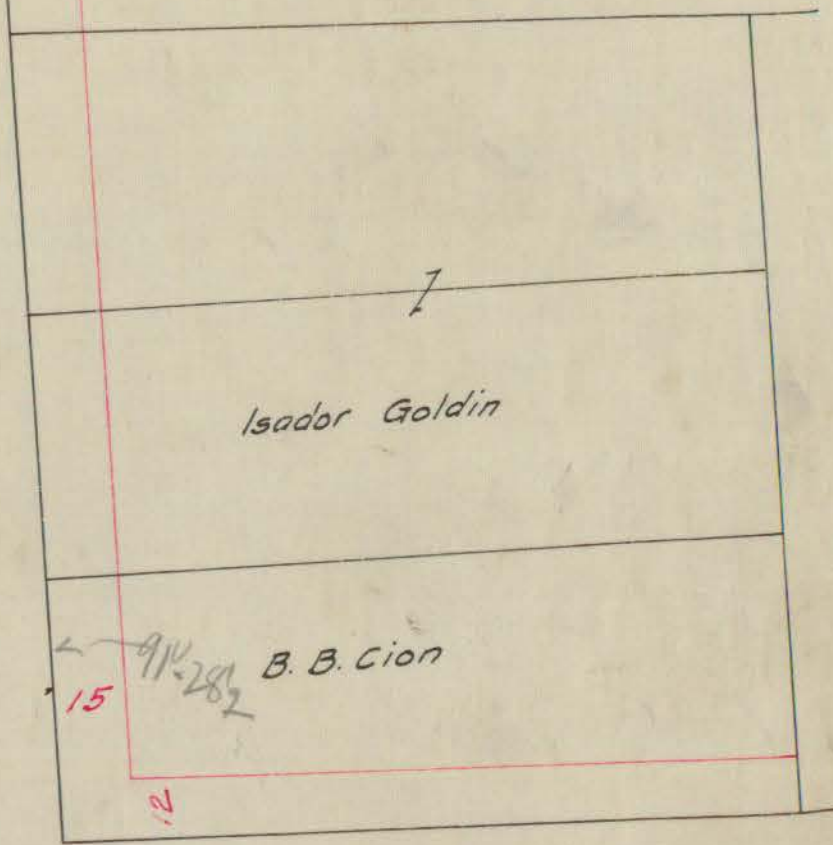


MIDDLEFIELD

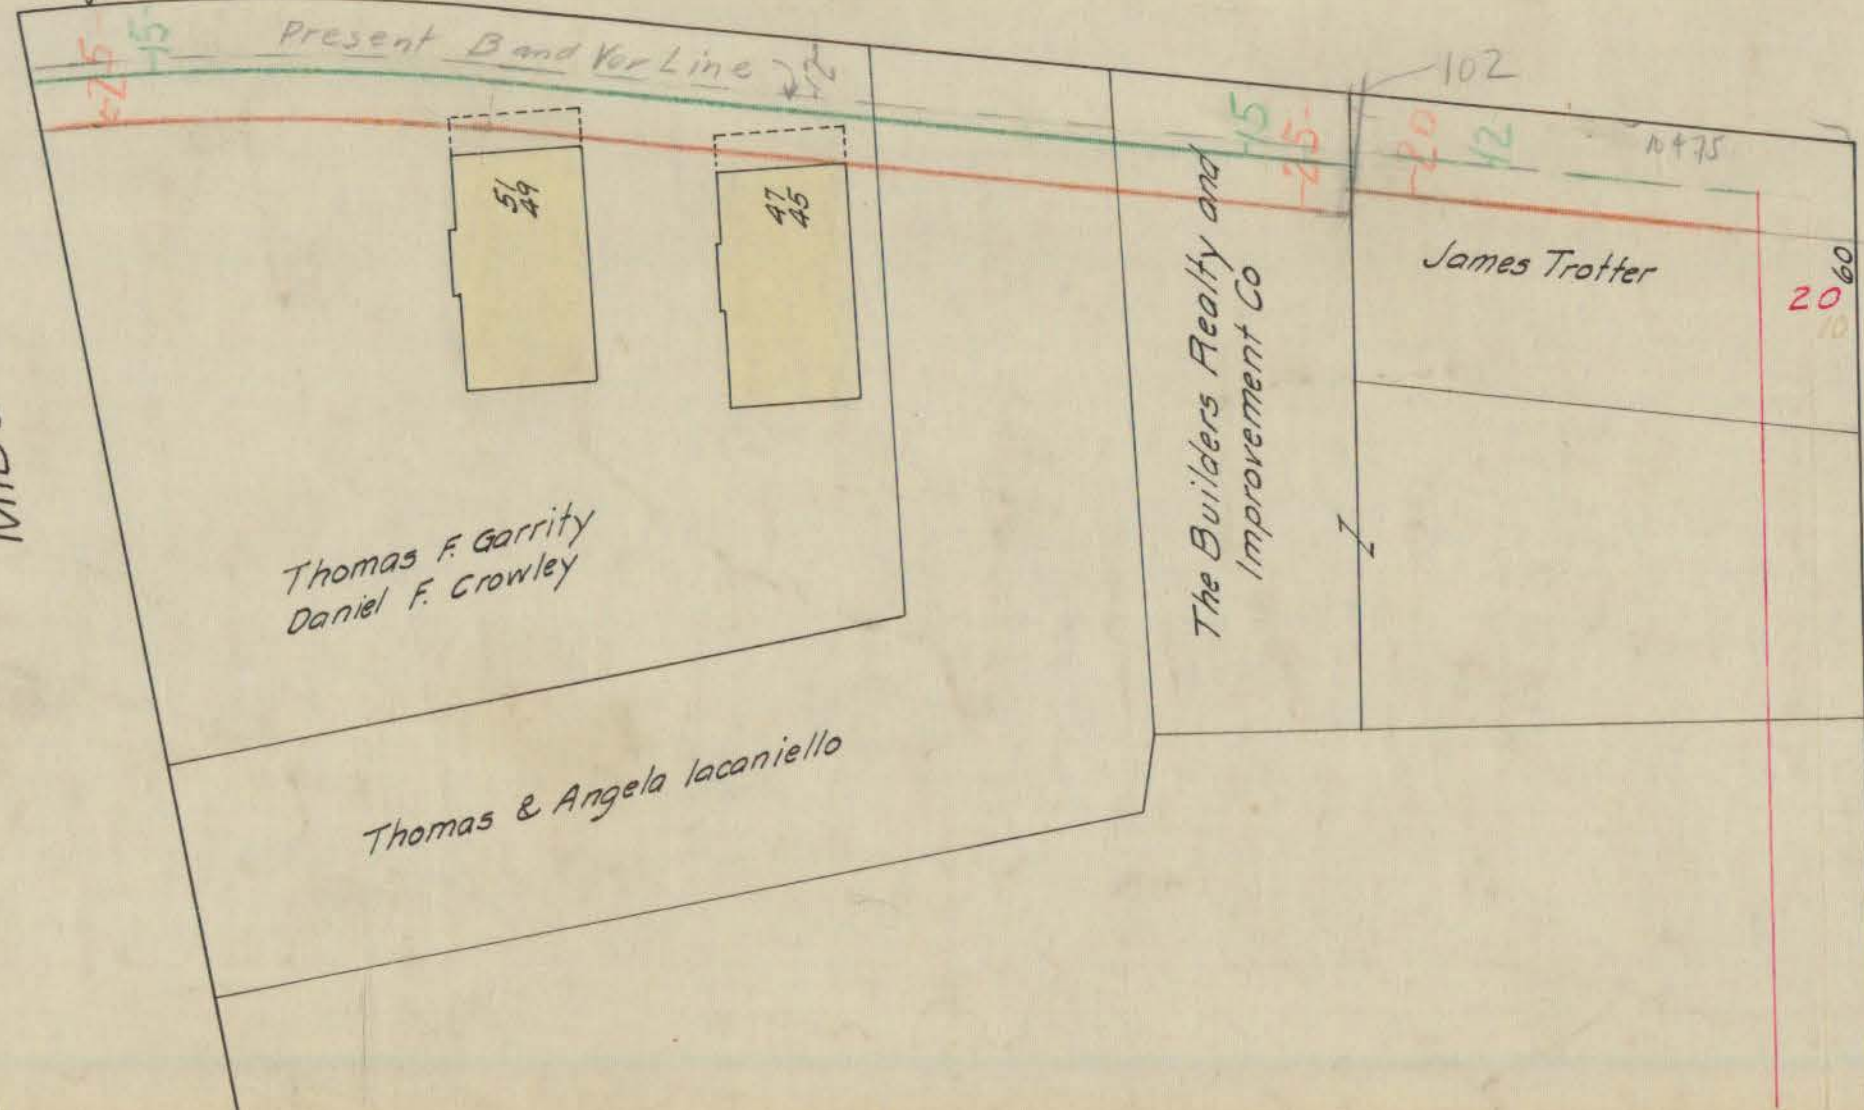

ENFIELD

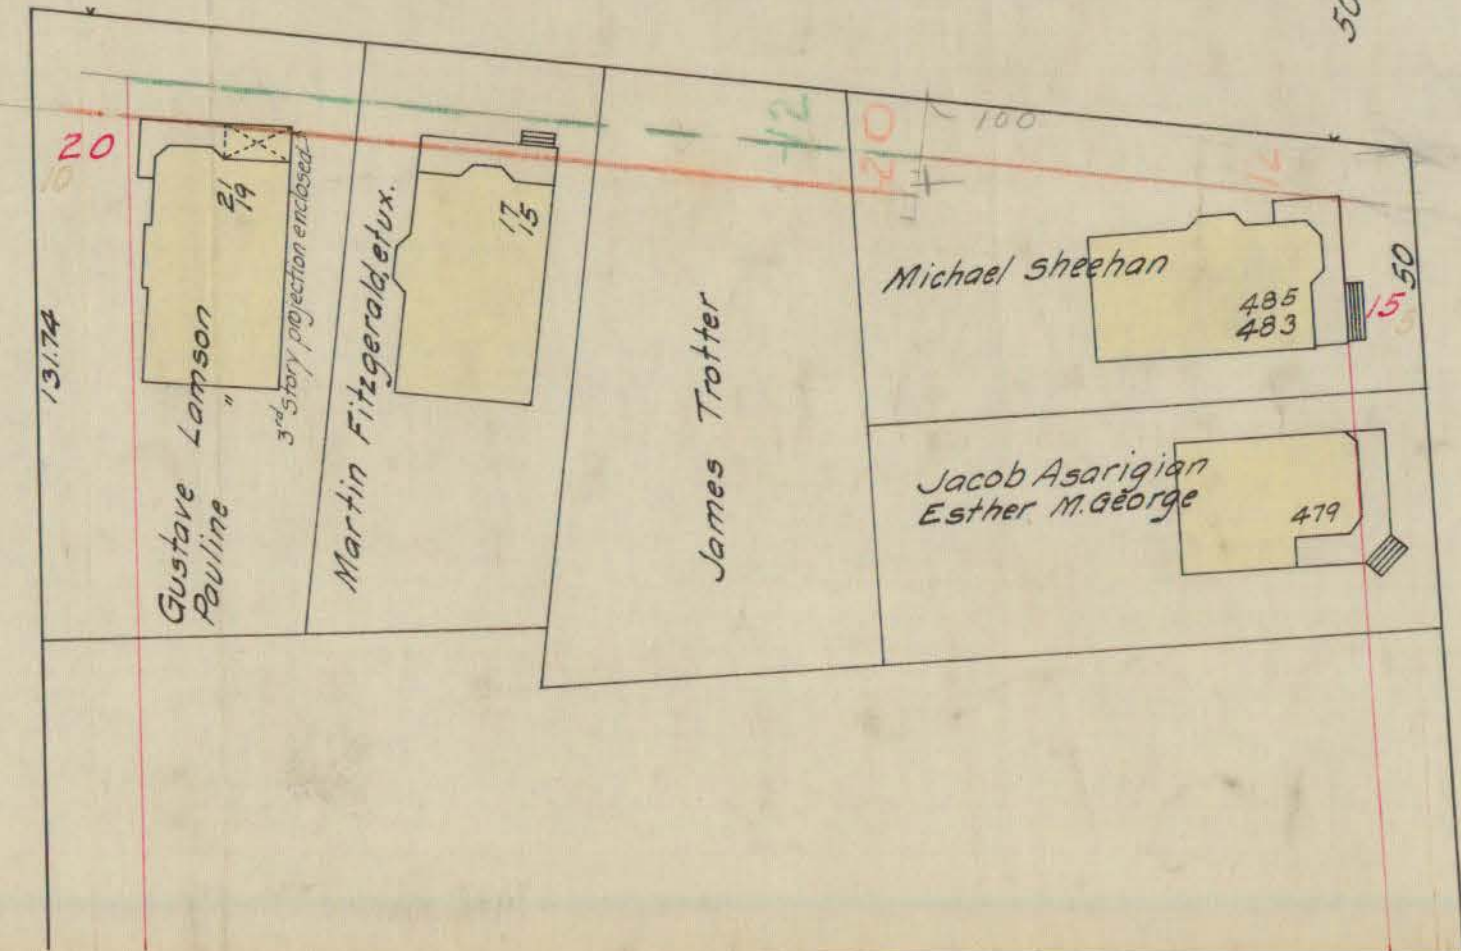

GARDEN

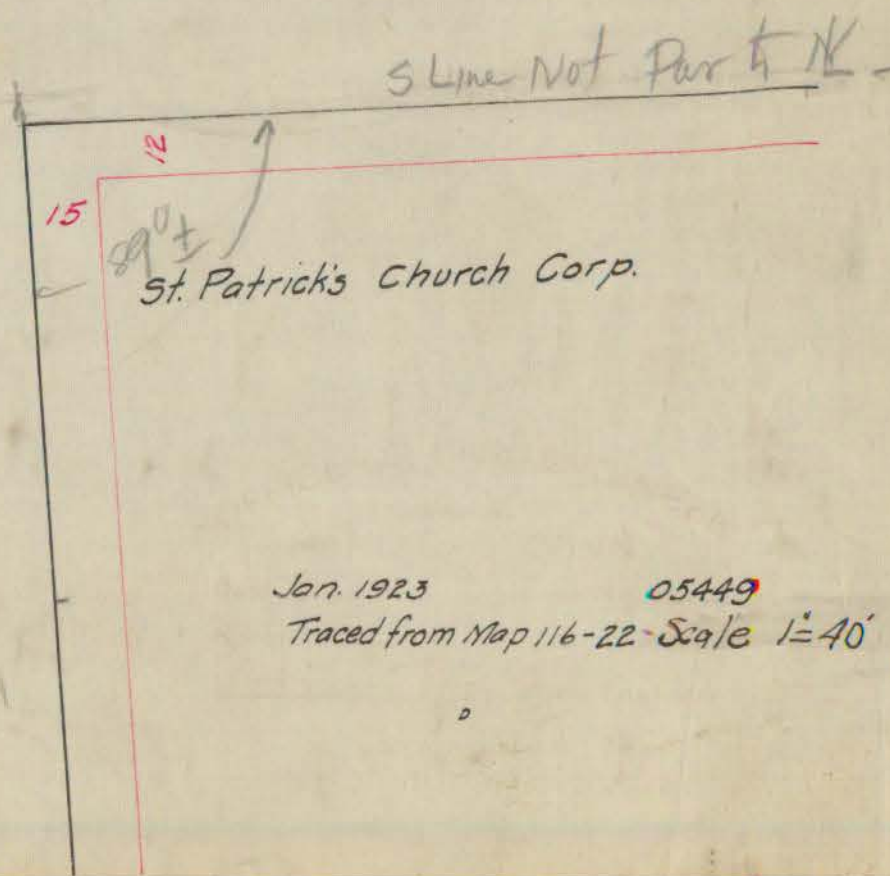

Jan. 1923
Traced from Map 116-22 Scale 1"=40'

05449