


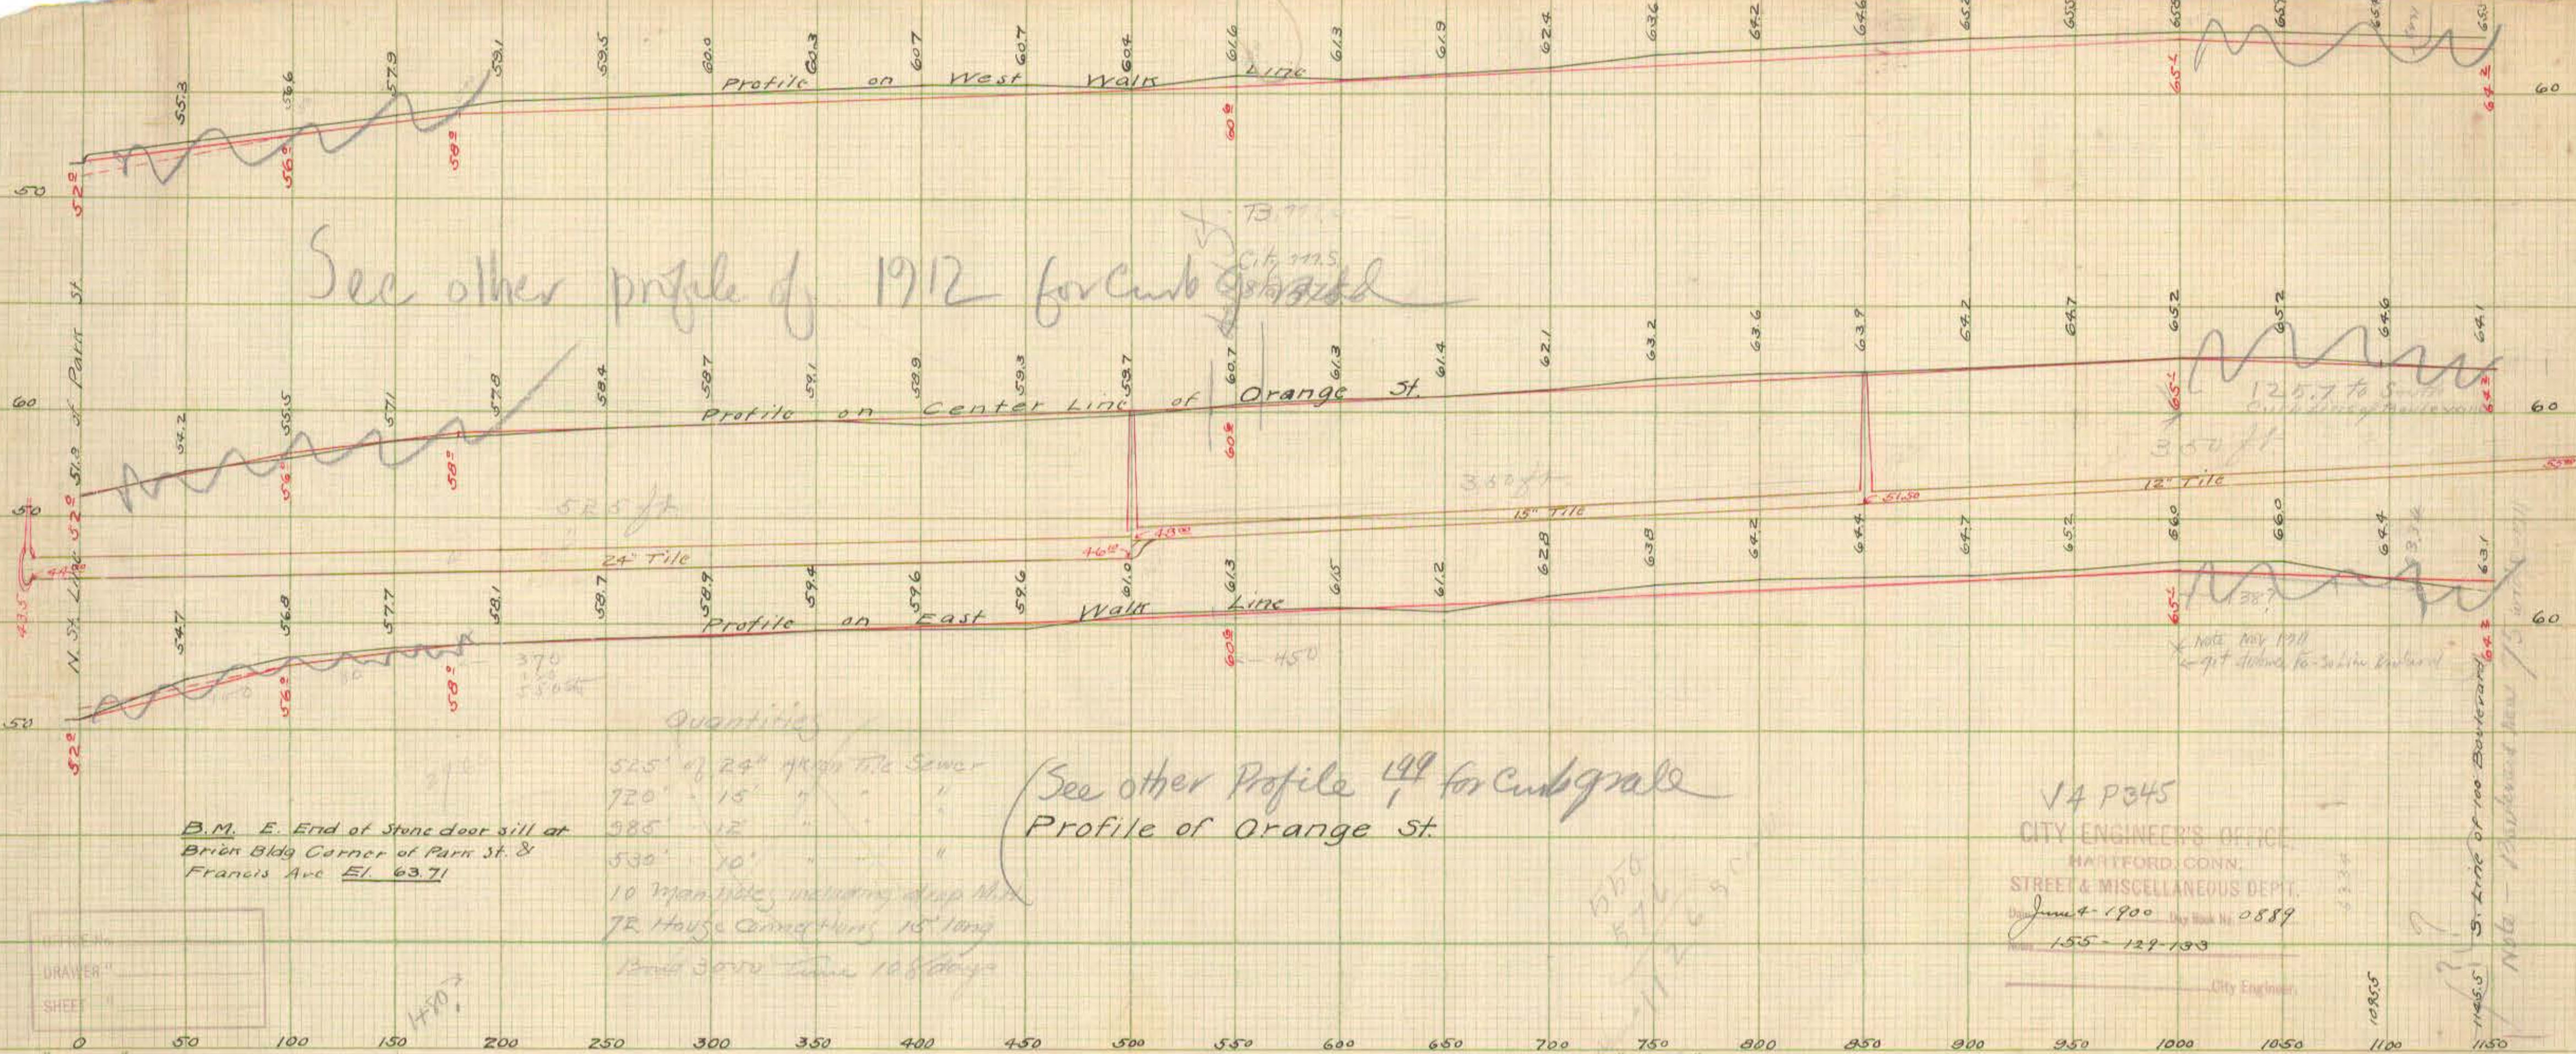

See other profile of 1912 for curb ~~grate~~ ^{city m.s.}

(See other Profile 149 for Curb grate Profile of Orange St.)

B.M. E. End of Stone door sill at
Brick Bldg Corner of Palm St. &
Francis Ave El. 63.71

Quantities
525' of 24" ~~4" x 4"~~ tile sewer
720' - 15' " "
985' - 12' " "
530' - 10' " "
10 man holes including deep hole
72 House Connections 15' long
12 in 3000 tubes 108 days

V4 P345
CITY ENGINEER'S OFFICE
HARTFORD, CONN.
STREET & MISCELLANEOUS DEPT.
June 4 - 1900 Day Book No. 0889
155-129-133
City Engineer

Note - 100' Boulevard new 15' wide - 1911