

File # 16542
David Hargreaves
Dennis Eardley

See Sheet 114





FREEMAN STREET

STREET Building & Veranda Lines of March 23, 1925

Vol 7-65

AVENUE

STREET

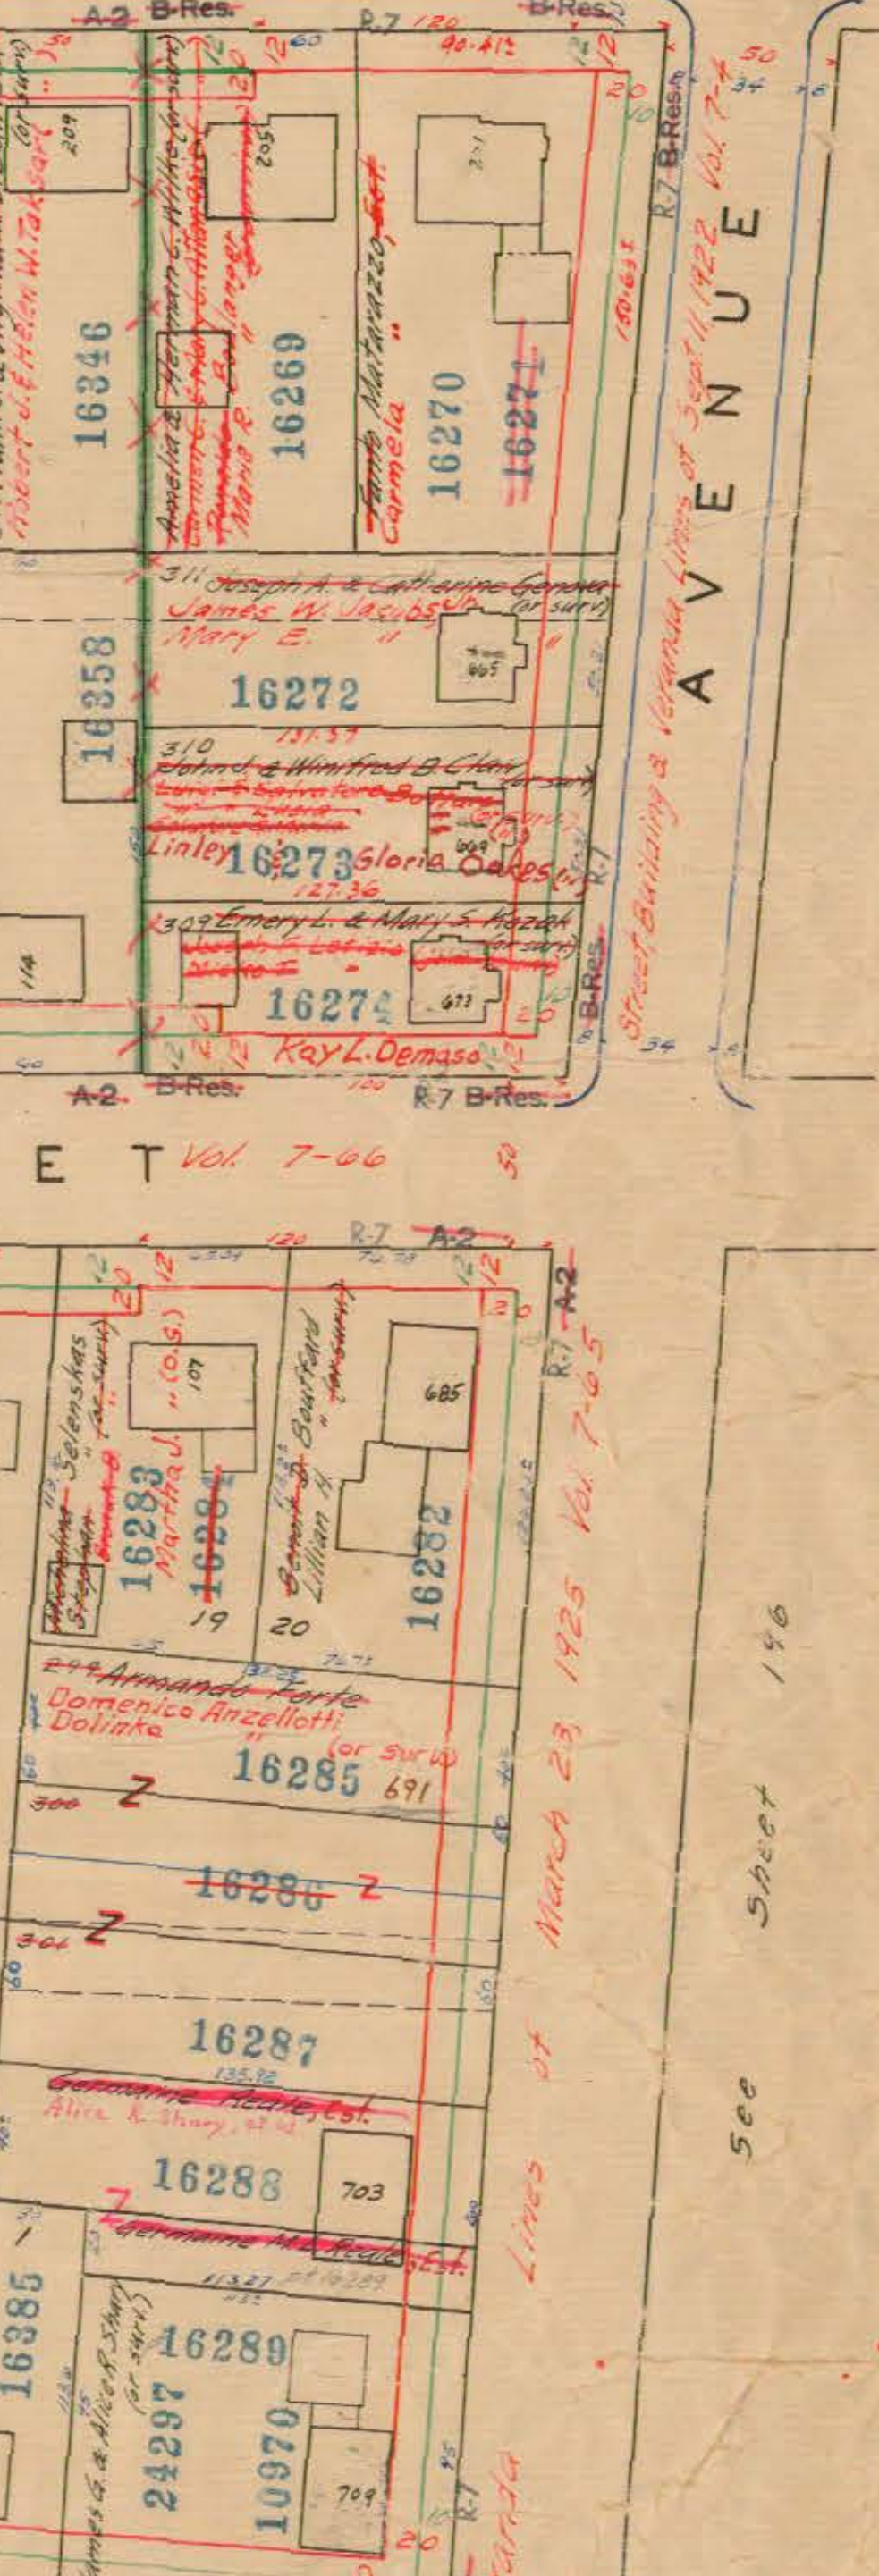
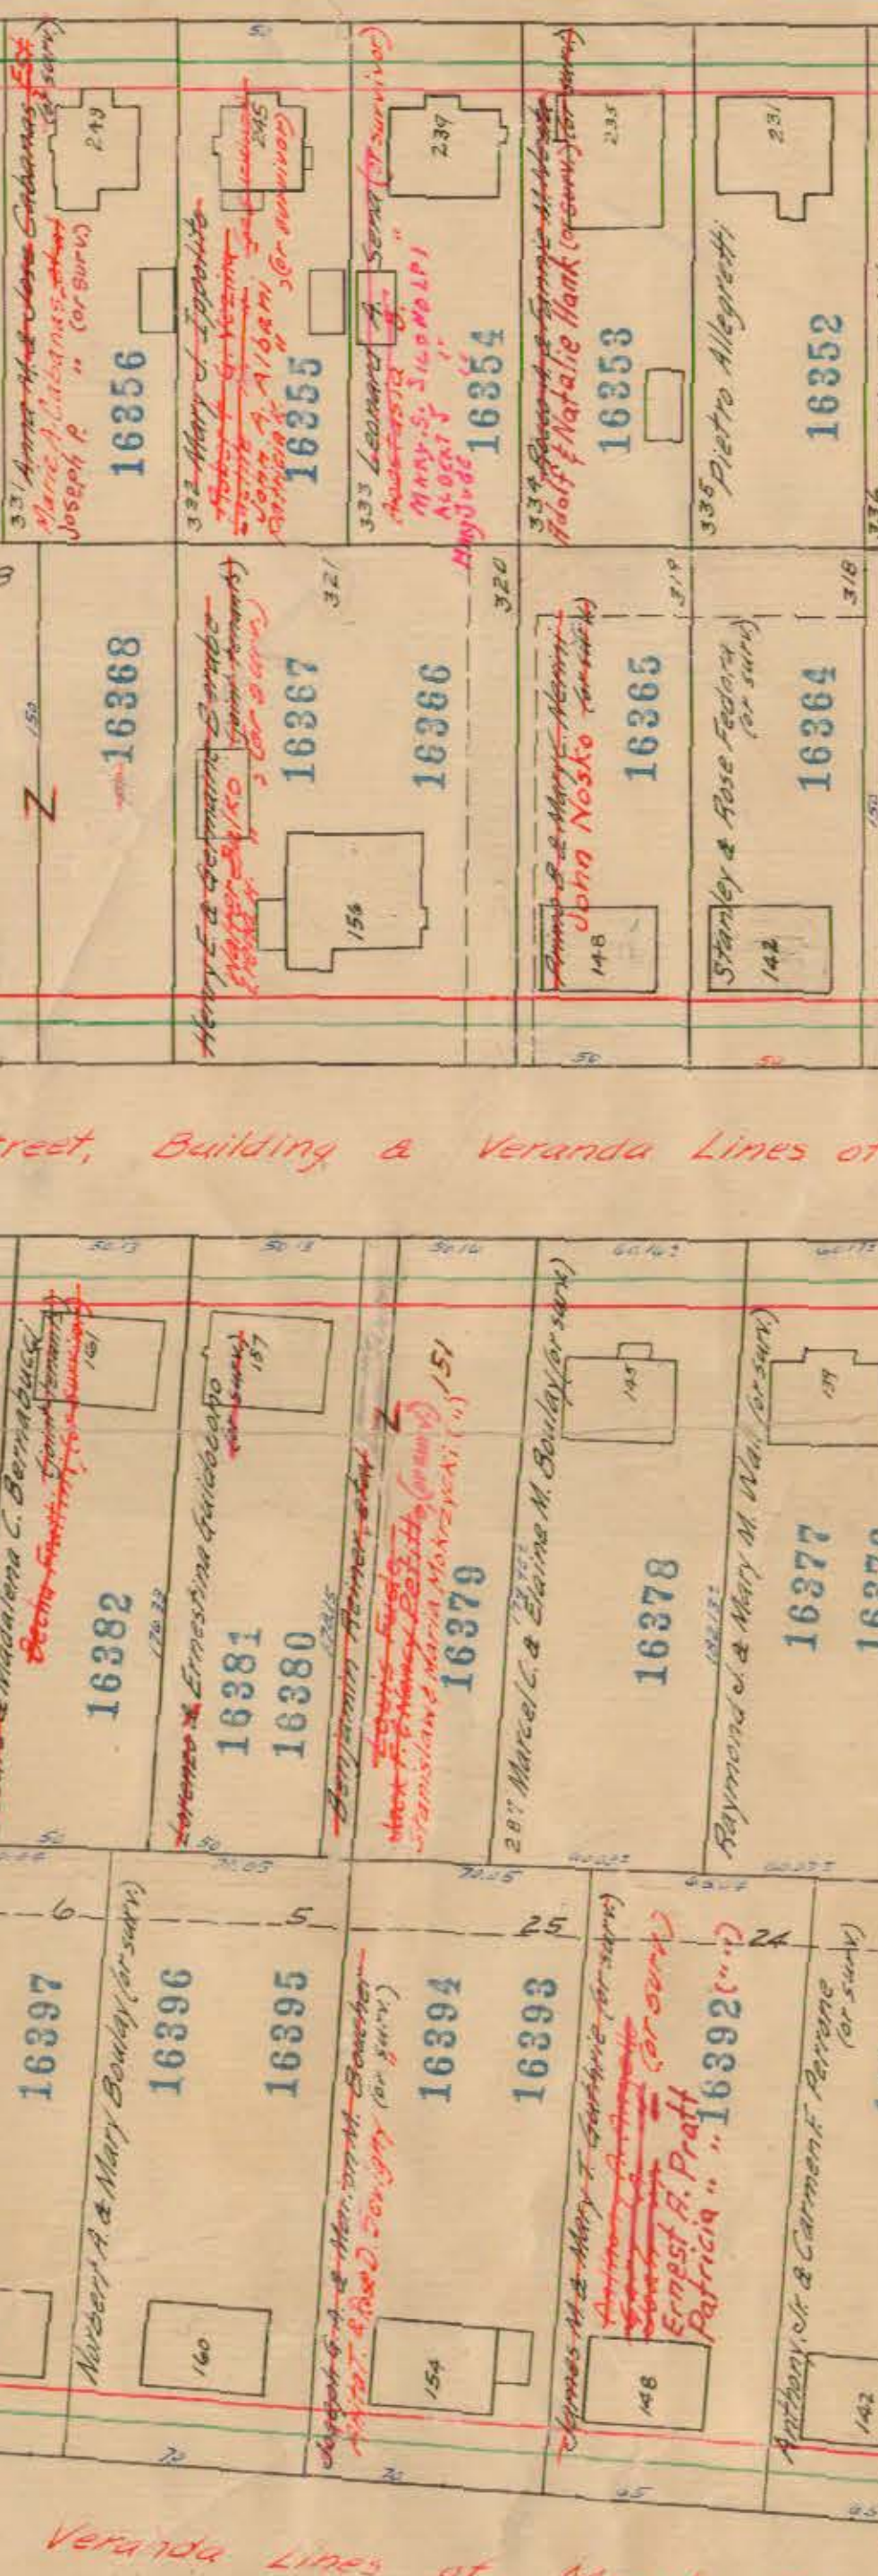
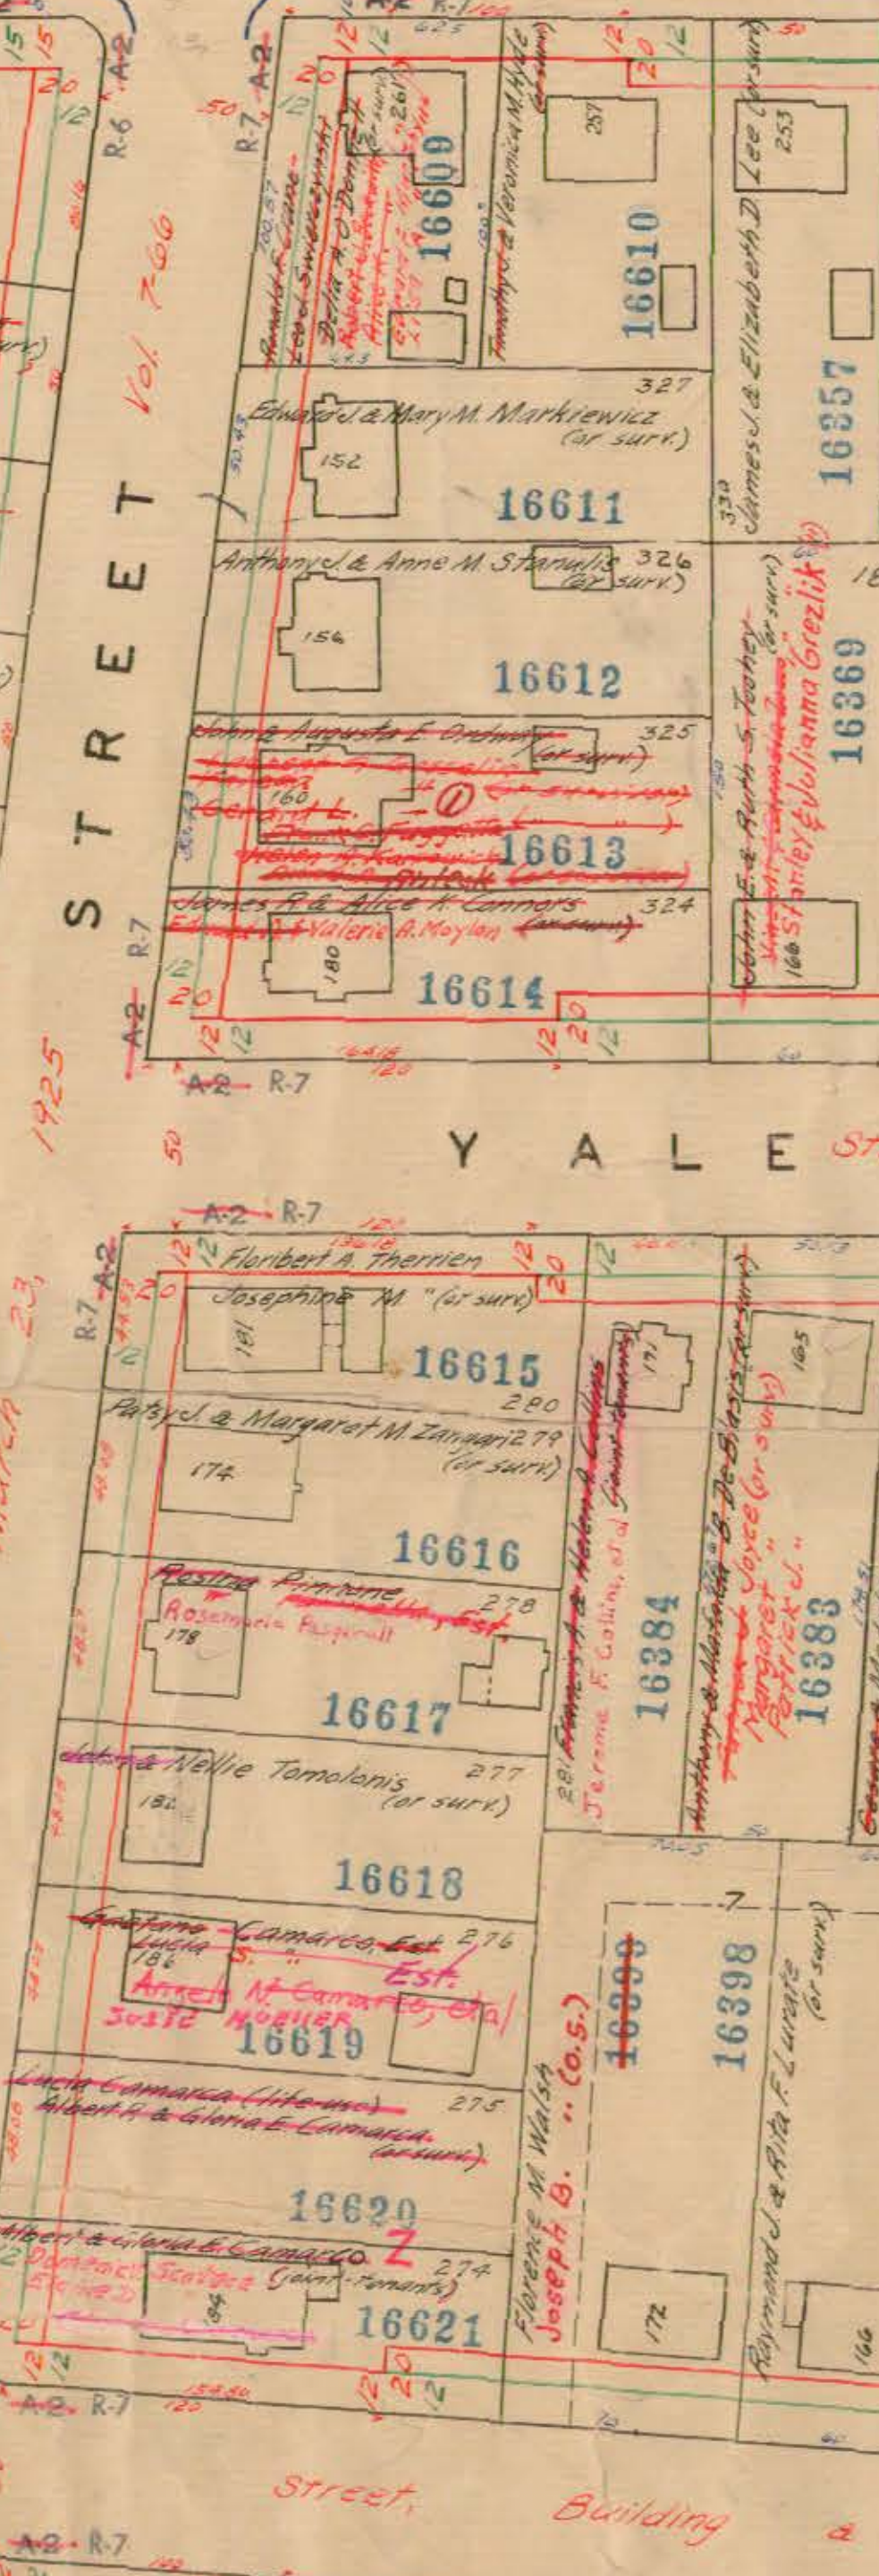
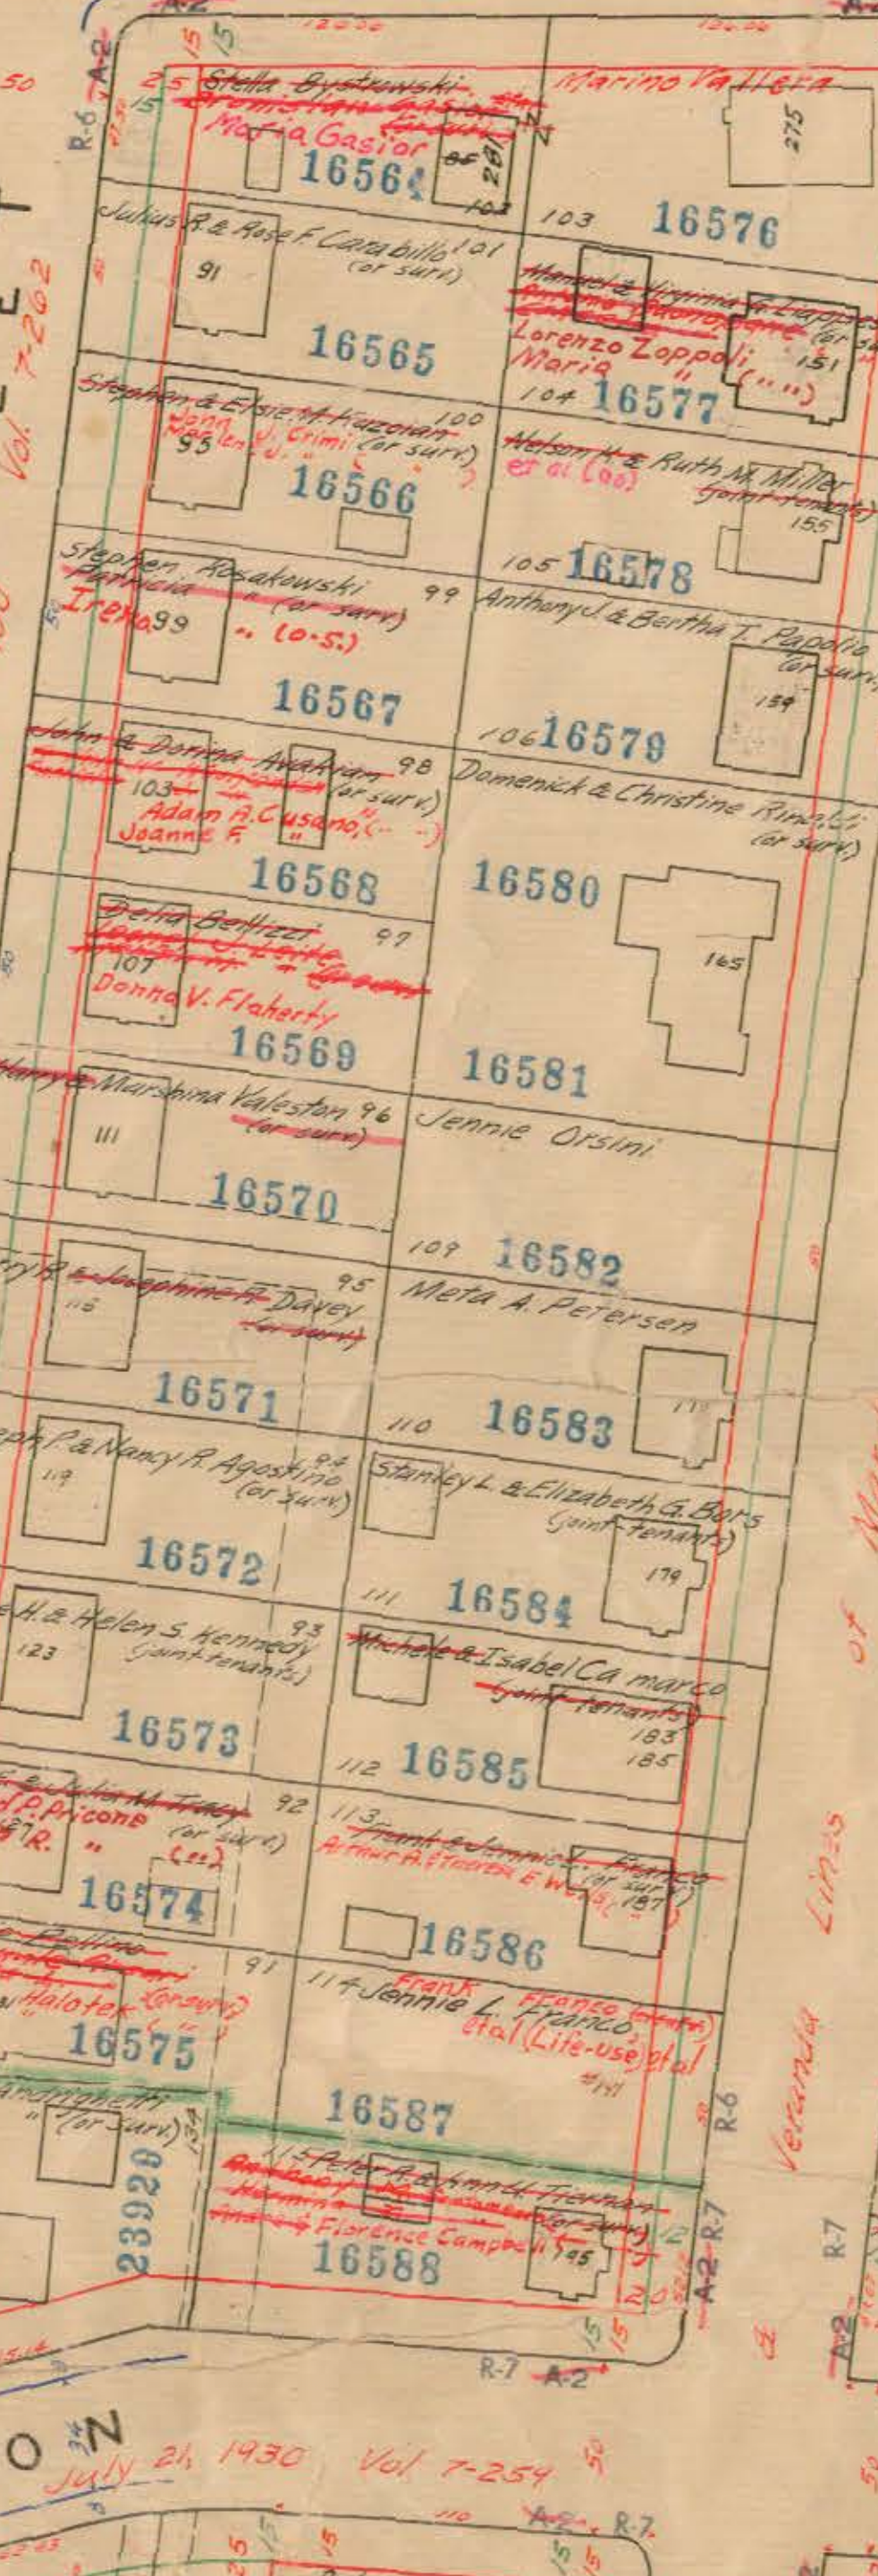


PRINCETON STREET

STREET Building & Veranda Lines of March 23, 1925

Vol 7-65

HILLSIDE

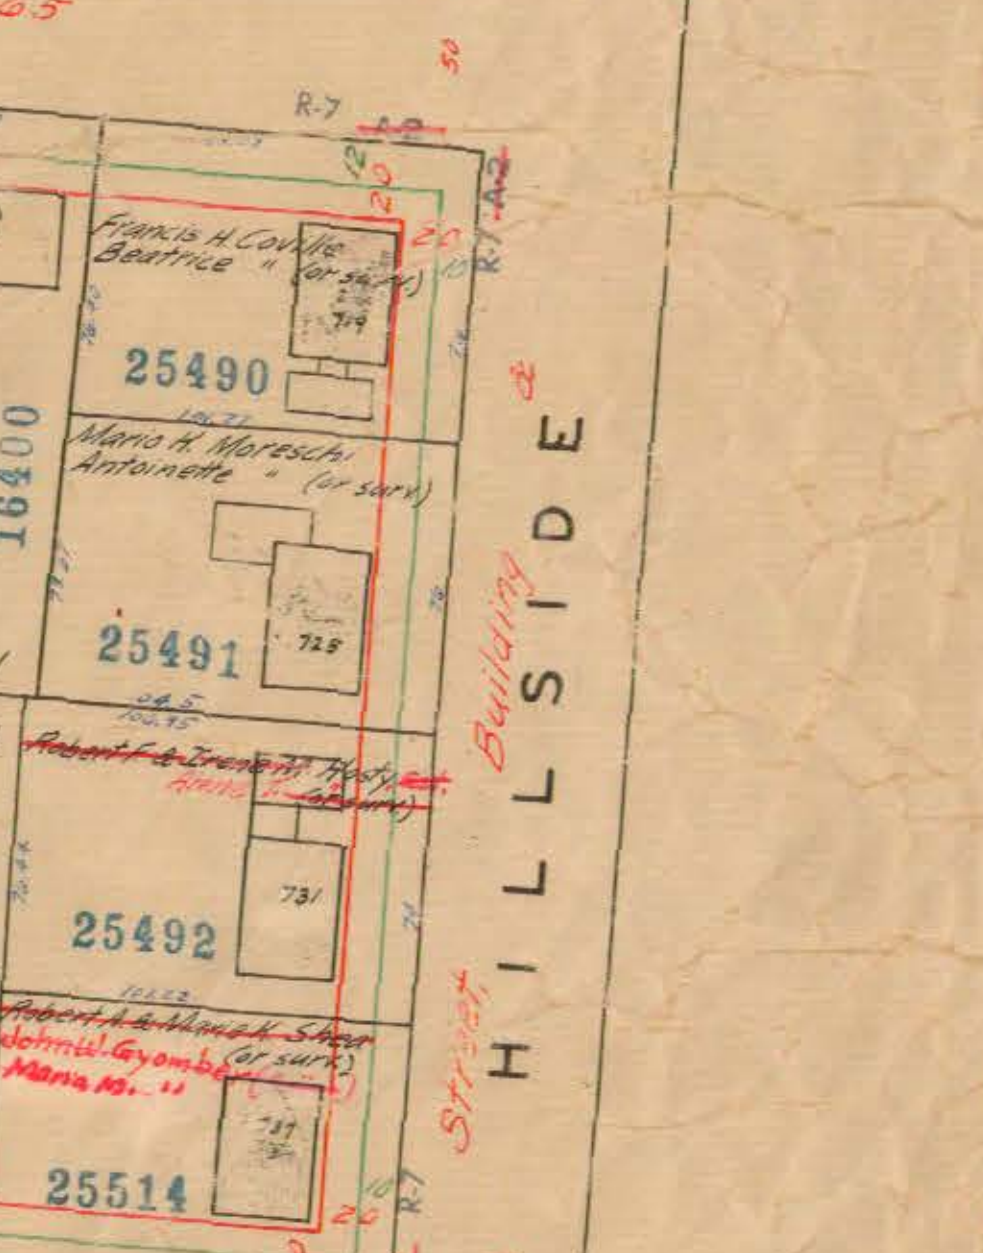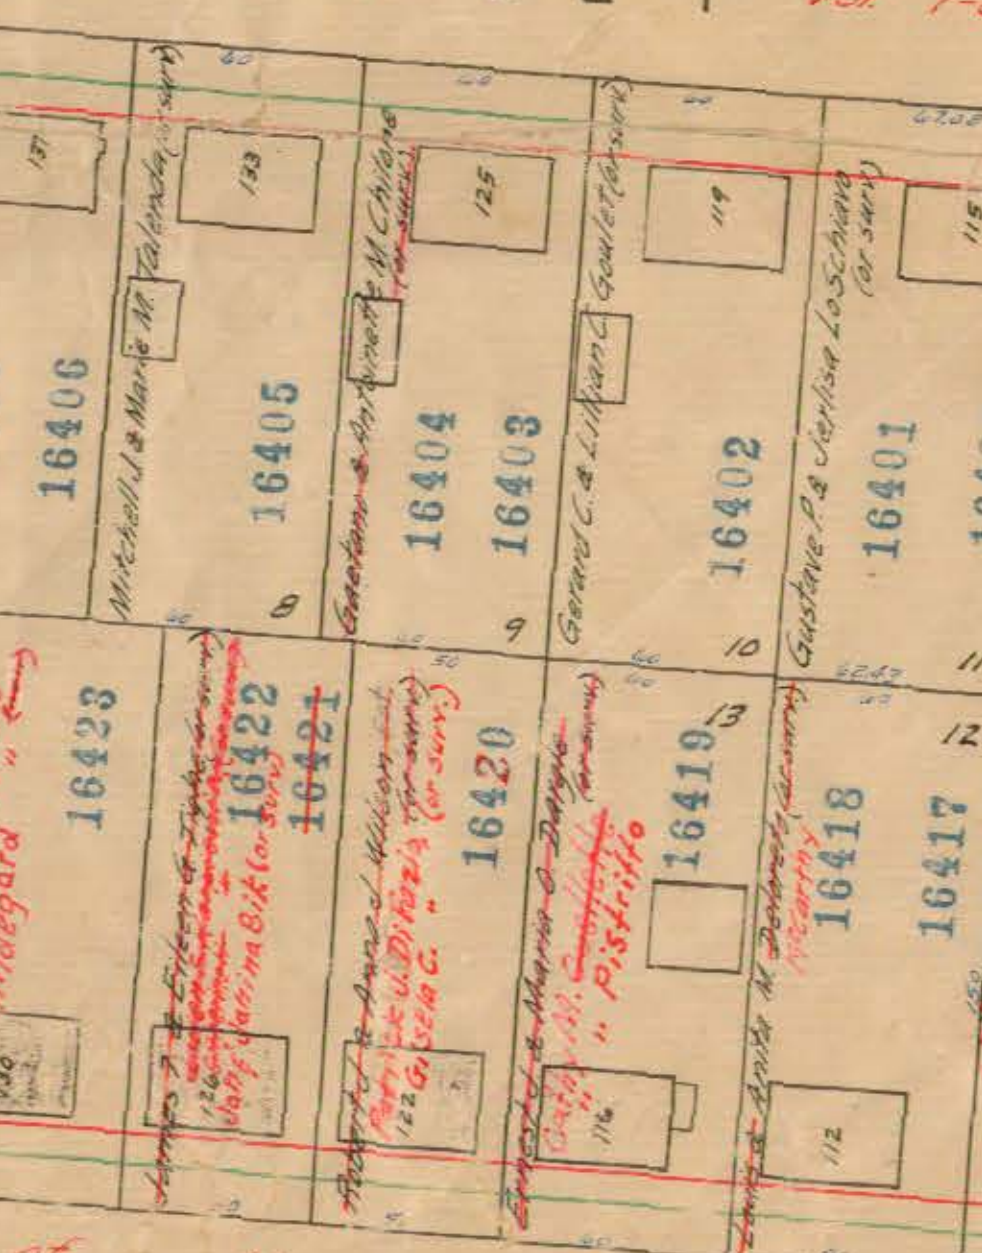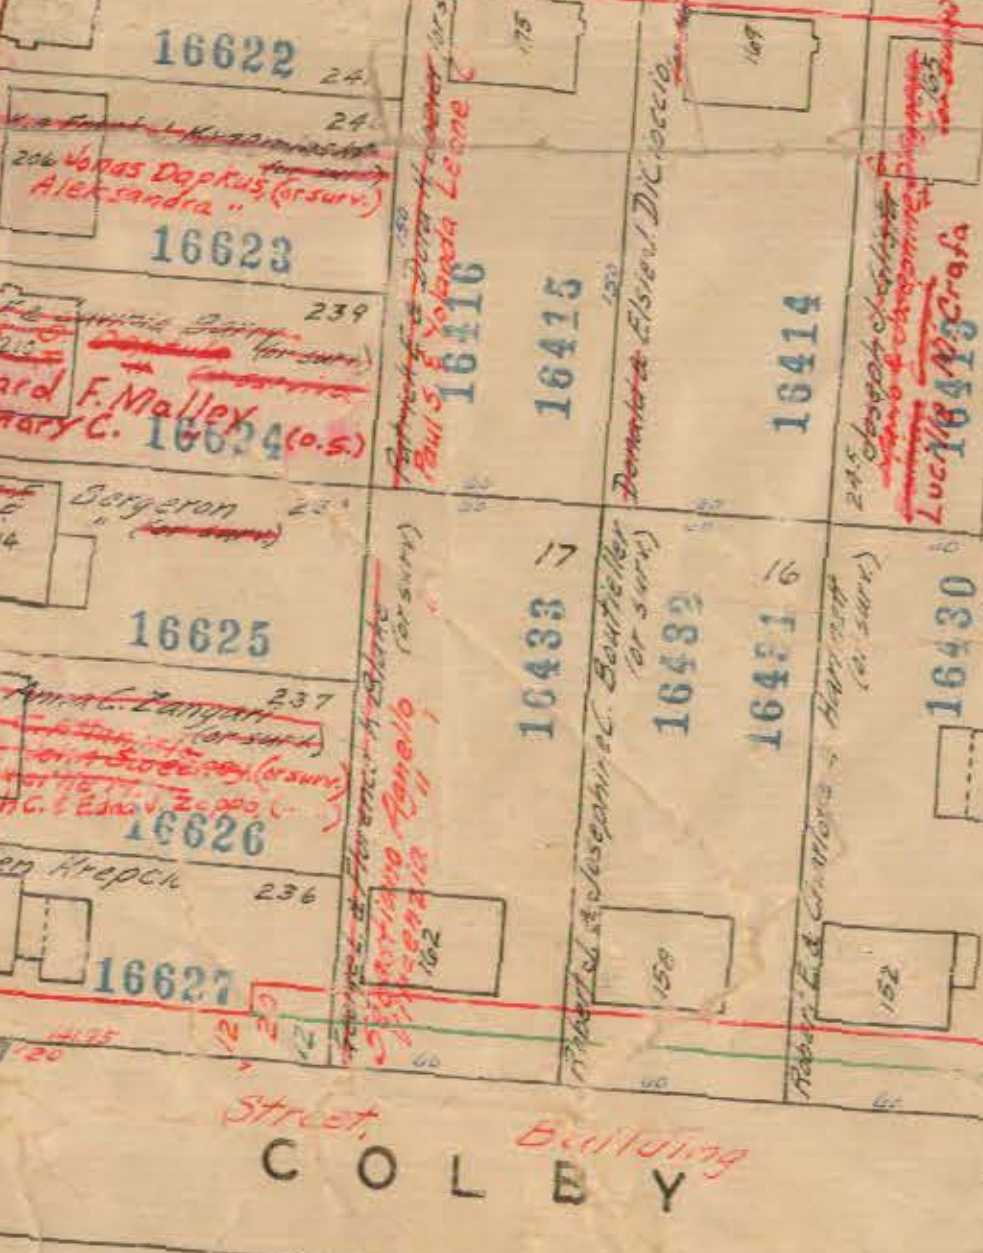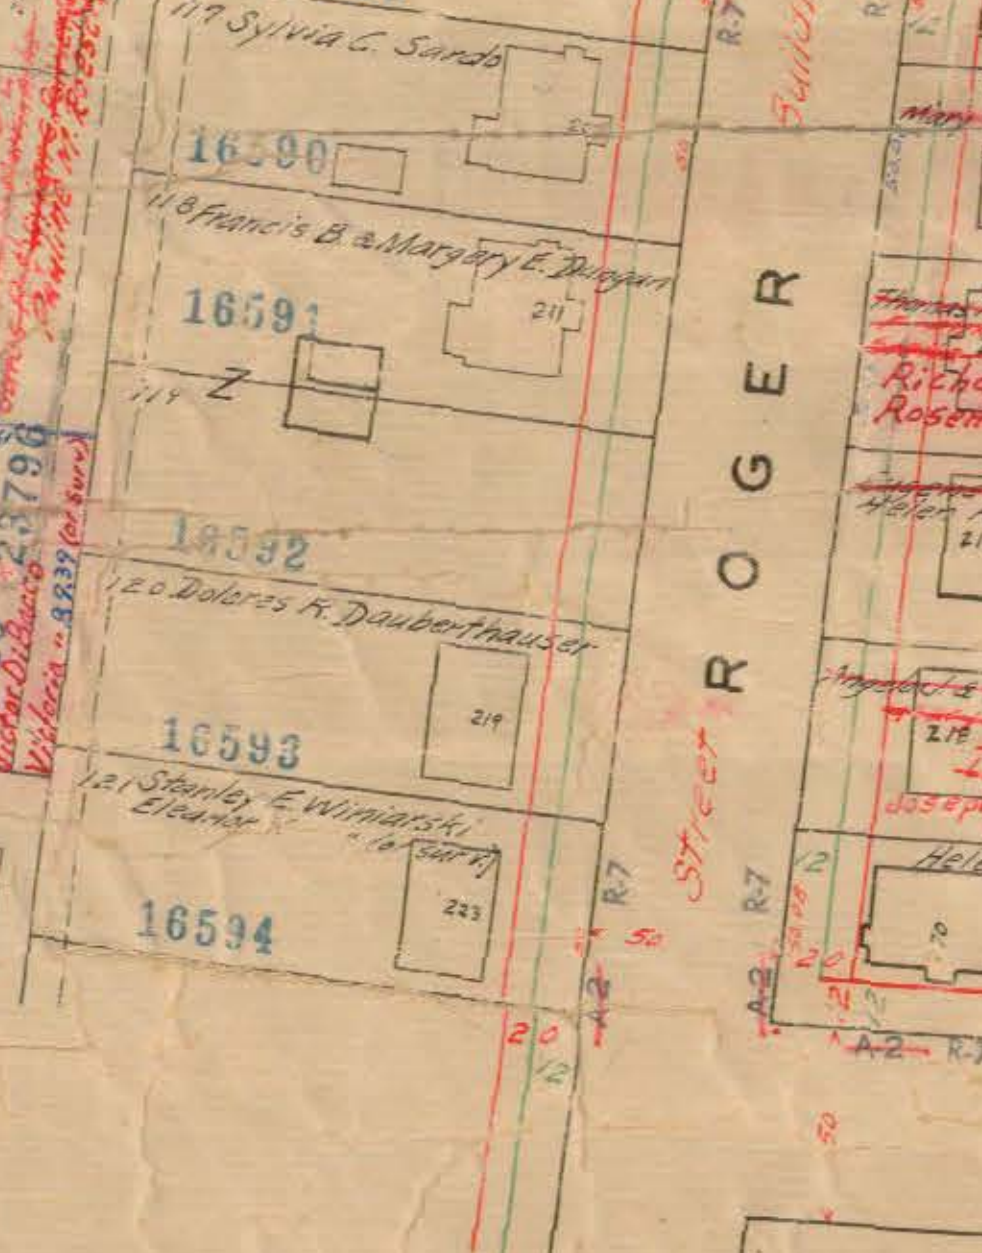

© Hermine M. De Loureiro
Lucilia
(O.S.)

File: 16613
Sebastiano Zappulla
Giuseppa
(O.S.)

See Sheet 200